FHWA REGION NO.	STATE	PROJECT NO.	YEAR	SHEET NO.	TOTAL SHEETS
7	KANSAS	54-87 K-6657-01	2002	15a	1122

DATE	BY	
		REFERENCES NOTED
		REFERENCES CHECKED

DSNR: WDH OPER: JGP SCALE:
I:/1997/97362/As-Builts/dgn's/V8_Files_With_Rasters/Sh 015a-Bench_Marks.dgn Last Rev: 8-17-07 By: gdr

PROJECT BENCHMARK (BM) LOCATION PLAN

WEST KELLOGG FREEWAY – MAIZE & TYLER ROAD INTERCHANGES PROJECT
CITY OF WICHITA PROJECT NUMBER: 472 – 83533
K.D.O.T. PROJECT NUMBER: 54- 87 K 6657 – 01

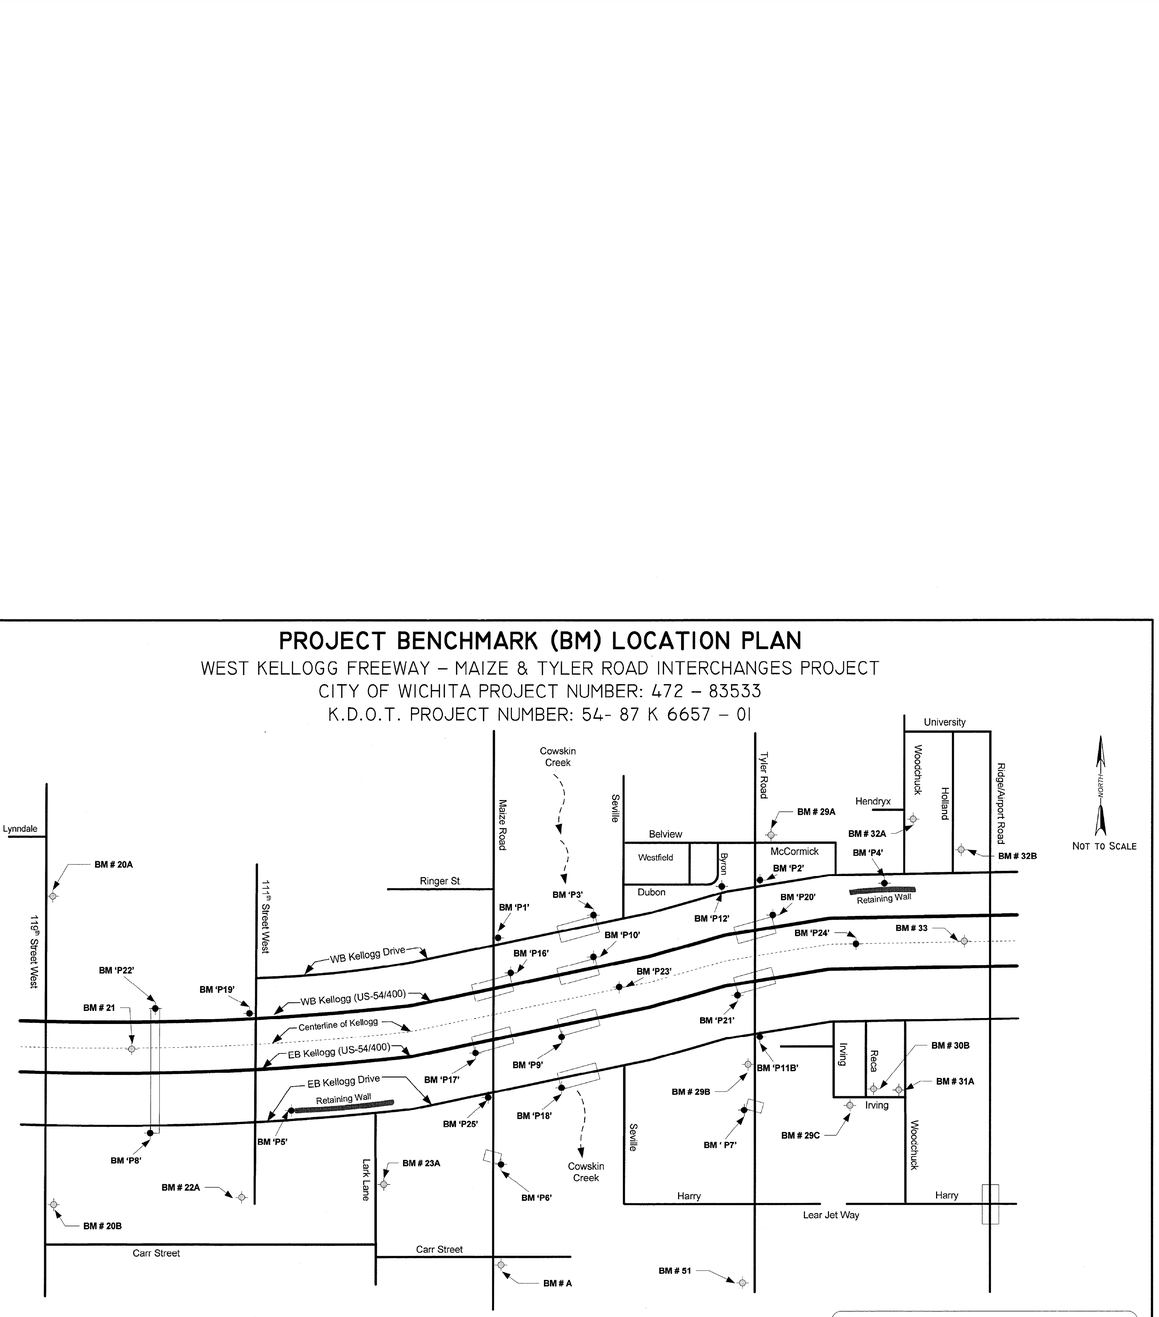

LEGEND

- BM 'PX' = New City of Wichita Benchmark.
- BM # 'X' = Surviving Project Benchmark.

Professional Engineering Consultants, P.A.
303 S. TOPEKA - WICHITA, KANSAS 67202 - 316-262-2691 - FAX 316-262-3003
www.pec1.com - designers@pec1.com

PREPARED: OCTOBER 2005

GENERALIZED MAJOR STRUCTURE LOCATIONS
WEST KELLOGG FREEWAY - MAIZE and TYLER ROAD INTERCHANGES

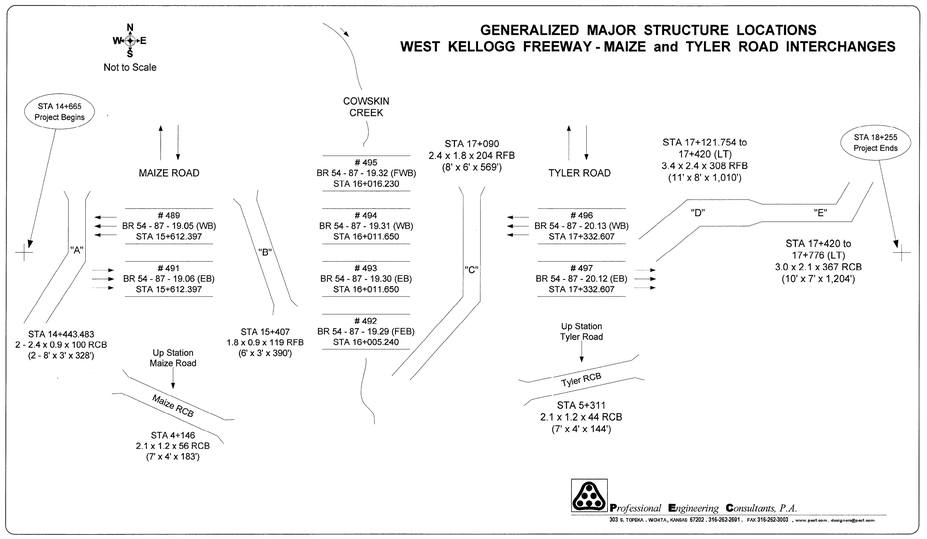

Professional Engineering Consultants, P.A.
303 S. TOPEKA , WICHITA, KANSAS 67202 . 316-262-2691 . FAX 316-262-3003 . www.pec1.com . designers@pec1.com

L:\LORSON\West Kellogg\Drawings\Structure Locations.vsd Rev. 08/02

RECORD DRAWING

No.	Revisions	By	Date
1			

CITY OF WICHITA

GENERAL NOTES

SEDGWICK COUNTY

Professional Engineering Consultants, P.A.
303 S. TOPEKA • WICHITA, KANSAS 67202
316-262-2691 • FAX 316-262-3003

Designed by	WDH	Checked by	JPS
Drawn by	JGP	Date April, 2002	Job No. 97362