FHWA REGION NO.	STATE	PROJECT NO.	YEAR	SHEET NO.	TOTAL SHEETS
7	KANSAS	54-87 K-6657-01	2002	25	1122

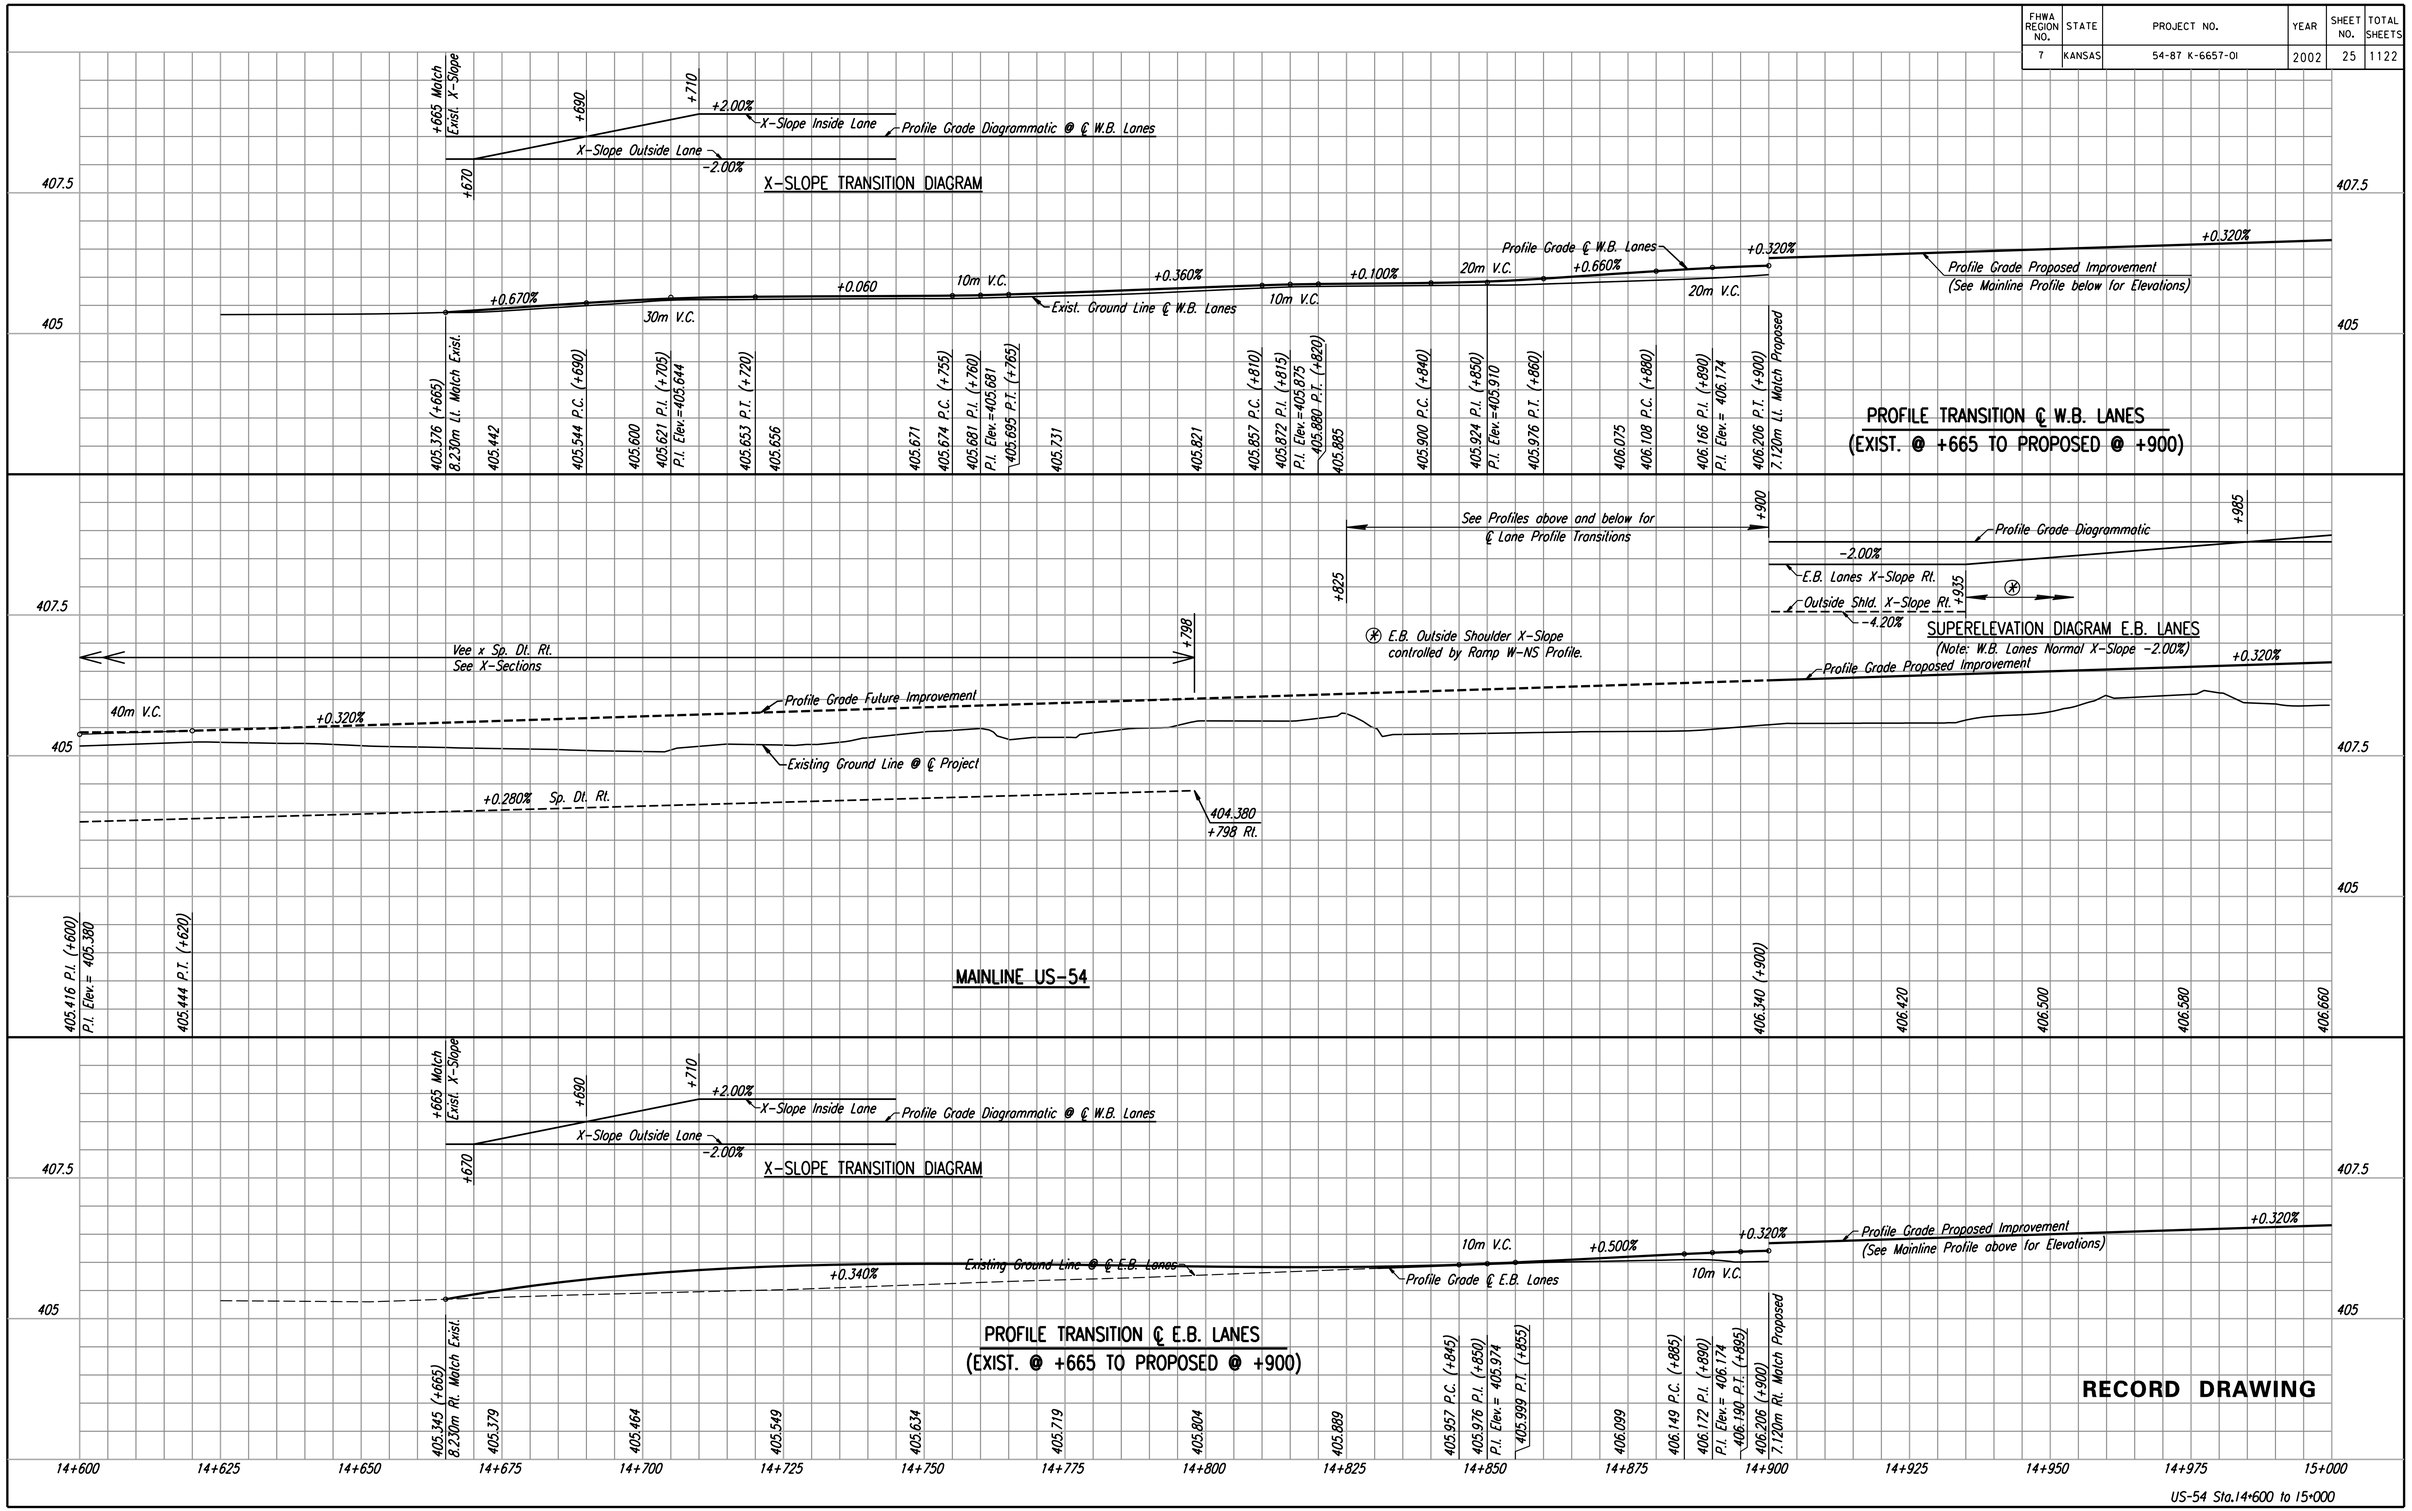

	BY	DATE
REFERENCES NOTED		
REFERENCES CHECKED		

DSNR: WDH OPER: JGP SCALE: 1:500
I:/1997/97362/As-Builts/dgn's/Sh_025-pr146.dgn Last Rev: 8-2-07 By: gdr