STATE	PROJECT NO.	YEAR	SHEET NO.	TOTAL SHEETS
KANSAS	54-87 K-6657-01	2002	118	1122

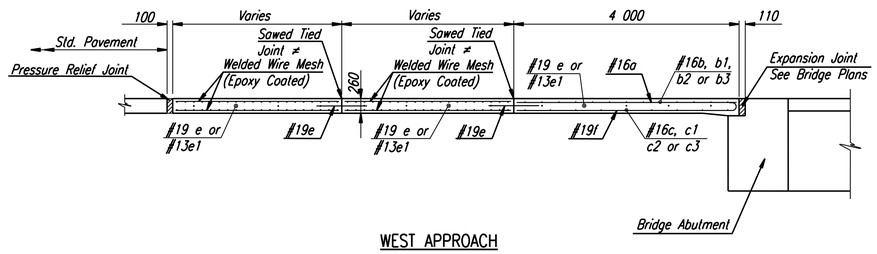

WEST APPROACH

SECTION A–A

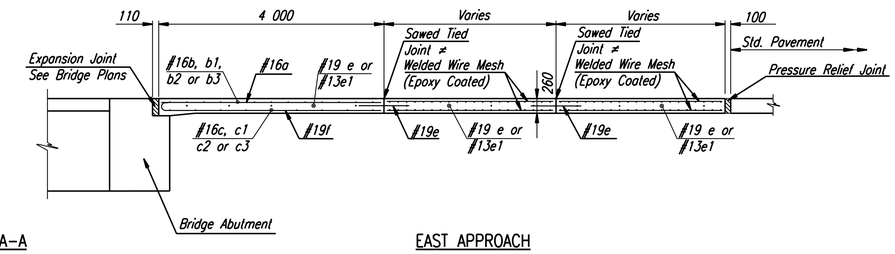

EAST APPROACH

≠ The Contractor has the option of substituting a Tied Keyed Construction Joint for the Sawed Tied Joint shown.

LONGITUDINAL SECTIONS

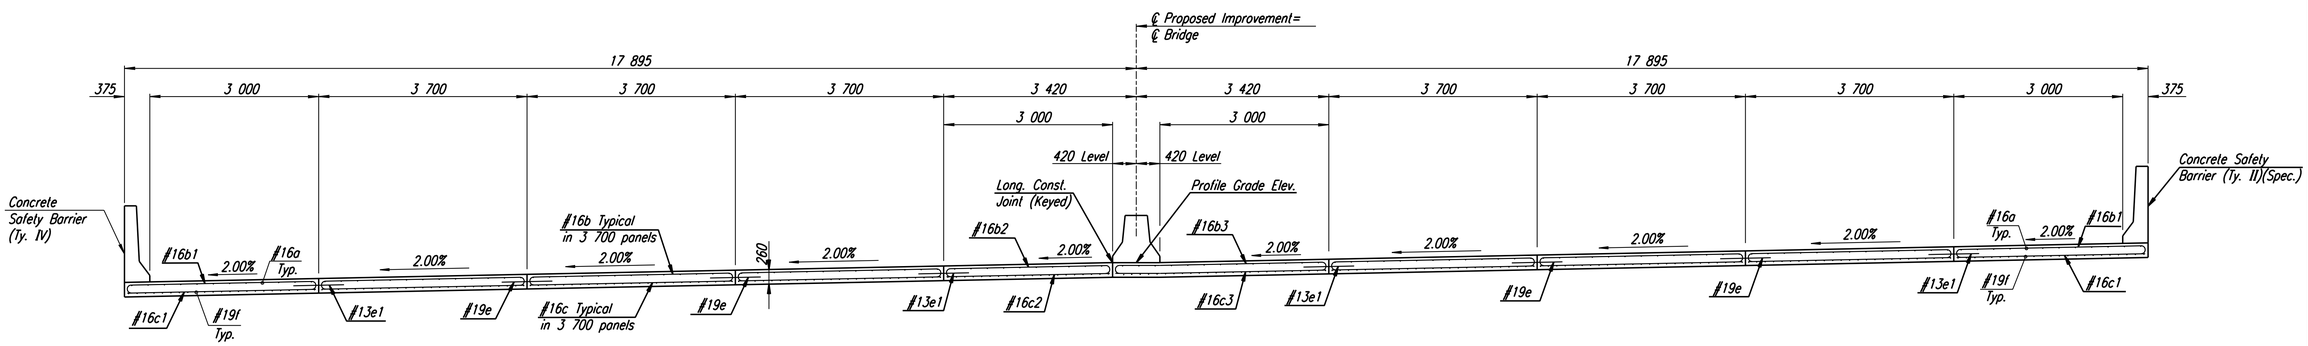

SECTION B–B

TRANSVERSE SECTION

For Concrete Safety Barrier reinforcing details, see Sh. Nos. 228–230
Concrete Safety Barrier shall be reinforced through the entire length of the approach pavement.

RECORD DRAWING

No.	Revisions	By	Date
1			

CITY OF WICHITA

CONCRETE BRIDGE APPROACH PAVEMENT
E.B. & W.B. US-54 OVER MAIZE ROAD

SEDGWICK COUNTY

Professional Engineering Consultants, P.A.
303 S. TOPEKA • WICHITA, KANSAS 67202
316-262-2691 • FAX 316-262-3003

Designed by	WDH	Checked by	
Drawn by	JGP	Date April, 2002	Job No. 97362

DATE	BY	
	REFERENCES NOTED	
	REFERENCES CHECKED	

DSN/R: OPER: JGP SCALE: 1:50
I:/1997/97362/As-Builts/dgn's/Sh 118-ApprSlab-maizesect.dgn Last Rev: 8-14-07 By: gdr