STATE	PROJECT NO.	YEAR	SHEET NO.	TOTAL SHEETS
KANSAS	54-87 K-6657-01	2002	245	1122

DATE	BY	
		REFERENCES NOTED
		REFERENCES CHECKED

SCALE 1:200

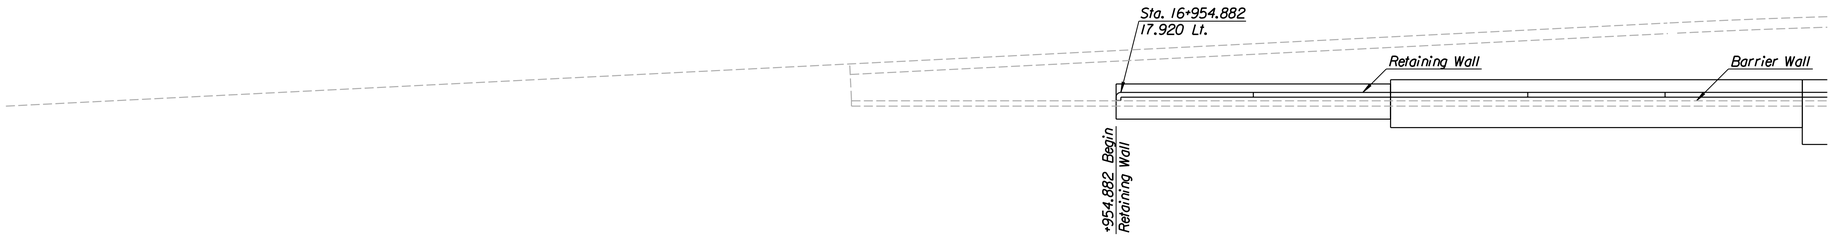

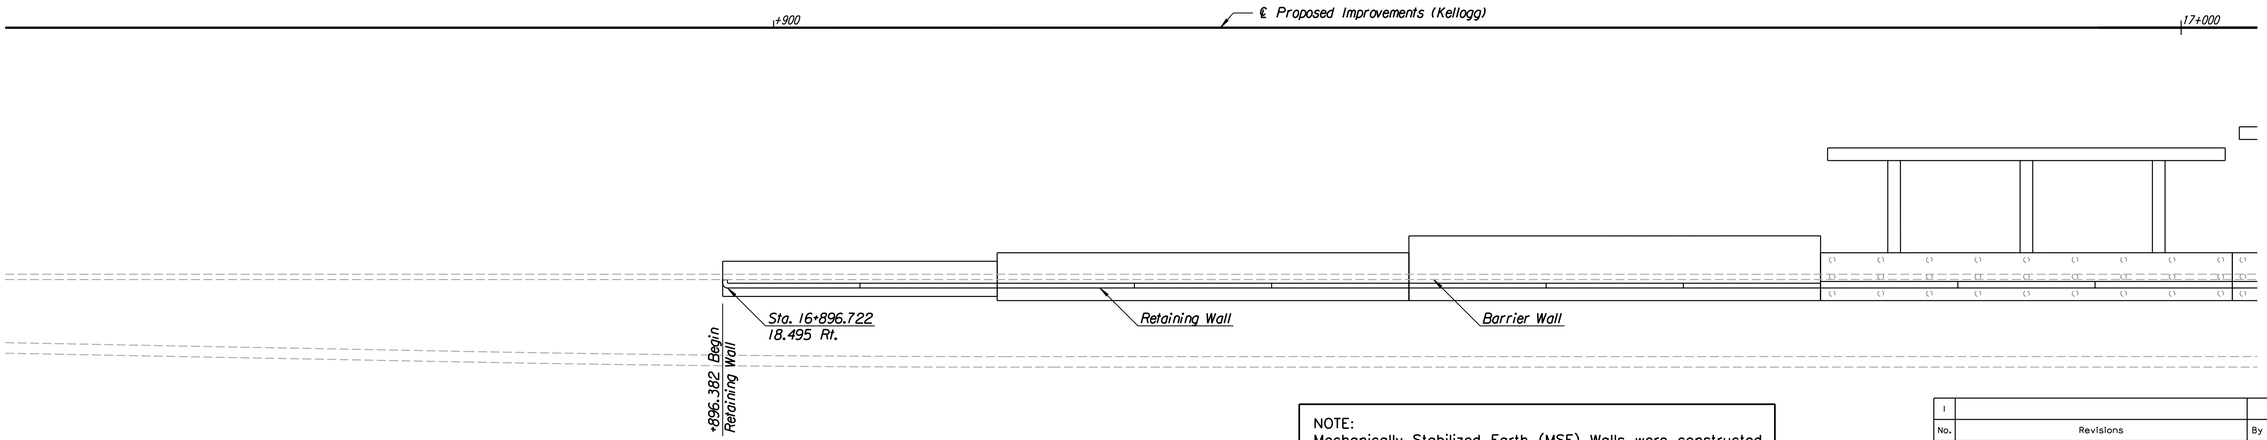

PLAN

NOTE:
Mechanically Stabilized Earth (MSE) Walls were constructed in lieu of Cast-in-Place Retaining Walls.
See Submittal No.'s 21.1, 21.1.A, 21.2.A, 21.2.B, 21.2.C, 21.3.A,34.1.A, 34.1.B, 34.2.A, 34.3.A and 34.3.
Also see Special Provision 90M-110-R3.

RECORD DRAWING

No.	Revisions	By	Date
1			

CITY OF WICHITA

KELLOGG
CAST IN PLACE RETAINING WALL
STA. 16+845 to STA. 17+005

SEDGWICK COUNTY

Professional Engineering Consultants, P.A.
303 S. TOPEKA • WICHITA, KANSAS 67202
316-262-2691 • FAX 316-262-3003

Designed by	PDF	Checked by	RAS	
Drawn by	DRP	Date April, 2002	Job No.	97362

DSNR: PDF OPER: DRP SCALE: 1:200
I:/1997/97362/As-Builts/dgn's/Vol 2/Sh 245-plantwall6.dgn Last Rev: 8-21-07 By: gdr