STATE	PROJECT NO.	YEAR	SHEET NO.	TOTAL SHEETS
KANSAS	54-87 K-6657-01	2002	559	1122

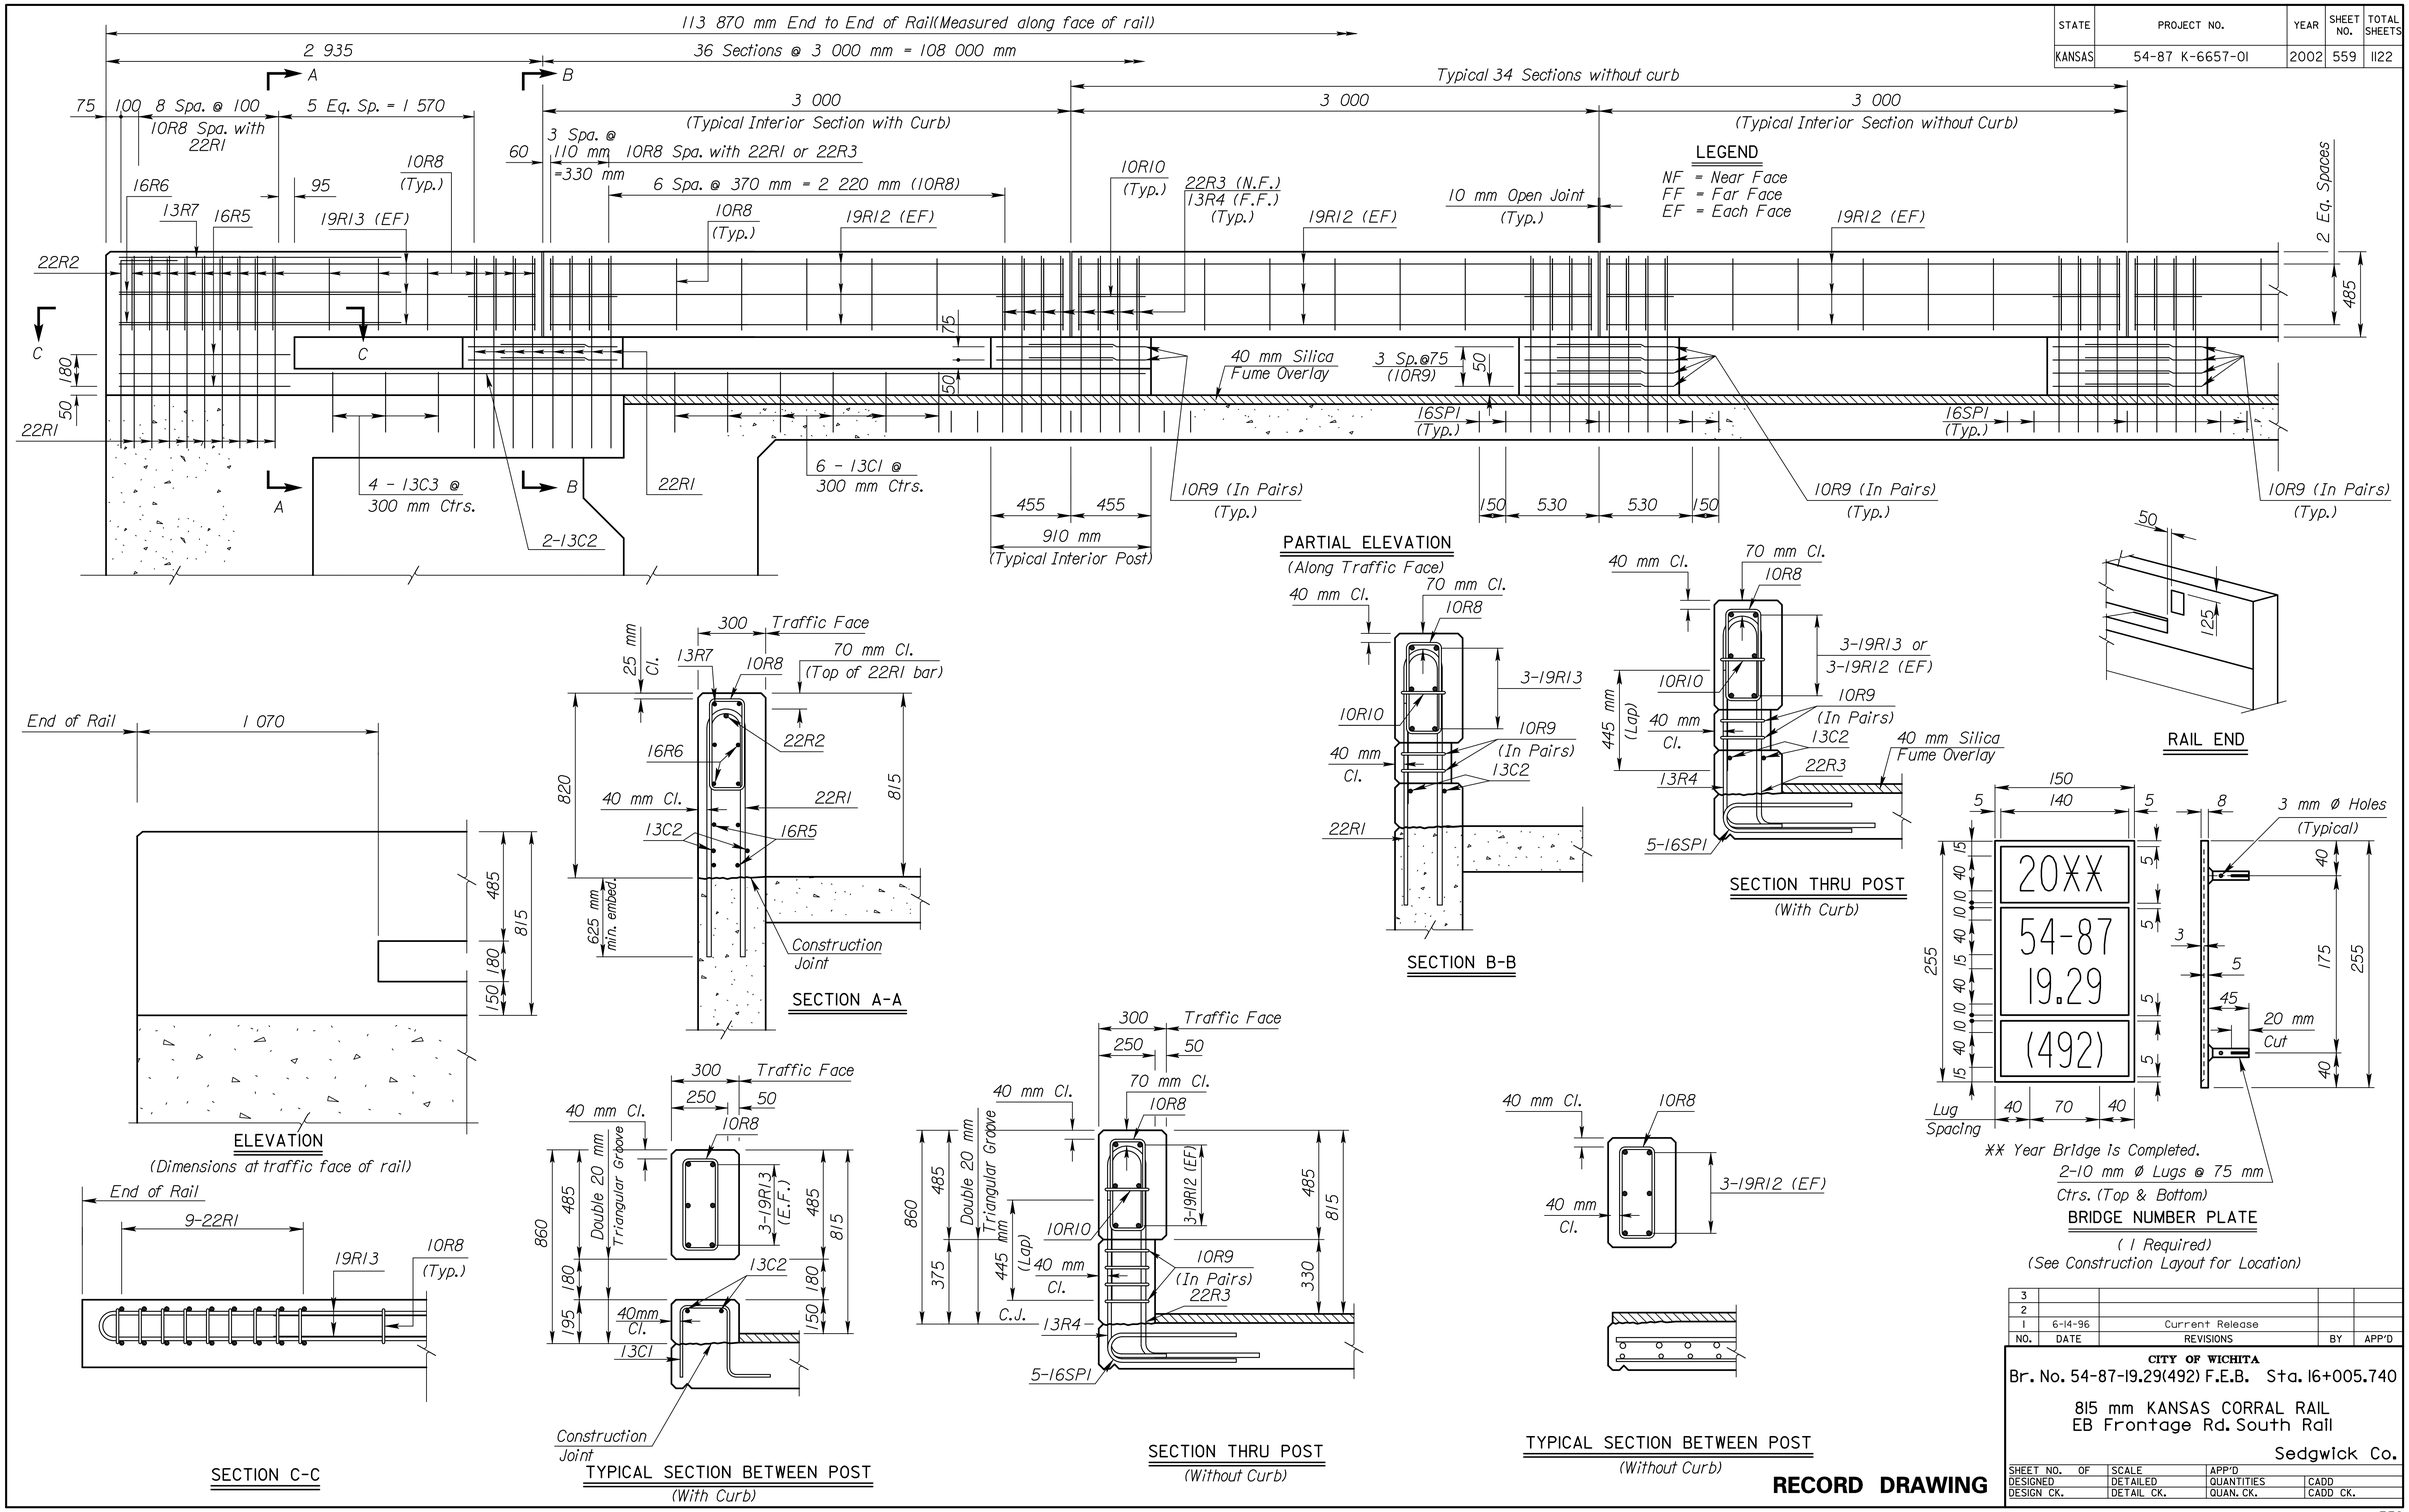

NO.	DATE	REVISIONS	BY	APP'D
3				
2				
1	6-14-96	Current Release		

CITY OF WICHITA

Br. No. 54-87-19.29(492) F.E.B. Sta. 16+005.740

815 mm KANSAS CORRAL RAIL
EB Frontage Rd. South Rail

Sedgwick Co.

SHEET NO. OF	SCALE	APP'D	
DESIGNED	DETAILED	QUANTITIES	CADD
DESIGN CK.	DETAIL CK.	QUAN. CK.	CADD CK.

RECORD DRAWING