FHWA REGION NO.	STATE	PROJECT NO.	YEAR	SHEET NO.	TOTAL SHEETS
7	KANSAS	54-87 K-6657-01	2002	630	1122

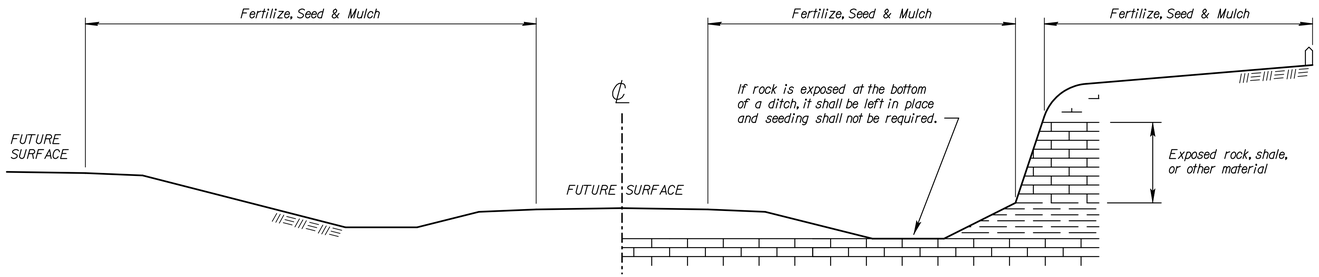

RAMP CUT SECTION

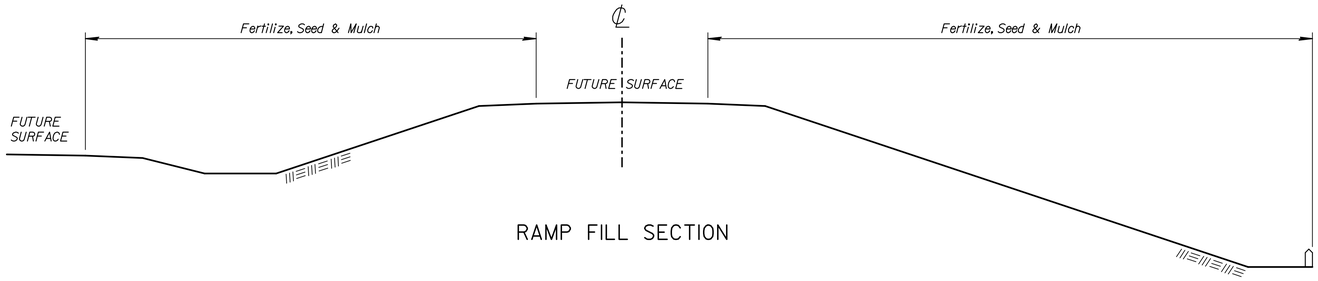

RAMP FILL SECTION

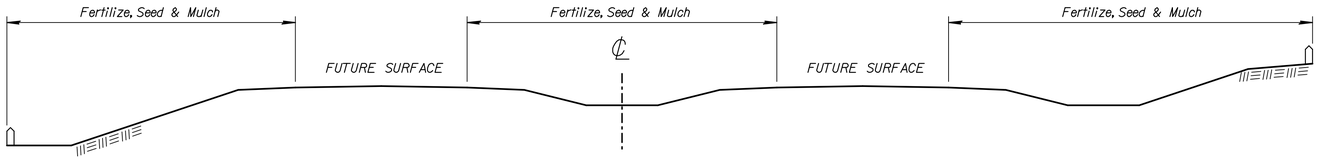

FILL SECTION CUT SECTION

TYPICAL SECTION -- DUAL PAVEMENT

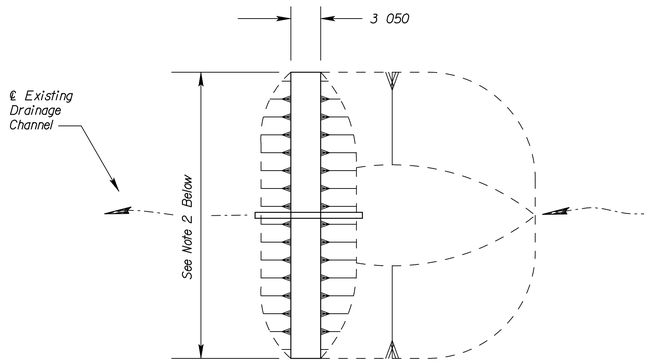

PLAN

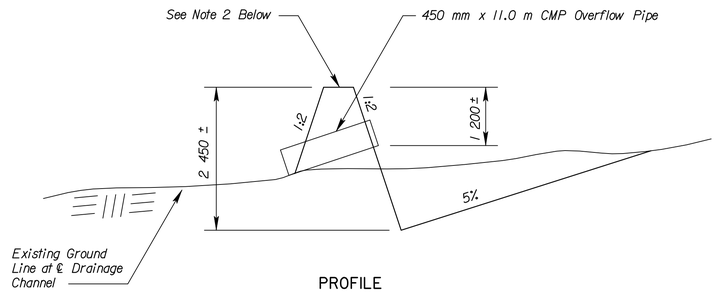

PROFILE

TEMPORARY SEDIMENT BASIN

ADDENDUM NO. 2

5. All areas on the plans to receive permanent seeding shall be mulched. Material and application rates shall be in accordance with the requirements for temporary seeding on Sheet No. 630. The quantity of 18 hectares of mulch shown on Sheet No. 872 is for permanent seeding only.

NOTES:

1) Temporary Sediment Basins shall be constructed at locations as directed by the Engineer. All work and materials necessary for the construction of Temporary Sediment Basins shall be paid for as the bid item "Temporary Sediment Basin". The 450 mm x 11.0 m overflow pipe will be SUBSIDIARY to the bid item "Temporary Sediment Basin". The Temporary Sediment Basins shall be removed by KDOT District forces after seeding has been established if desired by the respective land owners.

2) Lengths and top elevations shall be determined in the field by the Engineer.

3) All dimensions are approximate.

GENERAL: The entire disturbed area, excepting the paved or surfaced areas, steep rocky slopes and areas of undisturbed native sod or other desirable vegetation shall be fertilized (limed when required), seeded, and mulched. Soil preparation shall conform to the Standard Specifications.

Temporary seeding shall be done during any time of the year that the soil can be cultivated. After the temporary seeding has been completed on the entire project, a permanent seeding shall be done by another project during the normal seeding season.

The Contractor will be required to finish areas of excavation, borrow and embankment in accordance with the specifications. Areas that require installation or construction of temporary water pollution control items will be finished in reasonable close conformity to the alignment, grade and cross section shown on the plans or as established by the Engineer.

FERTILIZER: A ratio and application rate that equals or exceeds the required minimum rate per hectare of N, P_2O_5, K_2O listed in Summary of Quantities will be acceptable.

MULCHING: Mulch shall be spread uniformly over all disturbed areas and punched in the soil, unless otherwise noted on the plans. The rate of application per hectare, thickness in place, for the various mulching materials are as follows:

Prairie Hay	3,900 - 5,000	Kilograms per Hectare	=	40mm loose depth spread uniformly over hectare.
Bromegrass	3,900 - 5,000	Kilograms per Hectare	=	40mm loose depth spread uniformly over hectare.
~~Wheat or Oats Straw~~	~~3,400 - 4,500~~	~~Kilograms per Hectare~~	~~=~~	~~80mm loose depth spread uniformly over hectare.~~
Wood Chips	9,000 - 11,200	Kilograms per Hectare	=	25-50mm loose depth spread uniformly over hectare.
Wood Fiber	1,700 - 2,200	Kilograms per Hectare	=	loose depth spread uniformly over hectare.

Other vegetative mulches (Acceptable only with the Engineer's concurrance).

The above rates are a guide. It will be at the discretion of the Engineer to determine what rate is sufficient for adequate protection of newly seeded areas.

The amount of mulch in the bid quantities is estimated. The total mulch required shall be determined in the field. The bid item for mulching shall be paid for by one of the following ways: A) Plan quantity as shown on Summary of Quantities, Seeding Sheet or Water Pollution Control Sheet, B) Slope measurement as measured in field, or C) Drill measurement less 5% as measured at the time of seeding.

SUMMARY OF SEEDING QUANTITIES: PROJECTS OF 2 HA. OR MORE

P.L.S. RATE/ HECTARE	HECTARES	BID ITEM	QUANTITY	UNIT
150	~~18~~ 12	Fertilizer (16 - 20 - 0)	~~2 700~~ 1800	kg
25	18	Ryegrass Seed	~~450~~ 351	kg
		Foxtail Millet Seed	——	kg
		Agricultural Limestone	——	Mg
		Temporary Berm	——	m
		Temporary Ditch Check ①	1 600	m
		Temporary Inlet Sediment Barrier	188	Each
		Temporary Sediment Basin ①	1 000	cu m
		Temporary Slope Barrier ①	~~13 800~~ 11075	m
		Temporary Slope Drain	——	m
		Temporary Stream Crossing	——	Each
		Sediment Removal	~~1 000~~ 100	cu m
		Mulching (Temporary)	~~18~~ 12	ha

SUMMARY OF SEEDING QUANTITIES: PROJECTS LESS THAN 2 HA.

P.L.S. RATE/ HECTARE	HECTARES	BID ITEM	QUANTITY	UNIT
		Fertilizer (* - ** - ***)		kg
		Ryegrass Seed		kg
		Foxtail Millet Seed		kg
		Agricultural Limestone		Mg
		Seeding (TE&PC)		LS
		Temporary Ditch Check		m
		Temporary Slope Barrier (Set)		m
		Sediment Removal (Set)		cu m
		Mulching (Temporary)		ha

① These quantities are estimated and will vary depending on the storm water pollution prevention plan developed and implemented by the Contractor.

* - N = Nitrogen Rate of Application

** - P_2O_5 = Phosphorous Rate of Application

*** - K_2O = Potassium Rate of Application

RECORD DRAWING

NO.	DATE	REVISIONS	BY	APP'D
5				
4				
3				
2				
1	5/10/99	Revised Standard	WCL	RDR

KANSAS DEPARTMENT OF TRANSPORTATION

TEMPORARY EROSION AND POLLUTION CONTROL

LA852A SI

F.H.W.A. APPROVAL		5/20/99	APP'D	Richard D. Ross	
DESIGNED	WCL	DETAILED	WCL	QUANTITIES	TRACED WCL
DESIGN CK.	RDR	DETAIL CK.	RDR	QUAN.CK.	TRACE CK. RDR

DSNR: OPER: JGP SCALE: 1:000
I:/1997/97362/As-Builts/dgn's/Vol_3/Sh 630-KDOT_STD-la852asi.dgn Last Rev: 9-10-07 By: gdr