STATE	PROJECT NO.	YEAR	SHEET NO.	TOTAL SHEETS
KANSAS	54-87 K-6657-01	2002	510	1122

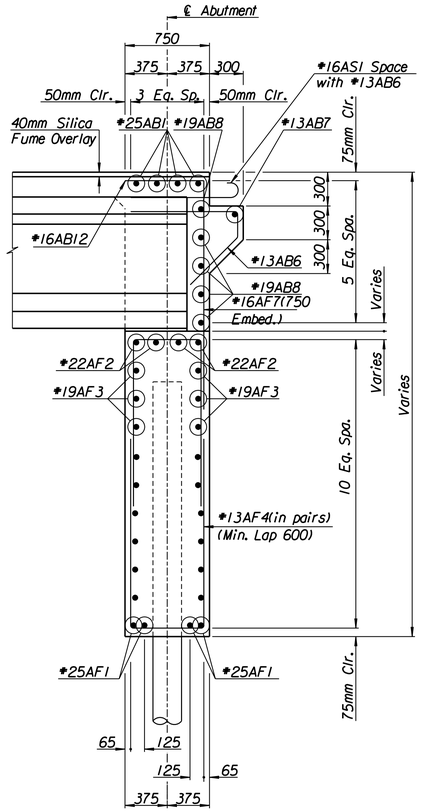

SECTION A-A

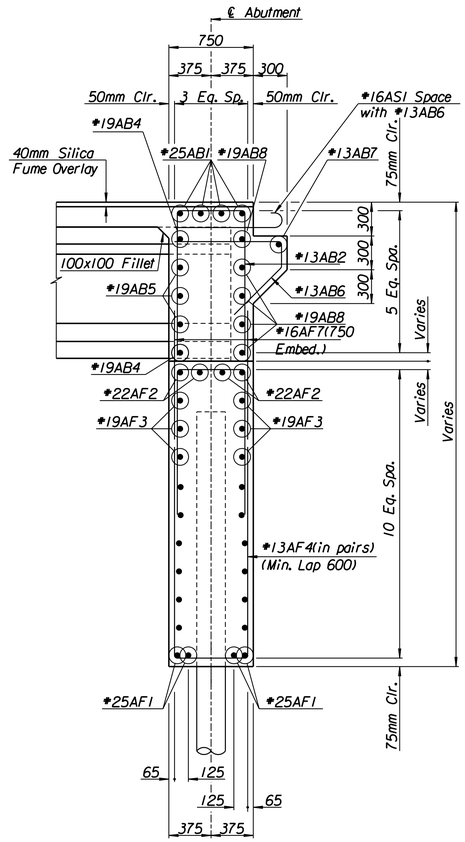

SECTION B-B

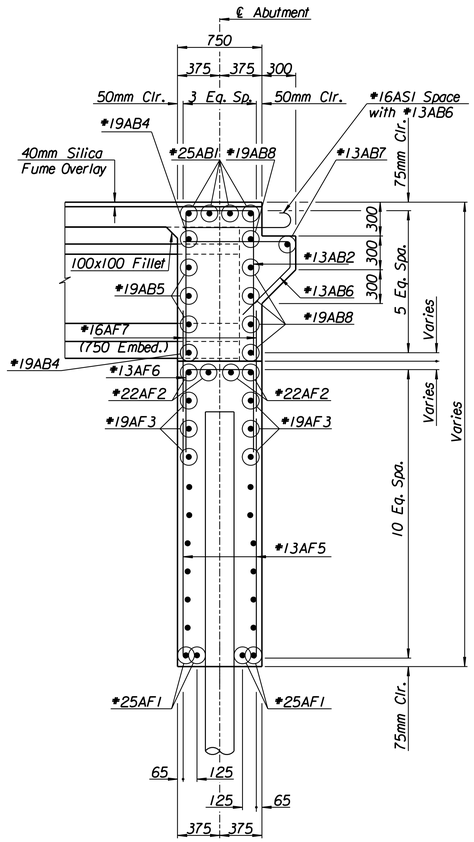

SECTION C-C

(See Framing Plan for Beam Embedment)

RECORD DRAWING

No.	Revisions	By	Date

CITY OF WICHITA
BR. NO. 54-87-19.30(493) E.B. STA. 16+011.650
WEST KELLOGG EASTBOUND MAINLINE
OVER COWSKIN CREEK
ABUTMENT NO. 1 DETAILS
SEDGWICK COUNTY

Professional Engineering Consultants, P.A.
303 S. TOPEKA - WICHITA, KANSAS 67202
316-262-2691 - FAX 316-262-3003

Designed by	R.A.S.	Checked by	R.A.S.
Drawn by	R.A.S.	Date	April, 2002
		Job No.	97362

Drawn By: ras
Plotted By: gdr Sept. 07
I:/1997/97362/As-Builts/dgn's/Vol_3/Sh 510-abmt1ebml.dgn Last Rev: 9-4-07 By: gdr