FHWA REGION NO.	STATE	PROJECT NO.	YEAR	SHEET NO.	TOTAL SHEETS
7	KANSAS	54-87 K-6657-01	2002	681a	1122

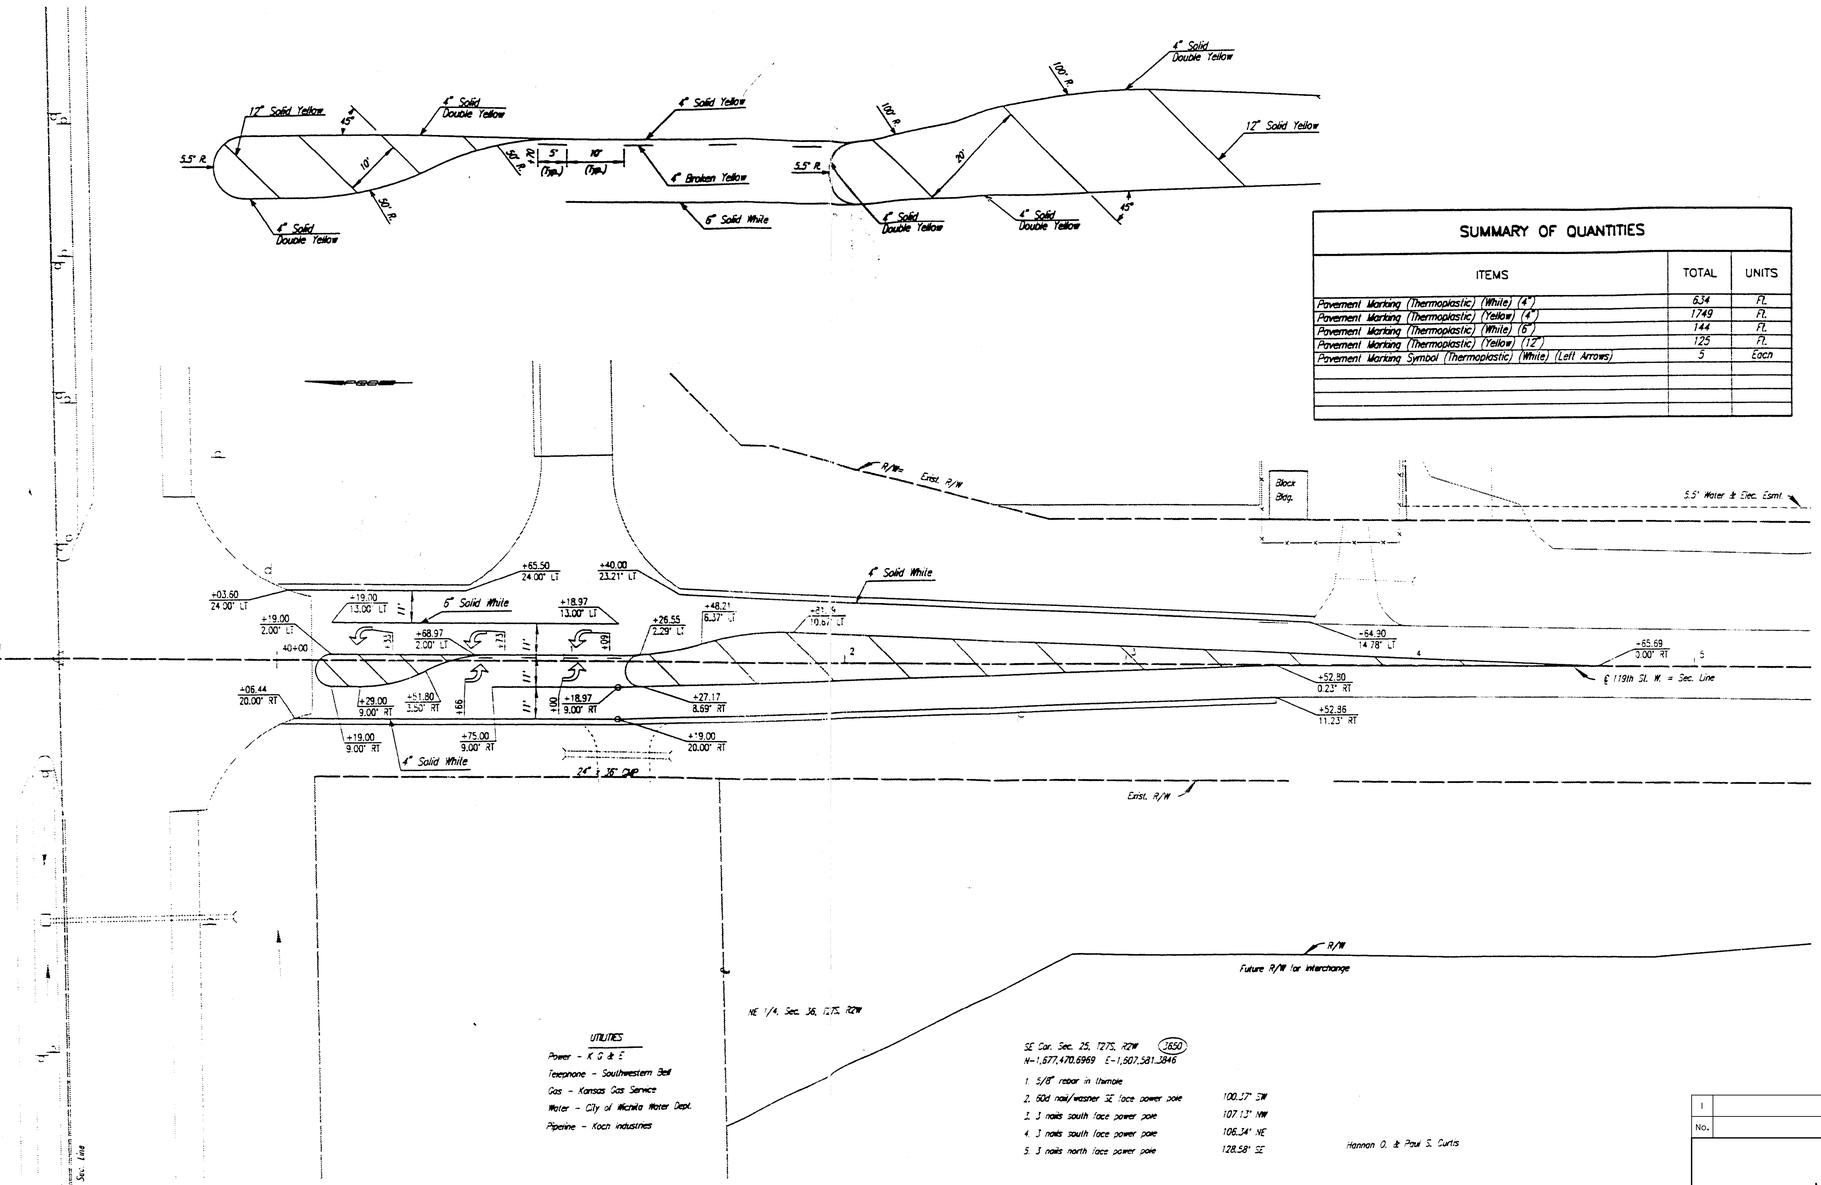

SUMMARY OF QUANTITIES

ITEMS	TOTAL	UNITS
Pavement Marking (Thermoplastic) (White) (4")	634	Ft.
Pavement Marking (Thermoplastic) (Yellow) (4")	1749	Ft.
Pavement Marking (Thermoplastic) (White) (6")	144	Ft.
Pavement Marking (Thermoplastic) (Yellow) (12")	125	Ft.
Pavement Marking Symbol (Thermoplastic) (White) (Left Arrows)	5	Each

RECORD DRAWING

No.	Revisions	By	Date
1			

CITY OF WICHITA

MARKING PLAN
119TH ST. WEST

SEDGWICK COUNTY

Professional Engineering Consultants, P.A.
303 S. TOPEKA • WICHITA, KANSAS 67202
316-262-2691 • FAX 316-262-3003

Designed by		Checked by	
Drawn by		Date	Job No. 97362

681A

DSNR: WDH OPER: JGP SCALE:
I:/1997/97362/As-Builts/dgn's/Vol 4/V8_Files_With_Rasters/Sh 681a-119thmarksign.dgn Last Rev: 9-21-07 By: gdr