| FHWA REGION NO. | STATE | PROJECT NO. | YEAR | SHEET NO. | TOTAL SHEETS |
|---|---|---|---|---|---|
| 7 | KANSAS | 54-87 K-6657-01 | 2002 | 726 | 1122 |

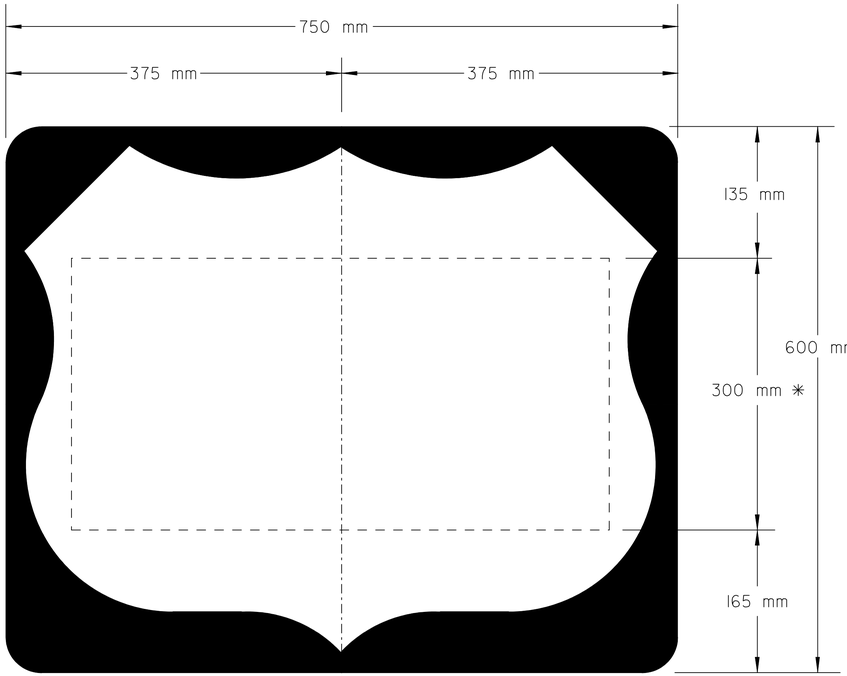


MI-4

0.45 sq m

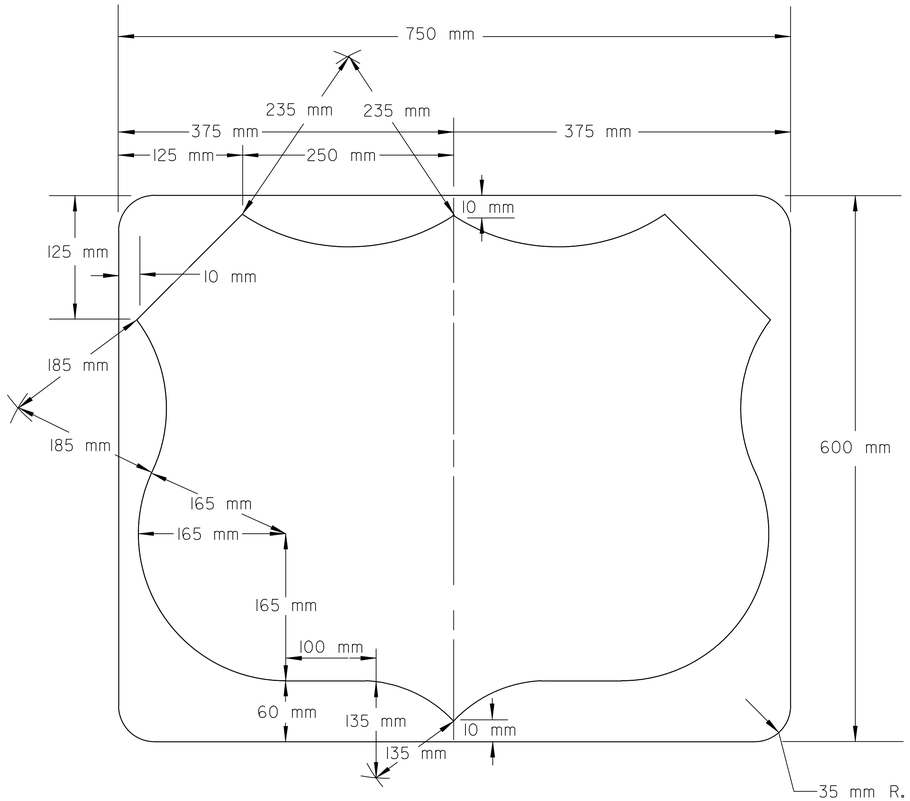


* OPTICALLY SPACE NUMERALS
ABOUT VERTICAL CENTERLINE

| Shield No. | Size (mm) | Digits | Digit Series | | |
|---|---|---|---|---|---|
| MI-4 | 750 X 600 | 400 | D | | |
| | | | | | |

NOTE:
COLOR SPECIFICATIONS (DIRECT SCREEN PROCESS)
SIGN FACE SHALL BE COVERED WITH HIGH PERFORMANCE
WHITE RETROREFLECTIVE SHEETING.
DIGITS AND AREA AROUND SHIELD SHALL BE BLACK PROCESS INK.
SEE FLAT SIGN DETAIL SHEET FOR ALUMINUM ALLOYS
AND THE THICKNESS REQUIRED.
THE TYPE OF ADHESIVE FOR RETROREFLECTIVE SHEETING
SHALL BE HEAT ACTIVATED OR PRESSURE SENSITIVE.

**RECORD DRAWING**

ALL DIMENSIONS ARE IN MILLIMETERS.

| NO. | DATE | REVISION | BY | APP'D |
|---|---|---|---|---|
| 3 | | | | |
| 2 | | | | |
| 1 | 10-28-99 | CHANGED DIMENSIONS | TCP | MPM |

KANSAS DEPARTMENT OF TRANSPORTATION

# DESIGN DETAILS FOR 3 DIGIT US-ROUTE MARKER (INDEPENDENT USE)

TE520SI 9-1-94

| | | | |
|---|---|---|---|
| FHWA APPROVAL | 11-9-99 | APP'D NELDA A. BUCKLEY | |
| DESIGNED KH | DETAILED KH | QUANTITIES | TRACED KH |
| DESIGN CK. | DETAIL CK. | QUAN. CK. | TRACE CK. |

DSNR: OPER: SVB SCALE: I
I:/1997/97362/As-Builts/dgn's/Vol_4/Sh 726-K00T_STD-TE520SI.dgn Last Rev: 10-3-07 By: gdr