FHWA REGION NO.	STATE	PROJECT NO.	YEAR	SHEET NO.	TOTAL SHEETS
7	KANSAS	54-87 K-6657-01	2002	730	1122

SIGN	SIZE (mm)	AREA-(sq m)
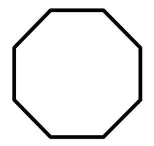 OCTAGON	600 X 600	0.298
	750 X 750	0.466
	900 X 900	0.671
	1200 X 1200	1.193
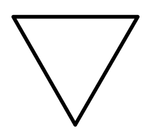 TRIANGLE	750 X 750 X 750	0.244
	900 X 900 X 900	0.351
	1200 X 1200 X 1200	0.624
	1500 X 1500 X 1500	0.974
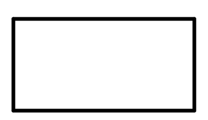 HORIZONTAL RECTANGLE	525 X 375	0.197
	600 X 150	0.090
	600 X 300	0.180
	600 X 450	0.270
	750 X 375	0.280
	750 X 450	0.338
	750 X 600	0.450
	900 X 300	0.270
	900 X 600	0.540
	1200 X 600	0.720
	1200 X 750	0.900
	1500 X 750	1.125

SIGN	SIZE (mm)	AREA-(sq m)
  SQUARE 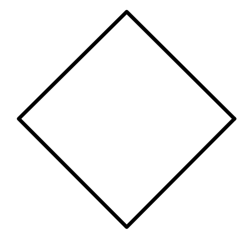 DIAMOND	125 X 125	0.016
	450 X 450	0.203
	600 X 600	0.360
	750 X 750	0.563
	900 X 900	0.810
	1200 X 1200	1.440
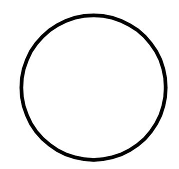 CIRCLE	375 R - 750 Dia.	0.442
	450 R - 900 Dia.	0.636
	600 R - 1200 Dia.	1.131
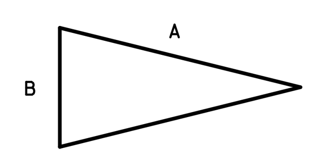 PENNANT	A B	
	1000 750	0.348
	1200 900	0.501
	1600 1200	0.890
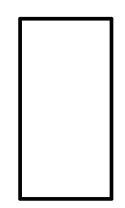 VERTICAL RECTANGLE	75 x 200	0.015
	300 x 450	0.135
	300 x 600	0.180
	300 x 900	0.270
	300 x 1200	0.360
	450 x 600	0.270
	600 x 750	0.450
	750 x 900	0.675
	900 x 1200	1.080

SIGN	SIZE (mm)	AREA-(sq m)
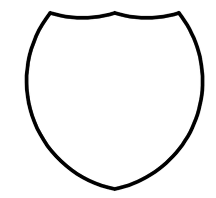 INTERSTATE SHIELD	600 x 600	0.288
	900 x 900	0.650
	1200 x 1200	1.154
	750 x 600	0.452
	1125 x 900	1.004
	1500 x 1200	1.852
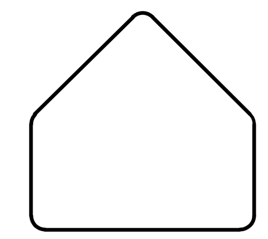 PENTAGON (SCHOOL)	750 x 750	0.422
	900 x 900	0.608

NO.	DATE	REVISION	BY	APP'D
3				
2				
1				

RECORD DRAWING

KANSAS DEPARTMENT OF TRANSPORTATION

AREA OF FLAT SHEET SIGNS

TE585SI 1-25-93

FHWA APPROVAL 1-10-95		APP'D NELDA A BUCKLEY	
DESIGNED	DETAILED KDS	QUANTITIES	TRACED
DESIGN CK.	DETAIL CK.	QUAN. CK.	TRACE CK.

DSNR: OPER: SVB SCALE: 1 Last Rev: 10-3-07 By: gdr
I:/1997/97362/As-Builts/dgn's/Vol_4/Sh 730-KDOT_STD-TE585SI.dgn