FHWA REGION NO.	STATE	PROJECT NO.	YEAR	SHEET NO.	TOTAL SHEETS
7	KANSAS	54-87 K-6657-01	2002	683R2	1122

	BY	DATE
REFERENCES NOTED		
REFERENCES CHECKED		

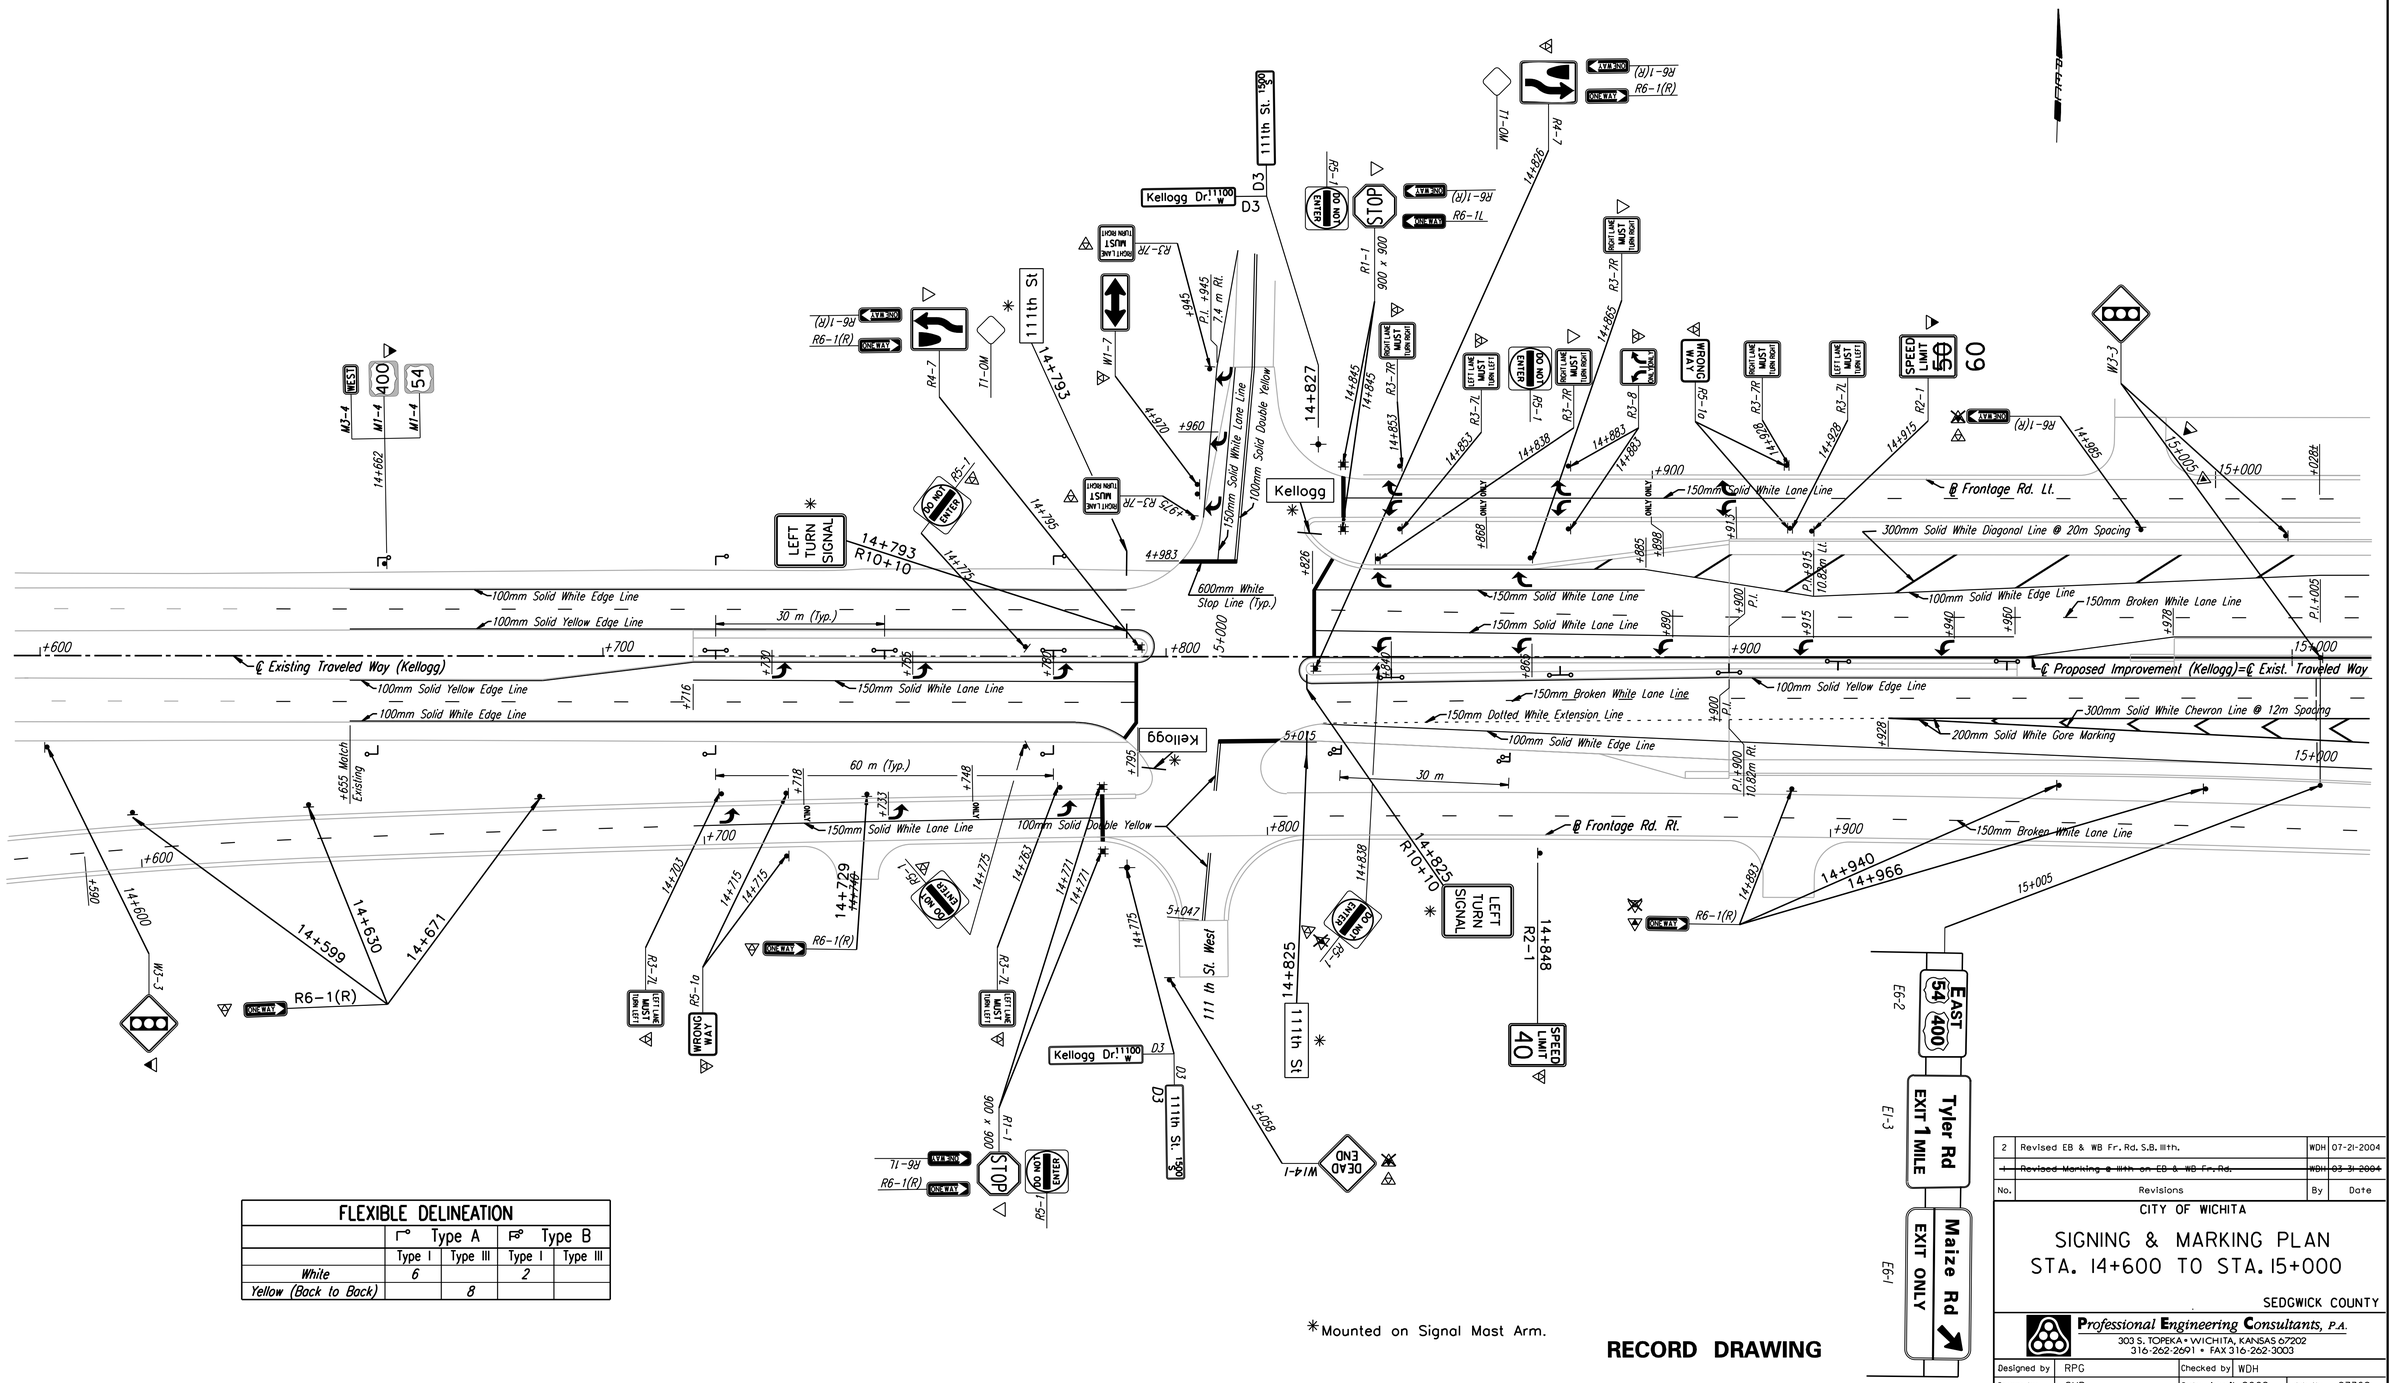

FLEXIBLE DELINEATION				
	Type A		Type B	
	Type I	Type III	Type I	Type III
White	6		2	
Yellow (Back to Back)		8		

*Mounted on Signal Mast Arm.

RECORD DRAWING

No.	Revisions	By	Date
2	Revised EB & WB Fr. Rd. S.B. 111th.	WDH	07-21-2004
~~1~~	~~Revised Marking @ 111th on EB & WB Fr. Rd.~~	~~WDH~~	~~03-31-2004~~

CITY OF WICHITA

SIGNING & MARKING PLAN
STA. 14+600 TO STA. 15+000

SEDGWICK COUNTY

Professional Engineering Consultants, P.A.
303 S. TOPEKA • WICHITA, KANSAS 67202
316-262-2691 • FAX 316-262-3003

Designed by	RPG	Checked by	WDH
Drawn by	SVB	Date April, 2002	Job No. 97362

683R2

DSNR: WDH OPER: JGP SCALE: 1:500
I:/1997/97362/As-Builts/dgn's/Vol_4/Sh 683R2-pl146revised_07_19_04.dgn Last Rev: 9-21-07 By: gdr