FHWA REGION NO.	STATE	PROJECT NO.	YEAR	SHEET NO.	TOTAL SHEETS
7	KANSAS	54-87 K-6657-01	2002	691	1122

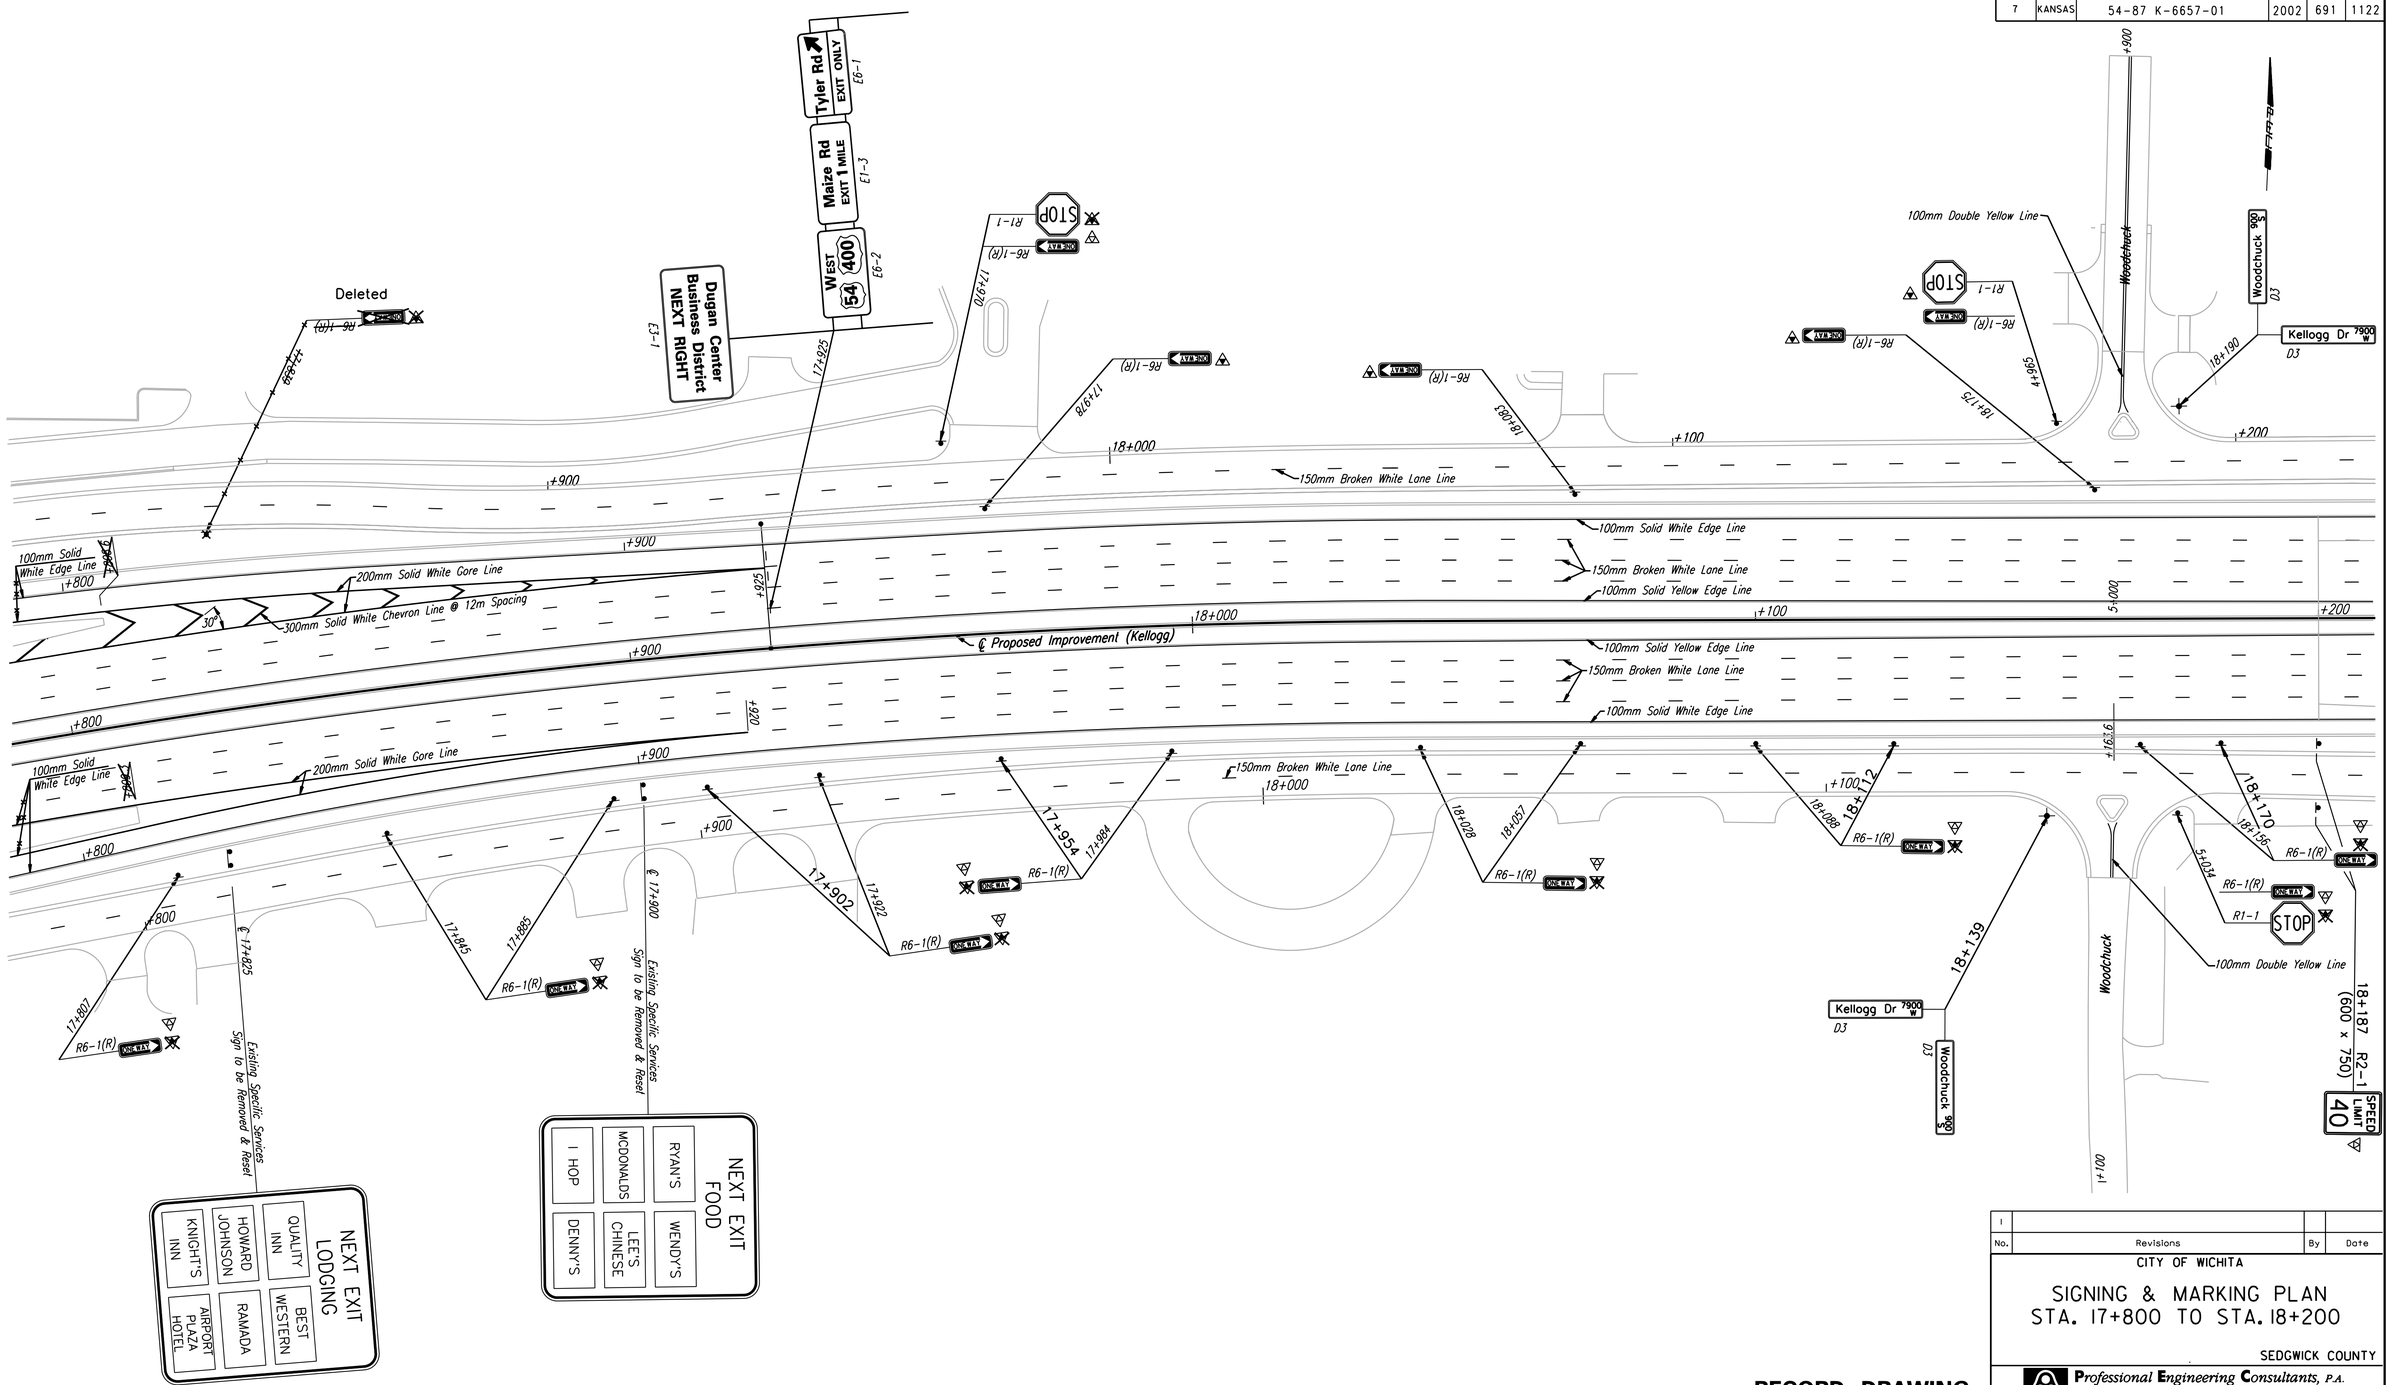

RECORD DRAWING

No.	Revisions	By	Date
1			

CITY OF WICHITA

SIGNING & MARKING PLAN
STA. 17+800 TO STA. 18+200

SEDGWICK COUNTY

Professional Engineering Consultants, P.A.
303 S. TOPEKA • WICHITA, KANSAS 67202
316-262-2691 • FAX 316-262-3003

Designed by	RPG	Checked by	WDH	
Drawn by	SVB	Date	April, 2002	Job No. 97362

DATE	BY	
	REFERENCES NOTED	
	REFERENCES CHECKED	

DSNR: WDH OPER: JGP SCALE: 1:500
I:/1997/97362/As-Builts/dgn's/Vol_4/Sh 691-pl178.dgn Last Rev: 10-1-07 By: gdr