FHWA REGION NO.	STATE	PROJECT NO.	YEAR	SHEET NO.	TOTAL SHEETS
7	KANSAS	54-87 K-6657-01	2002	702	1122

Scale: 1:500

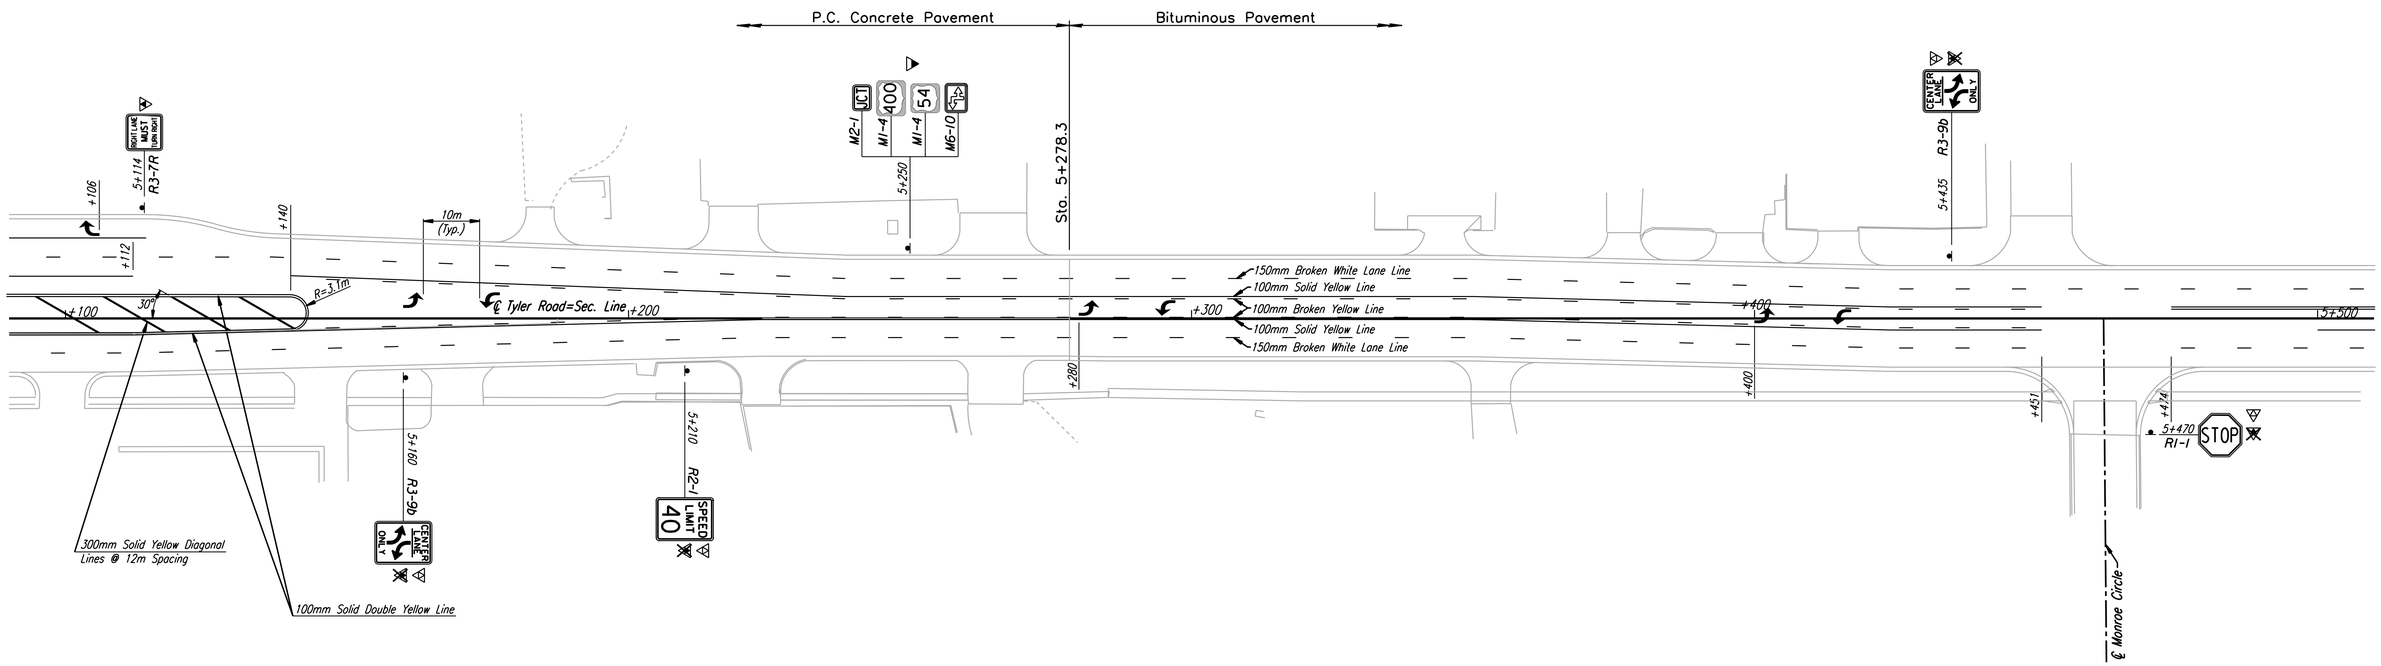

RECORD DRAWING

No.	Revisions	By	Date
1			

CITY OF WICHITA

SIGNING & MARKING PLAN
TYLER ROAD
STA. 5+100 TO STA. 5+500

SEDGWICK COUNTY

Professional Engineering Consultants, P.A.
303 S. TOPEKA • WICHITA, KANSAS 67202
316-262-2691 • FAX 316-262-3003

Designed by	RPG	Checked by	WDH
Drawn by	SVB	Date April, 2002	Job No. 97362

	DATE
BY	
REFERENCES NOTED	
REFERENCES CHECKED	

DSNR: RCH OPER: JGP SCALE: 1:500
I:/1997/97362/As-Builts/agnt's/Vol_4/Sh 702-Tyler-pl5100.dgn Last Rev: 10-2-07 By: gdr