FHWA REGION NO.	STATE	PROJECT NO.	YEAR	SHEET NO.	TOTAL SHEETS
7	KANSAS	54-87 K-6657-01	2002	811	1122

DATE	BY	
	REFERENCES NOTED	
	REFERENCES CHECKED	

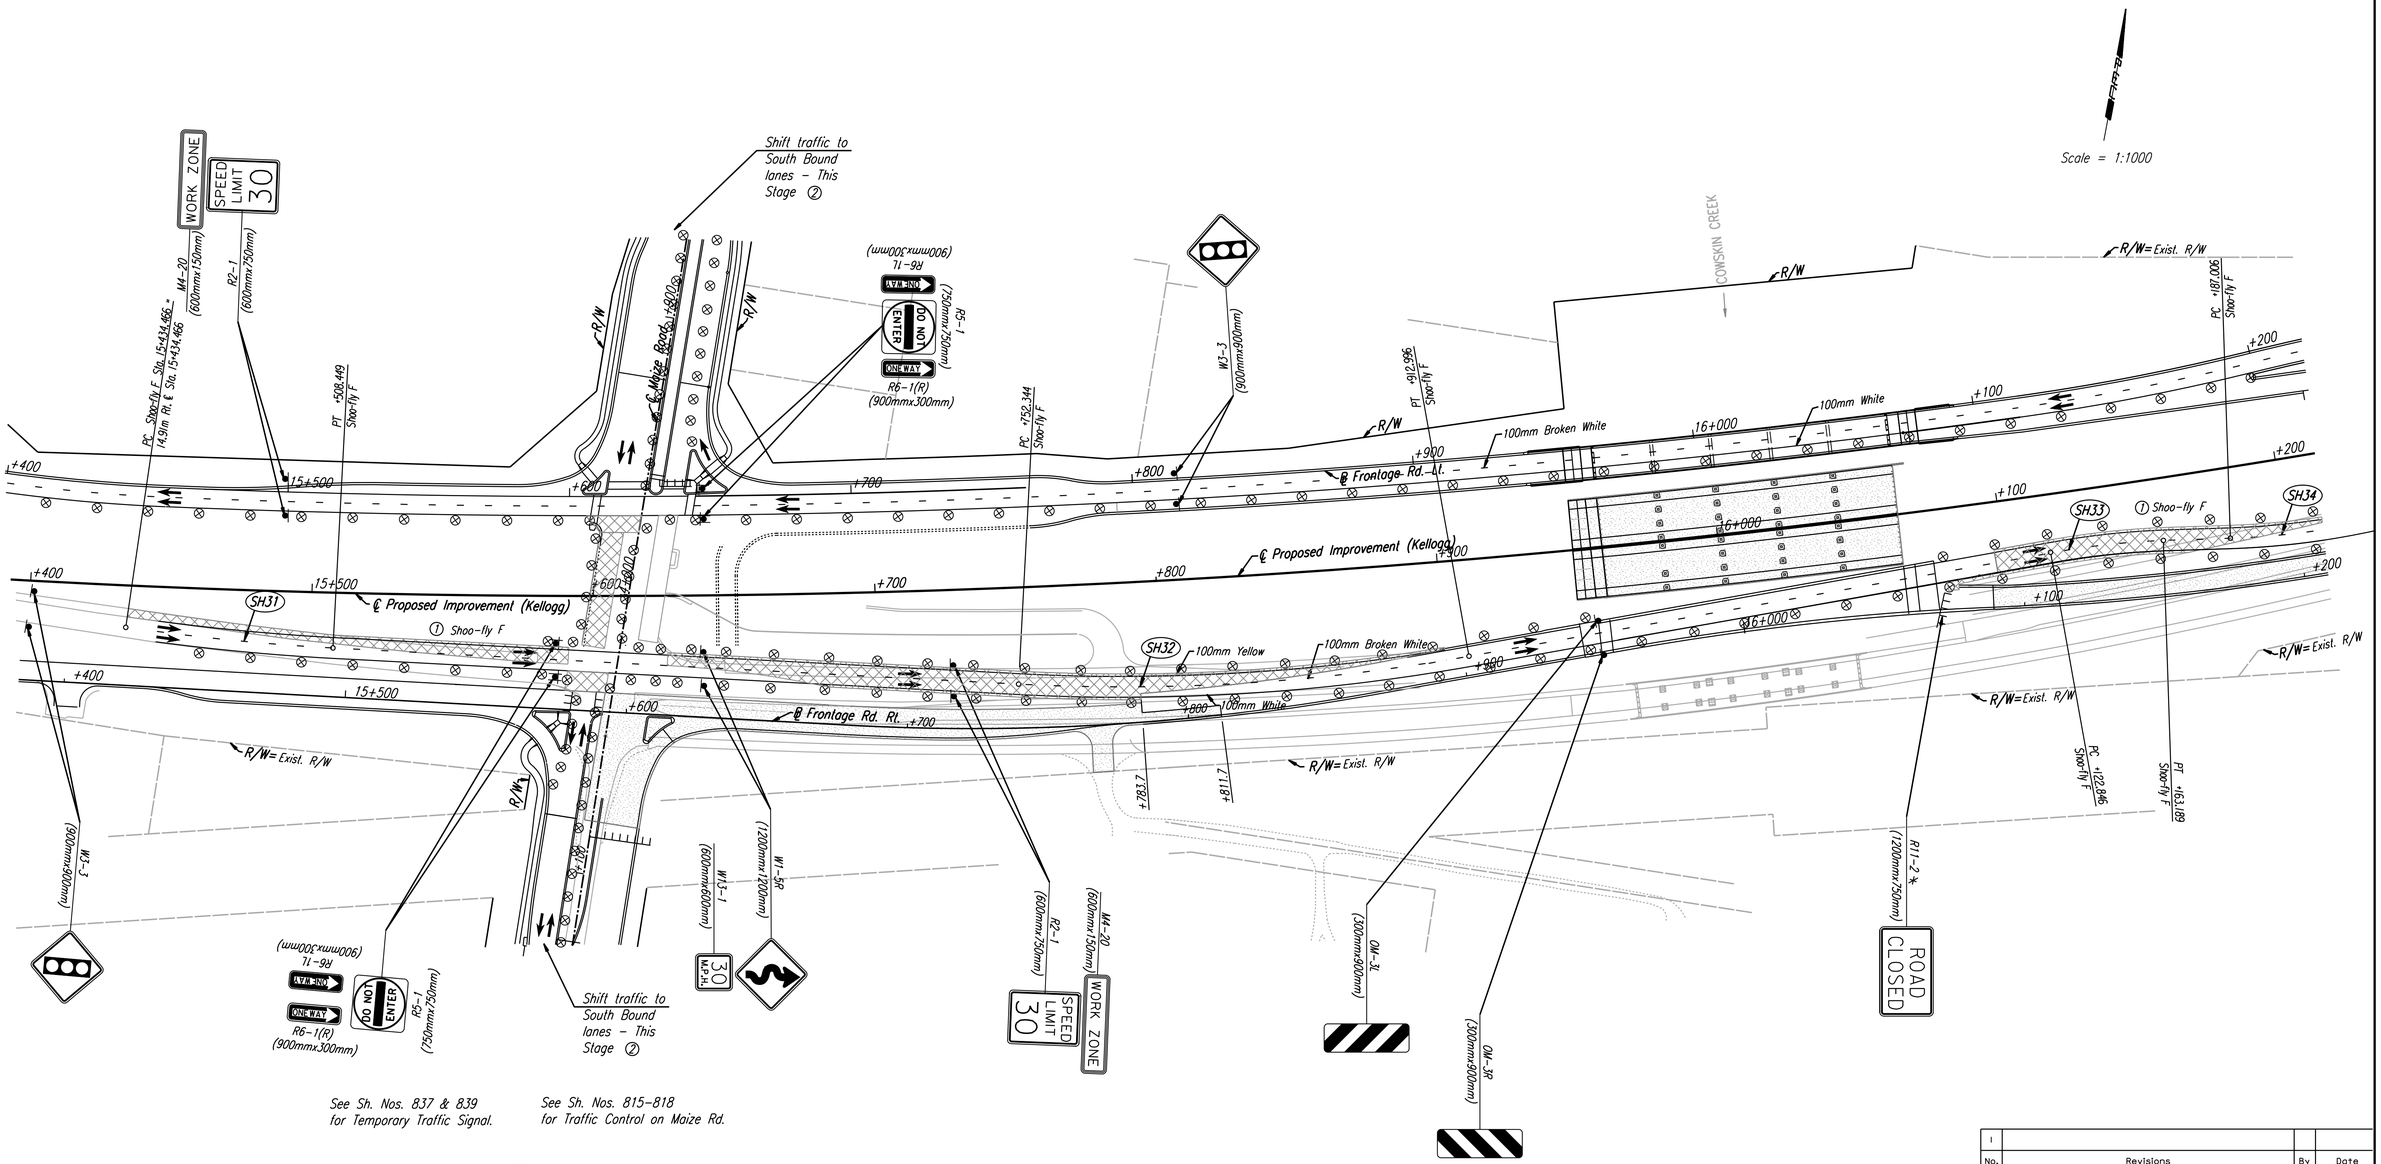

See Sh. Nos. 837 & 839 for Temporary Traffic Signal.

See Sh. Nos. 815-818 for Traffic Control on Maize Rd.

① See Sh. No. 845 for Shoo-fly F Profile.

② Contractor to submit Traffic Control Plan to Engineer for Approval.

No.	Revisions	By	Date
1			

CITY OF WICHITA

TRAFFIC CONTROL
STAGE 2B
STA. 15+400 TO STA. 16+200

SEDGWICK COUNTY

Professional Engineering Consultants, P.A.
303 S. TOPEKA • WICHITA, KANSAS 67202
316-262-2691 • FAX 316-262-3003

Designed by	RPG, RWM	Checked by	WDH	
Drawn by	JGP	Date	April, 2002	Job No. 97362

DSNR: OPER: JGP Scale: 1:1000
I:/1997/97362/As-Builts/dgn's/Vol 4/Sh 811-TC Stage 2b-pl154.dgn Last Rev: 10-4-07 By: gdr