FHWA REGION NO.	STATE	PROJECT NO.	YEAR	SHEET NO.	TOTAL SHEETS
7	KANSAS	54-87 K-6657-01	2002	818	1122

	BY	DATE
REFERENCES NOTED		
REFERENCES CHECKED		

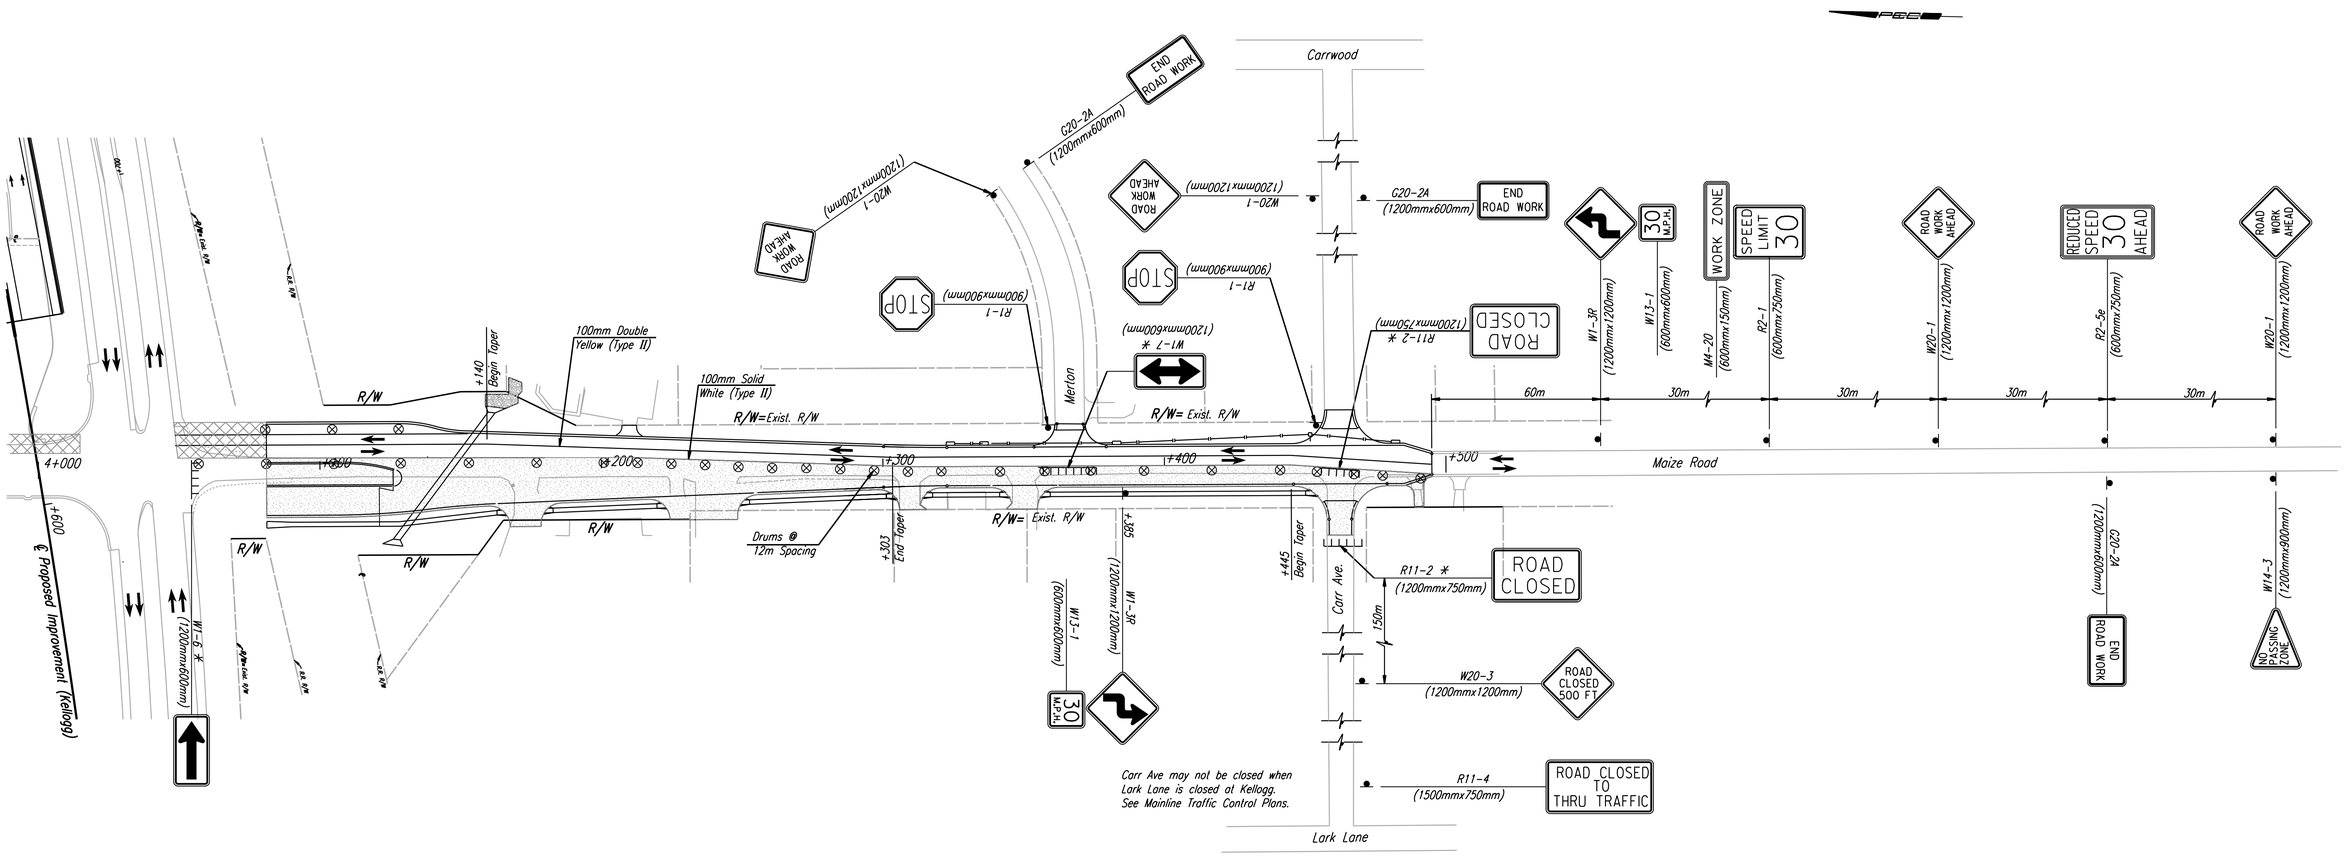

No.	Revisions	By	Date
1			

CITY OF WICHITA

MAIZE ROAD
TRAFFIC CONTROL - STAGE IB
STA. 4+000 TO STA. 4+495

SEDGWICK COUNTY

Professional Engineering Consultants, P.A.
303 S. TOPEKA • WICHITA, KANSAS 67202
316-262-2691 • FAX 316-262-3003

Designed by	RPG, RWM	Checked by	WDH
Drawn by	JGP	Date	April, 2002
Job No.	97362		

DSNR: OPER: JGP Scale: 1:1000
I:/1997/97362/As-Builts/dgn's/Vol 4/Sh 818-TC Stage 1b-mzpl4000.dgn Last Rev: 10-5-07 By: pdr