FHWA REGION NO.	STATE	PROJECT NO.	YEAR	SHEET NO.	TOTAL SHEETS
7	KANSAS	54-87 K-6657-01	2002	1	1122

INDEX OF SHEETS
SEE SH. NO. 897

STATE OF KANSAS
DEPARTMENT OF TRANSPORTATION

VOLUME V

GRADING
SURFACING
CONCRETE PAVEMENT
BRIDGES
SIGNING
LIGHTING
SIGNALIZATION
PAVEMENT MARKING
LANDSCAPING & IRRIGATION

PLAN AND PROFILE OF PROPOSED
STATE HIGHWAY
SEDGWICK COUNTY
CITY OF WICHITA
KELLOGG AVENUE (US-54)
TYLER RD. & MAIZE RD. INTERCHANGES
OCA NO. 702315
CITY OF WICHITA PROJECT NO. 472-83533

Note: Traffic to be carried through construction.
For traffic handling and construction sequence,
See Sh. Nos. 793-794

Scale: 1:20,000

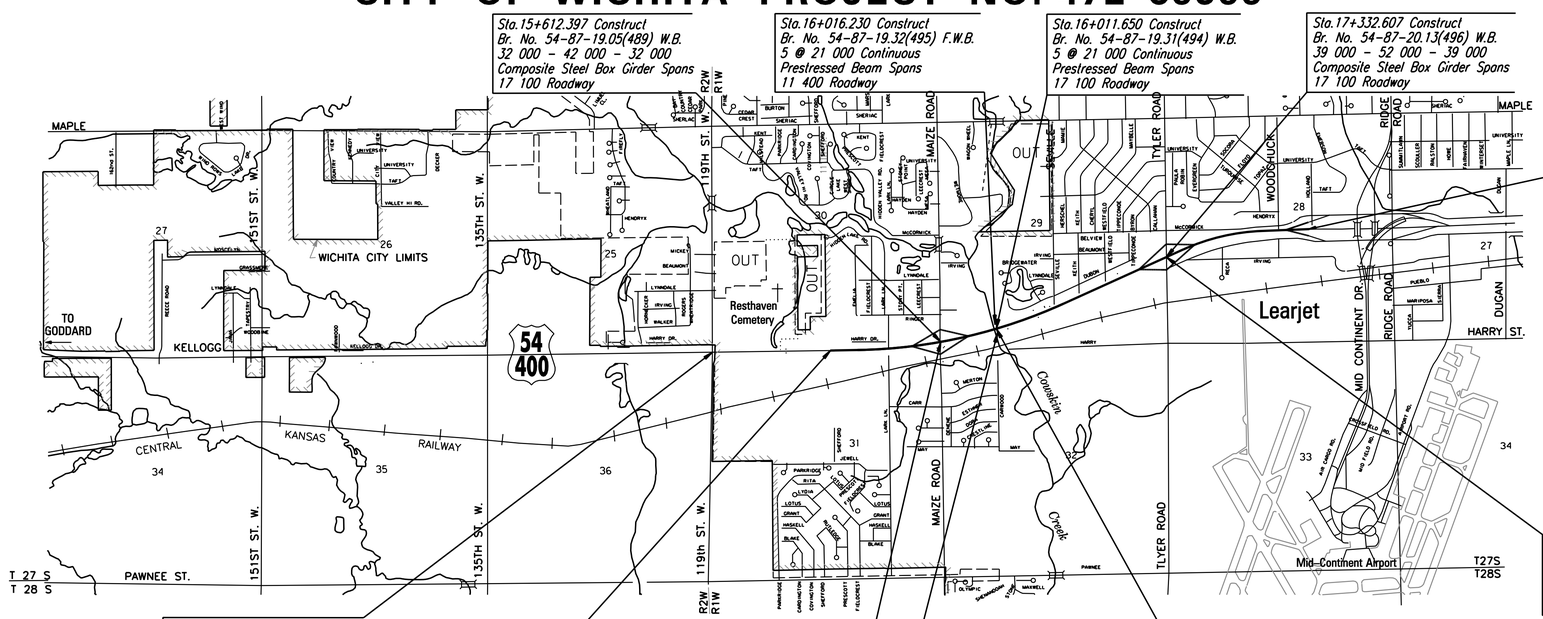

DESIGN DESIGNATION

AADT	(1997) 30,103
AADT	(2025) 88,000
DHV	11%
D	60%
T	4%
V	110 KM/HR.
C of A	FULL
Clear Zone	= 10.5M

CONVENTIONAL SIGNS

COUNTY LINE		CENTER LINE OF PROJECT	
CITY LIMITS		TERRACE	
STATE OR NATIONAL LINE		CULVERTS	
TOWNSHIP, SECTION or GRANT LINE		DROP INLET & STORM SEWER	
PROPERTY LINE		ACCESS CONTROL	
HIGHWAY FENCE		POWER POLE	
EXISTING FENCE		TELEPHONE POLE	
GUARD FENCE		MARSH	
CONSTRUCTION LIMITS		HEDGE	
RIGHT OF WAY LINE		TREES	
TRAVELED WAY		PROFILE ELEVATION	
RAILROADS		STREAM or CREEK	

GROSS LENGTH OF PROJECT	3,590.000 M
EXCEPTIONS	NONE
ADDITIONS	NONE
NET LENGTH OF PROJECT	3,590.000 M
NET LENGTH OF BRIDGES	343.550 M
NET LENGTH OF ROAD	3,246.450 M

KDOT METRIC

All dimensions shown, without a SI suffix, are in millimeters. All elevations shown are in meters.

RECORD DRAWINGS

CONTRACTOR: Wildcat Construction Company, Inc.
INSPECTOR: Larry Powell, P.E. Professional Engineering Consultants, P.A.
.pdf by P.E.C., P.A. (December 2007)

PLANS PREPARED BY
Professional Engineering Consultants, P.A.
303 S. TOPEKA • WICHITA, KANSAS 67202
316-262-2691 • FAX 316-262-3003

MICHAEL LINDEBAK, P.E
CITY ENGINEER
FOR WICHITA, KANSAS

DATE

RECOM. FOR APPROVAL-DATE

CHIEF, BUREAU OF DESIGN
KANSAS DEPARTMENT OF TRANSPORTATION

APPROVED - DATE

STATE TRANSPORTATION ENGINEER
KANSAS DEPARTMENT OF TRANSPORTATION

DATE	BY

SURVEYED
PLOTTED
INKED
DESIGNED
SQUAD

DSNR: WDH OPER: JGP SCALE: 1:20000
I:/1997/97362/As-Builts/dgn's/Sh_1-Title.dgn Last Rev: 12-6-07 By: gdr