REG NO.	STATE	PROJECT NO.	YEAR	SHEET NO.	TOTAL SHEETS
7	KANSAS	54-87 K-6657-01	2002	905	1122

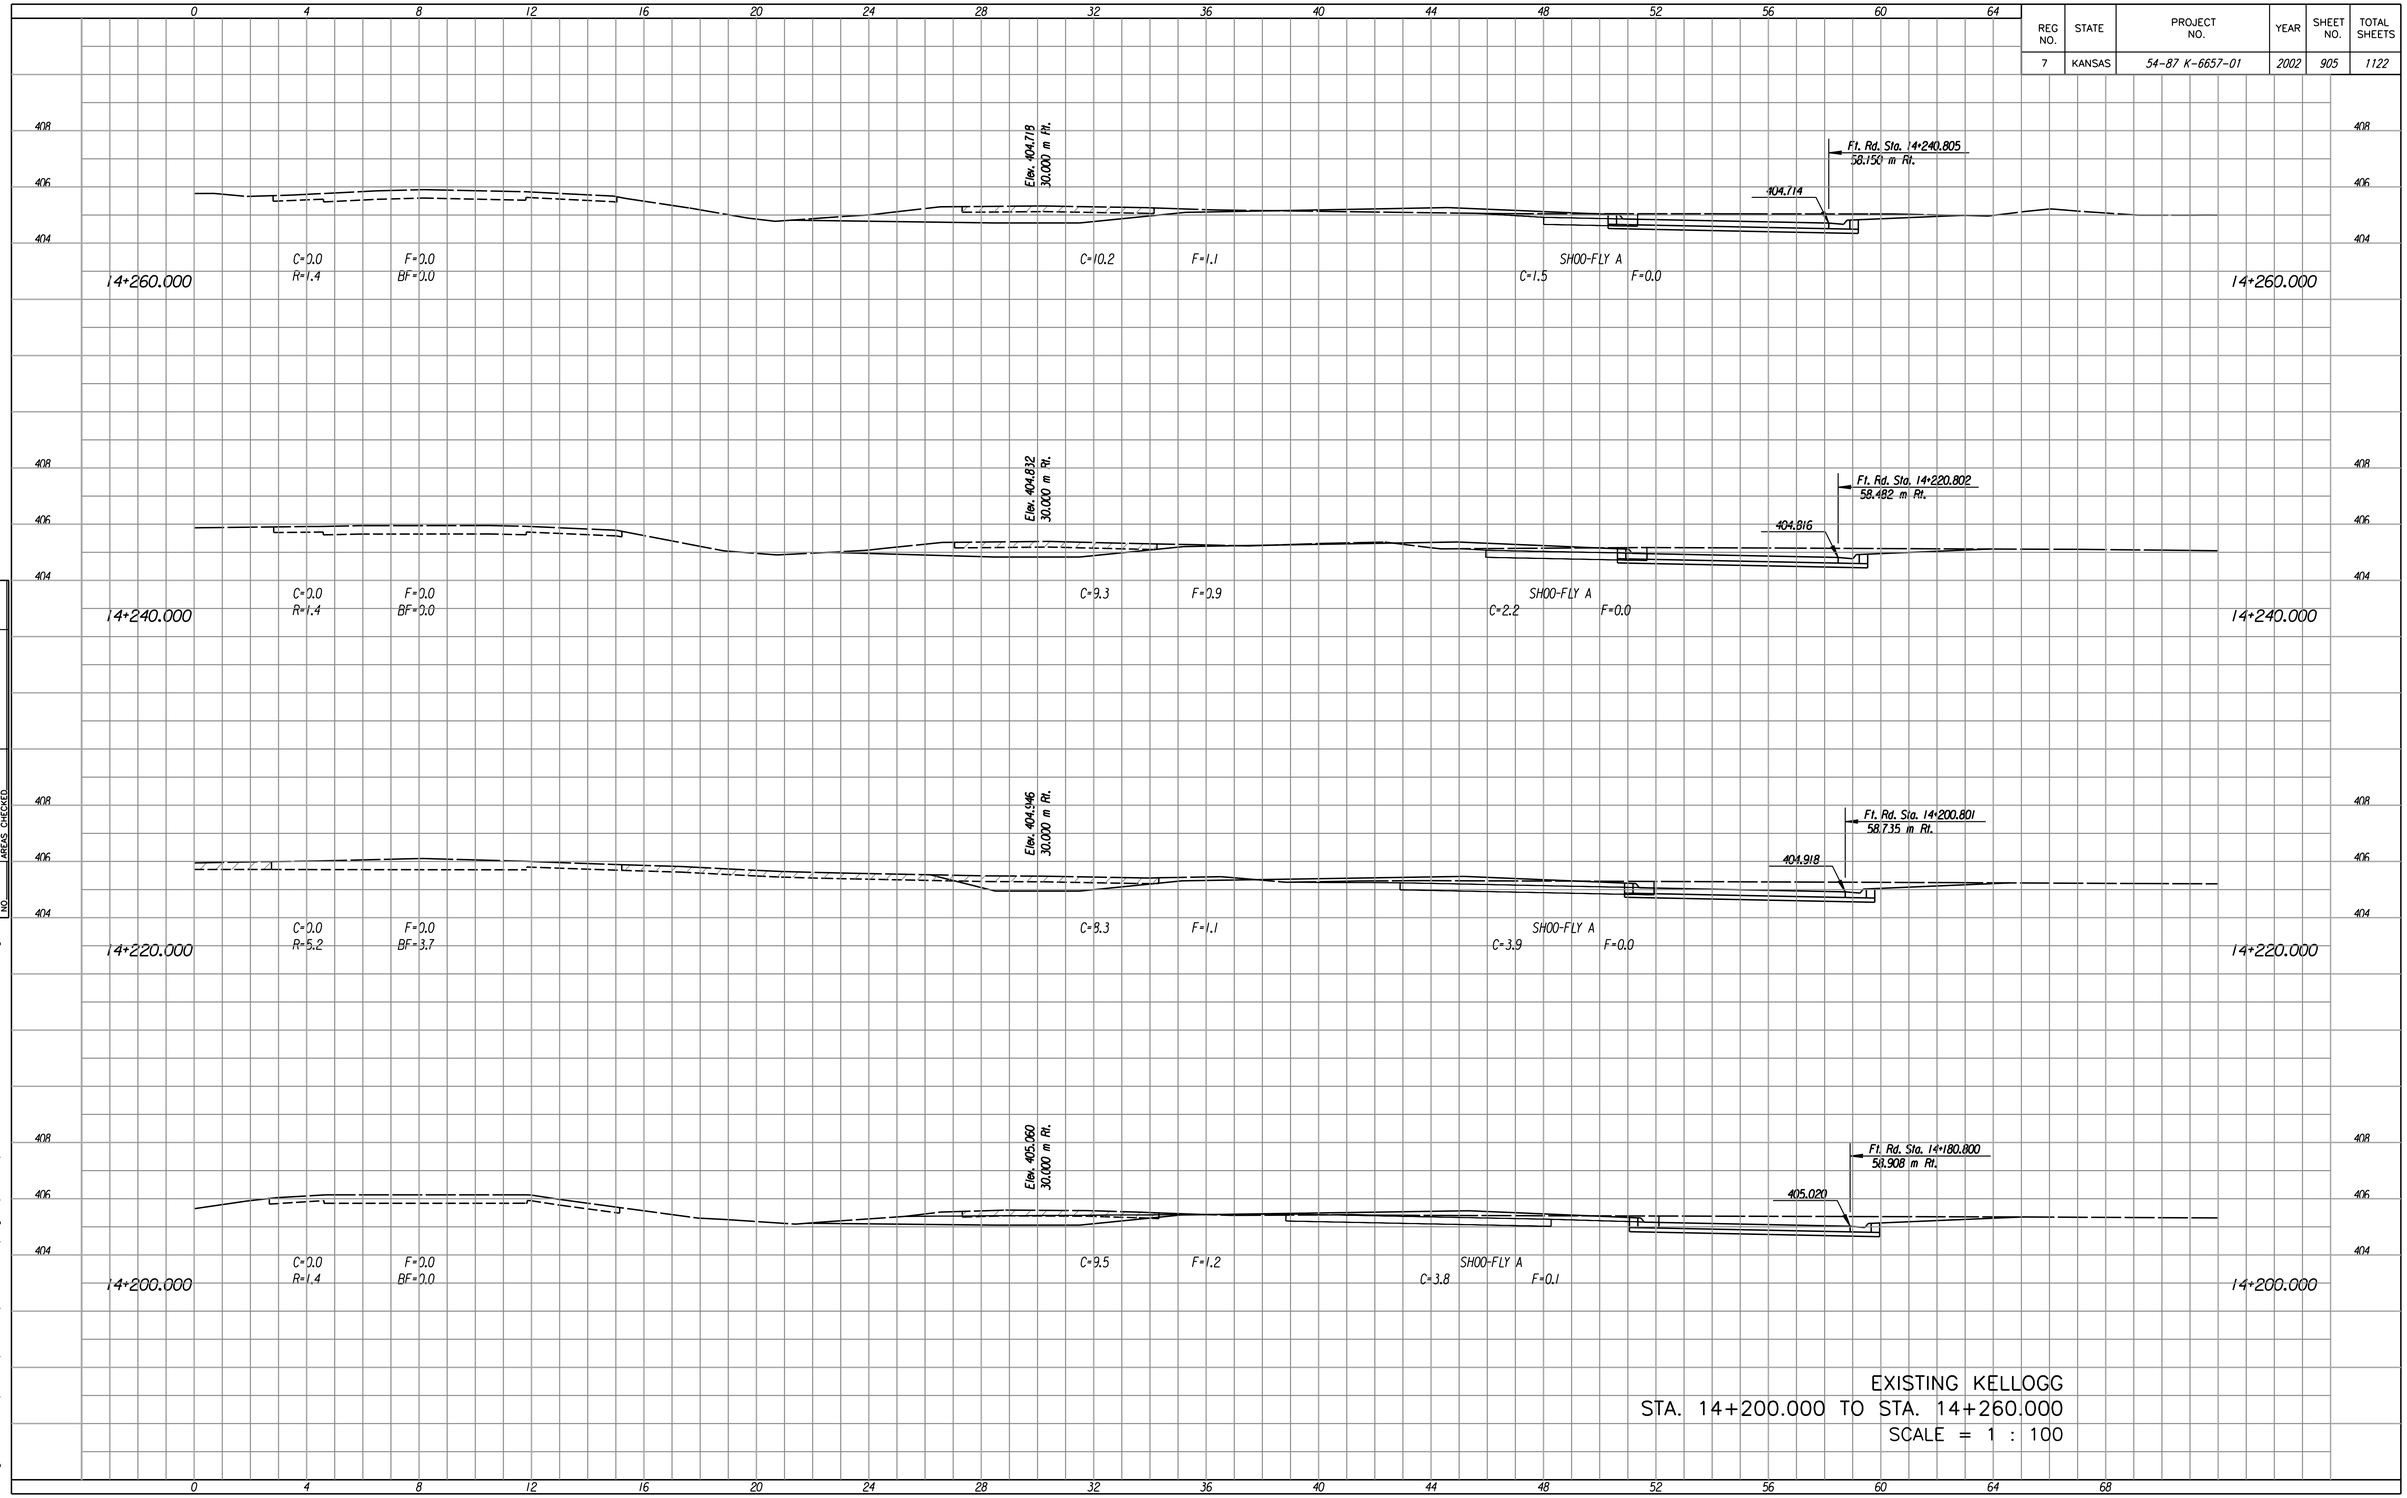

FINAL SURVEY			
NOTE BOOK	SURVEYED		
	PLOTTED		
	TRAVERSE		
	AREAS		
NO.	AREAS CHECKED	BY	DATE

Scale : 100
Last Rev. : 10-12-07 By: gdr
Design File : I:/1997/97362/As-Builts/dgn's/Vol 5/Sh 0905-Mainline-xs14200Rt.dgn