REG NO.	STATE	PROJECT NO.	YEAR	SHEET NO.	TOTAL SHEETS
7	KANSAS	54-87 K-6657-01	2002	915	1122

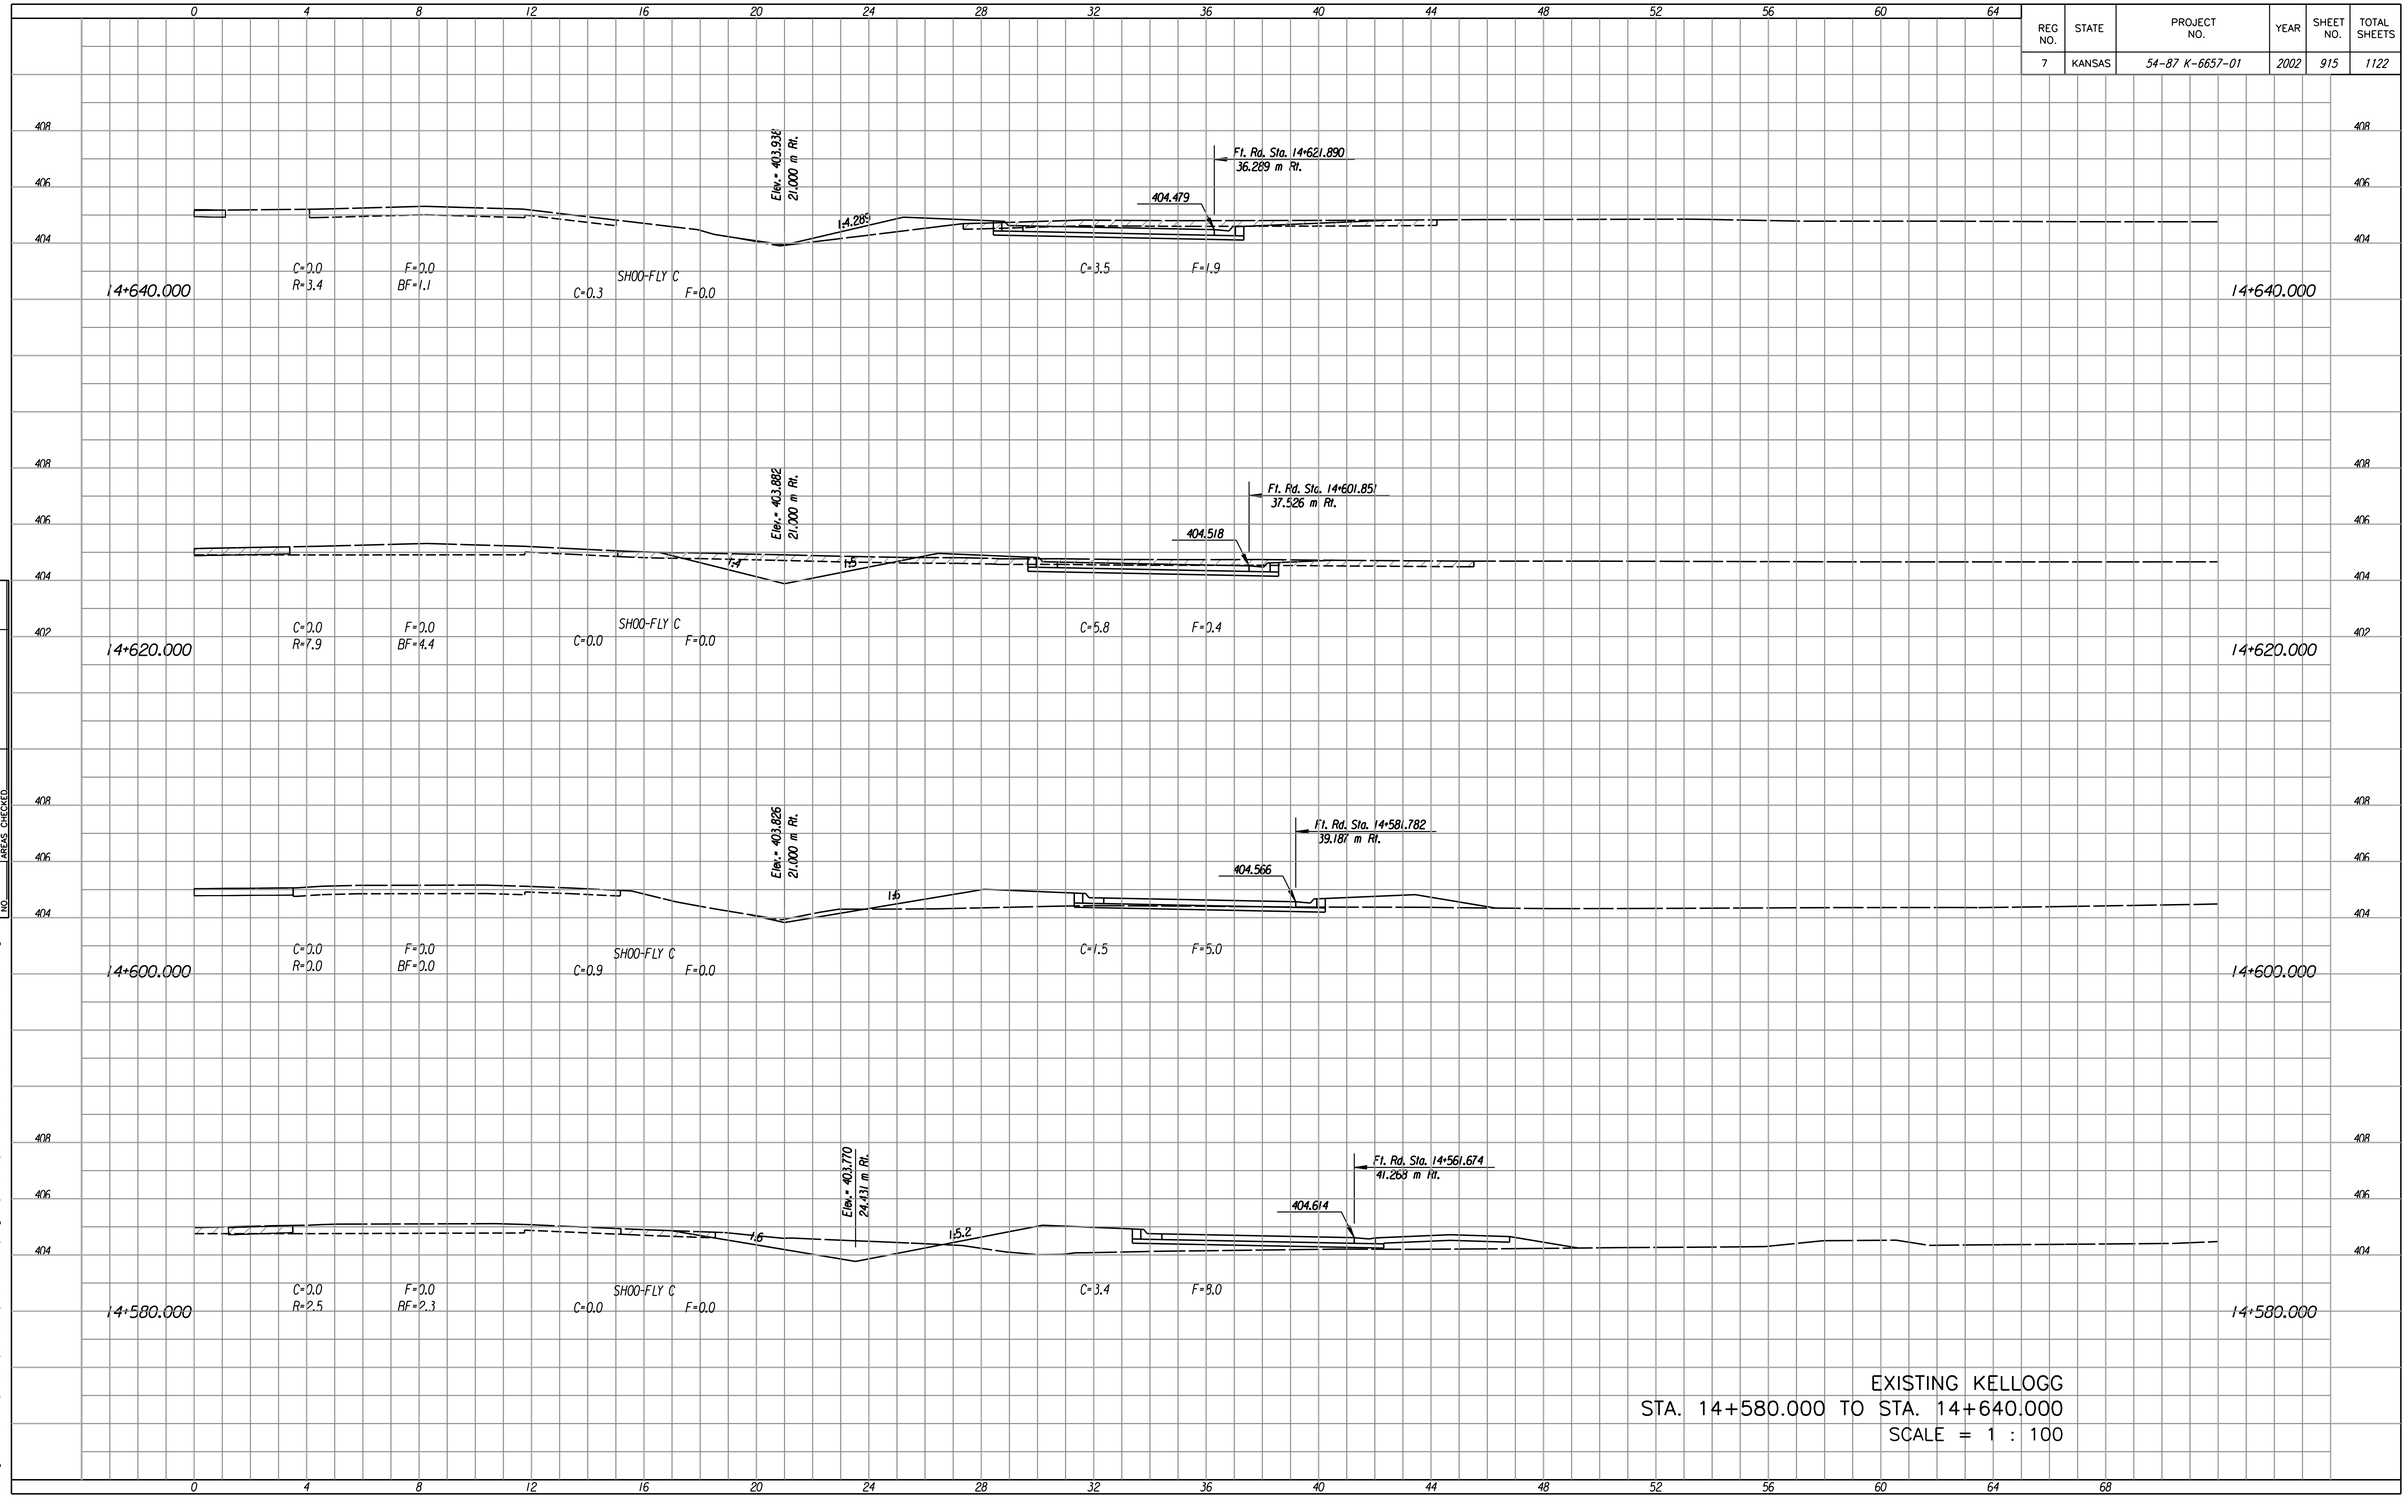

FINAL SURVEY		BY	DATE
	SURVEYED		
	PLOTTED		
NOTE BOOK	PLOTTED		
	AREAS		
NO.	AREAS CHECKED		

Scale : 100
Last Rev. : 10-12-07 By: gdr
Design File : ¢:/1997/97362/As-Builts/dgn's/Vol 5/Sh 0915-Mainline-xs14580Rt.dgn