REG NO.	STATE	PROJECT NO.	YEAR	SHEET NO.	TOTAL SHEETS
7	KANSAS	54-87 K-6657-01	2002	919	1122

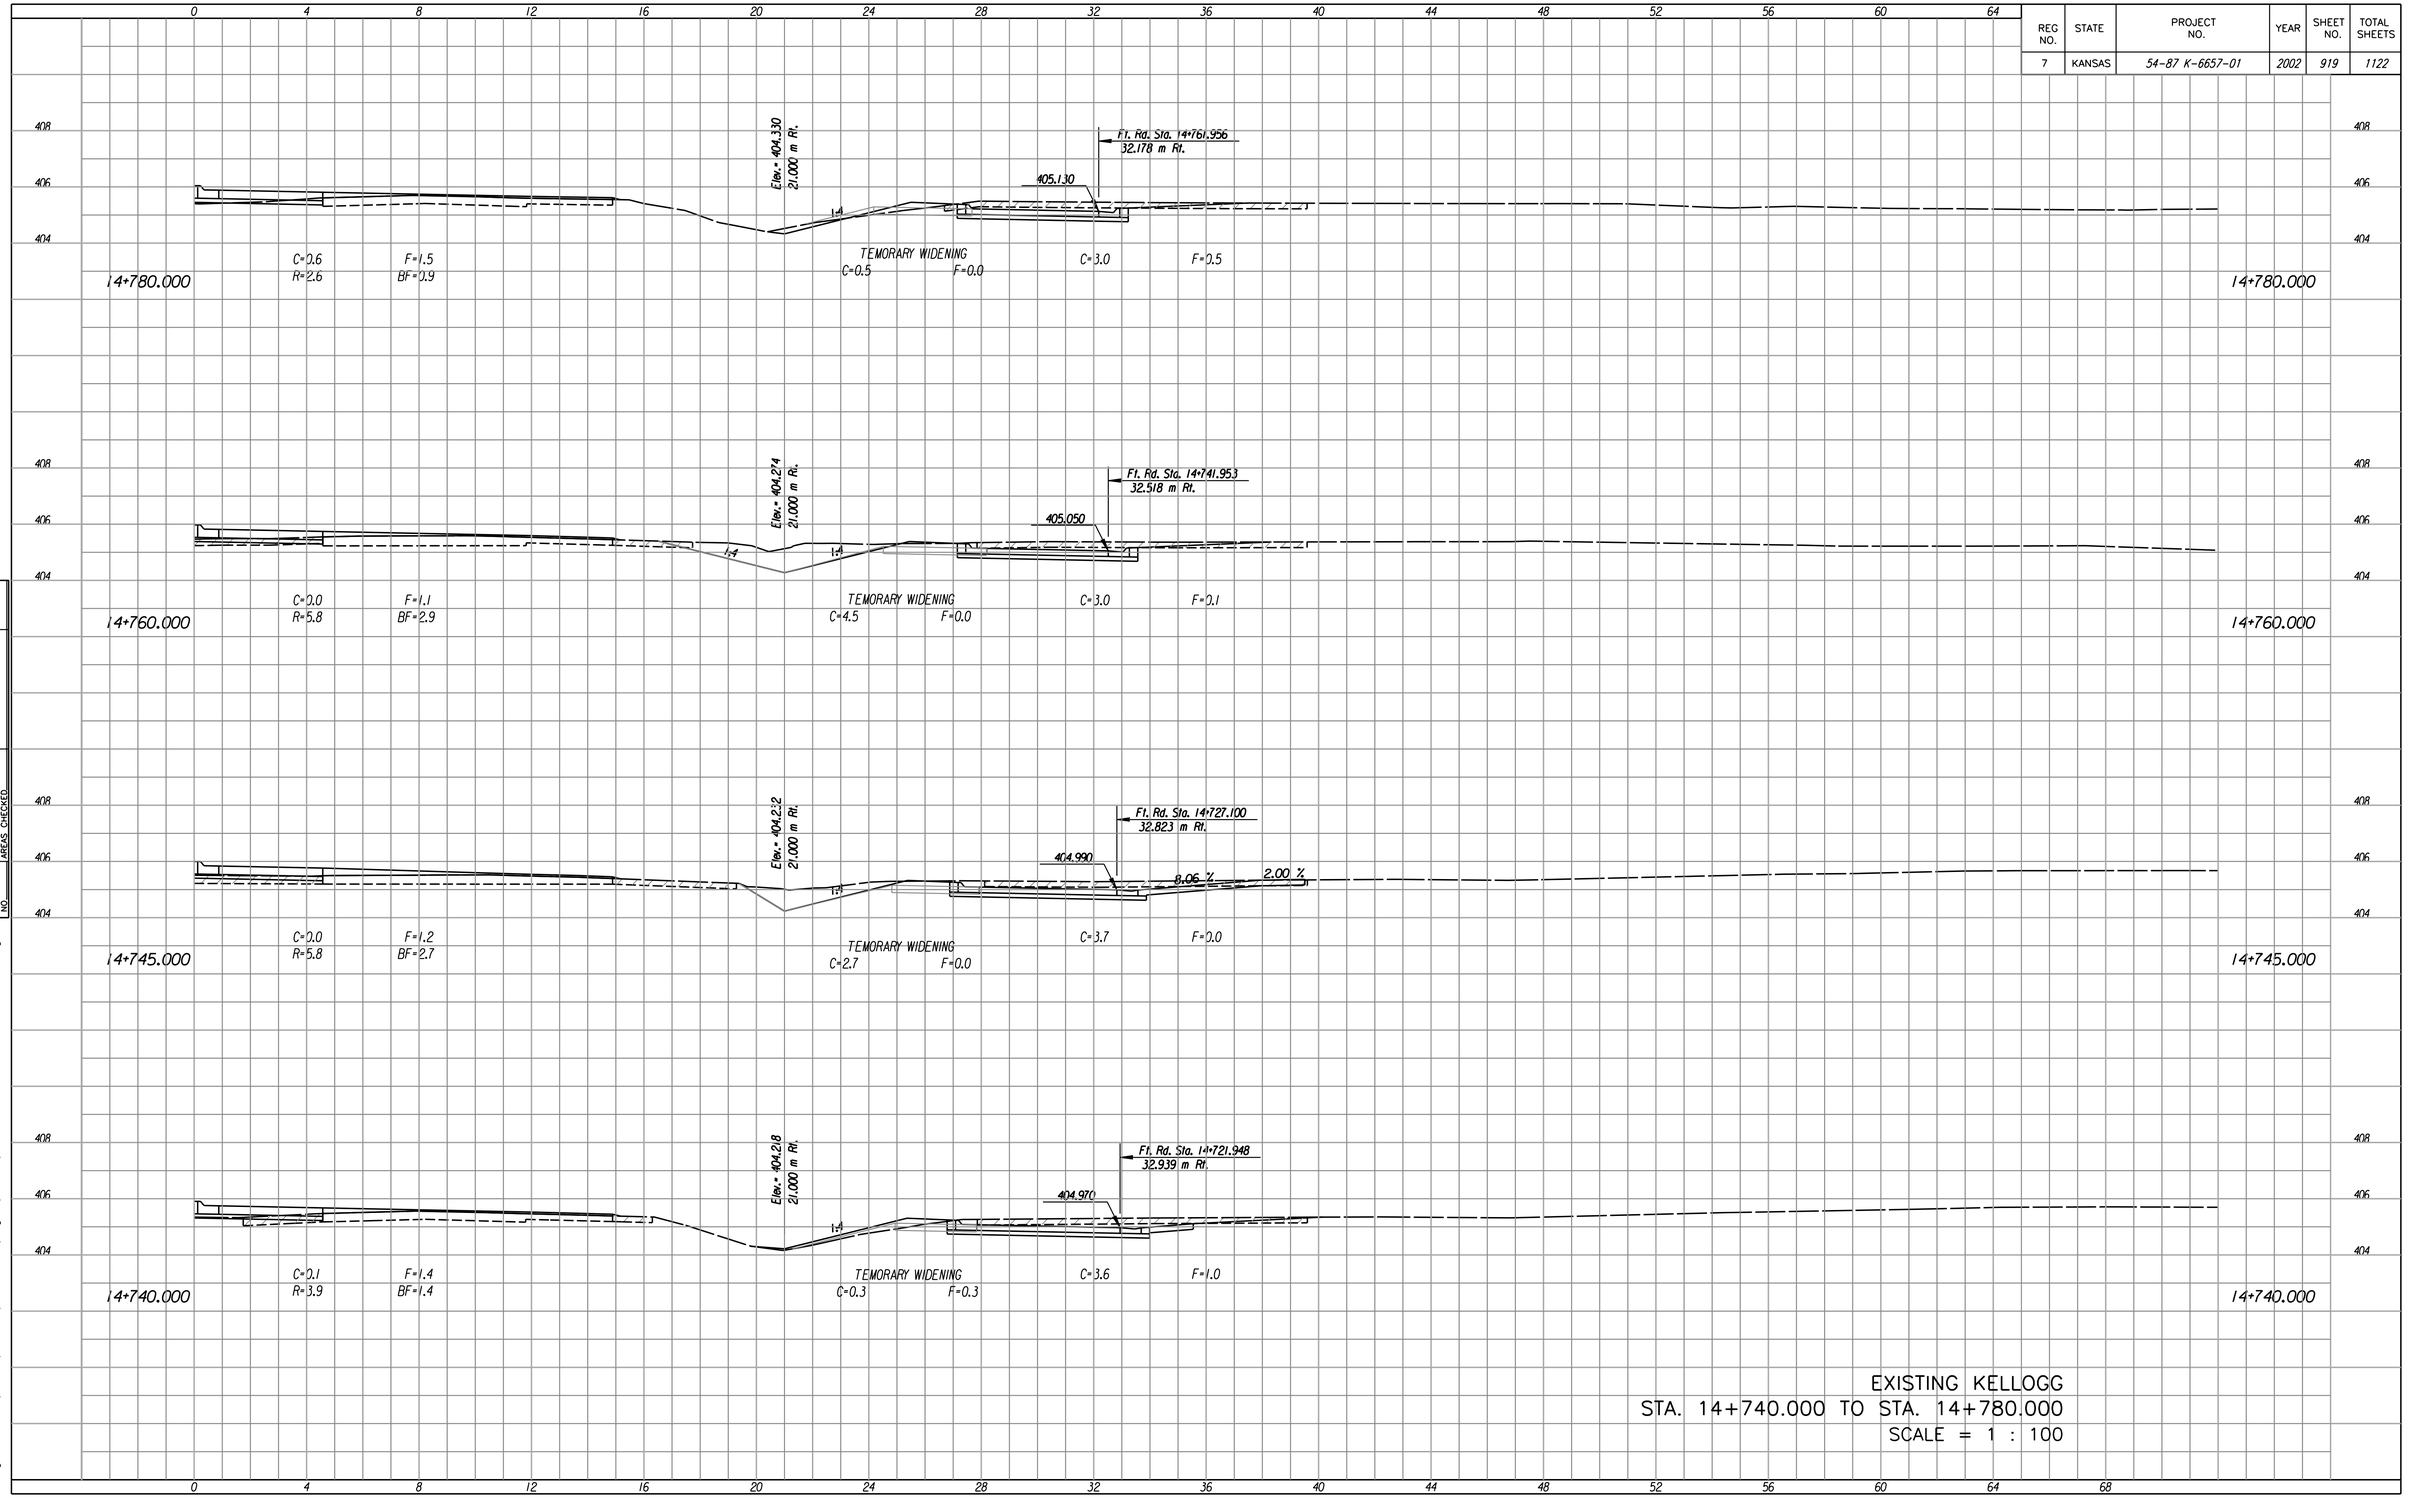

DATE
BY
FINAL SURVEY
SURVEYED
PLOTTED
NOTE BOOK
AREAS
AREAS CHECKED
NO.

Scale : 100
Last Rev. : 10-12-07 By: gdr
Design File : i:/1997/97362/As-Builts/dgn's/Vol 5/Sh 0919-Mainline-xs14740Rt.dgn

EXISTING KELLOGG
STA. 14+740.000 TO STA. 14+780.000
SCALE = 1 : 100