


REG NO.	STATE	PROJECT NO.	YEAR	SHEET NO.	TOTAL SHEETS
7	KANSAS	54-87 K-6657-01	2002	923	1122

FINAL SURVEY NO.	DATE
SURVEYED BY	
PLOTTED BY	
TEMPLATE AREAS CHECKED	
NO. OF AREAS CHECKED	

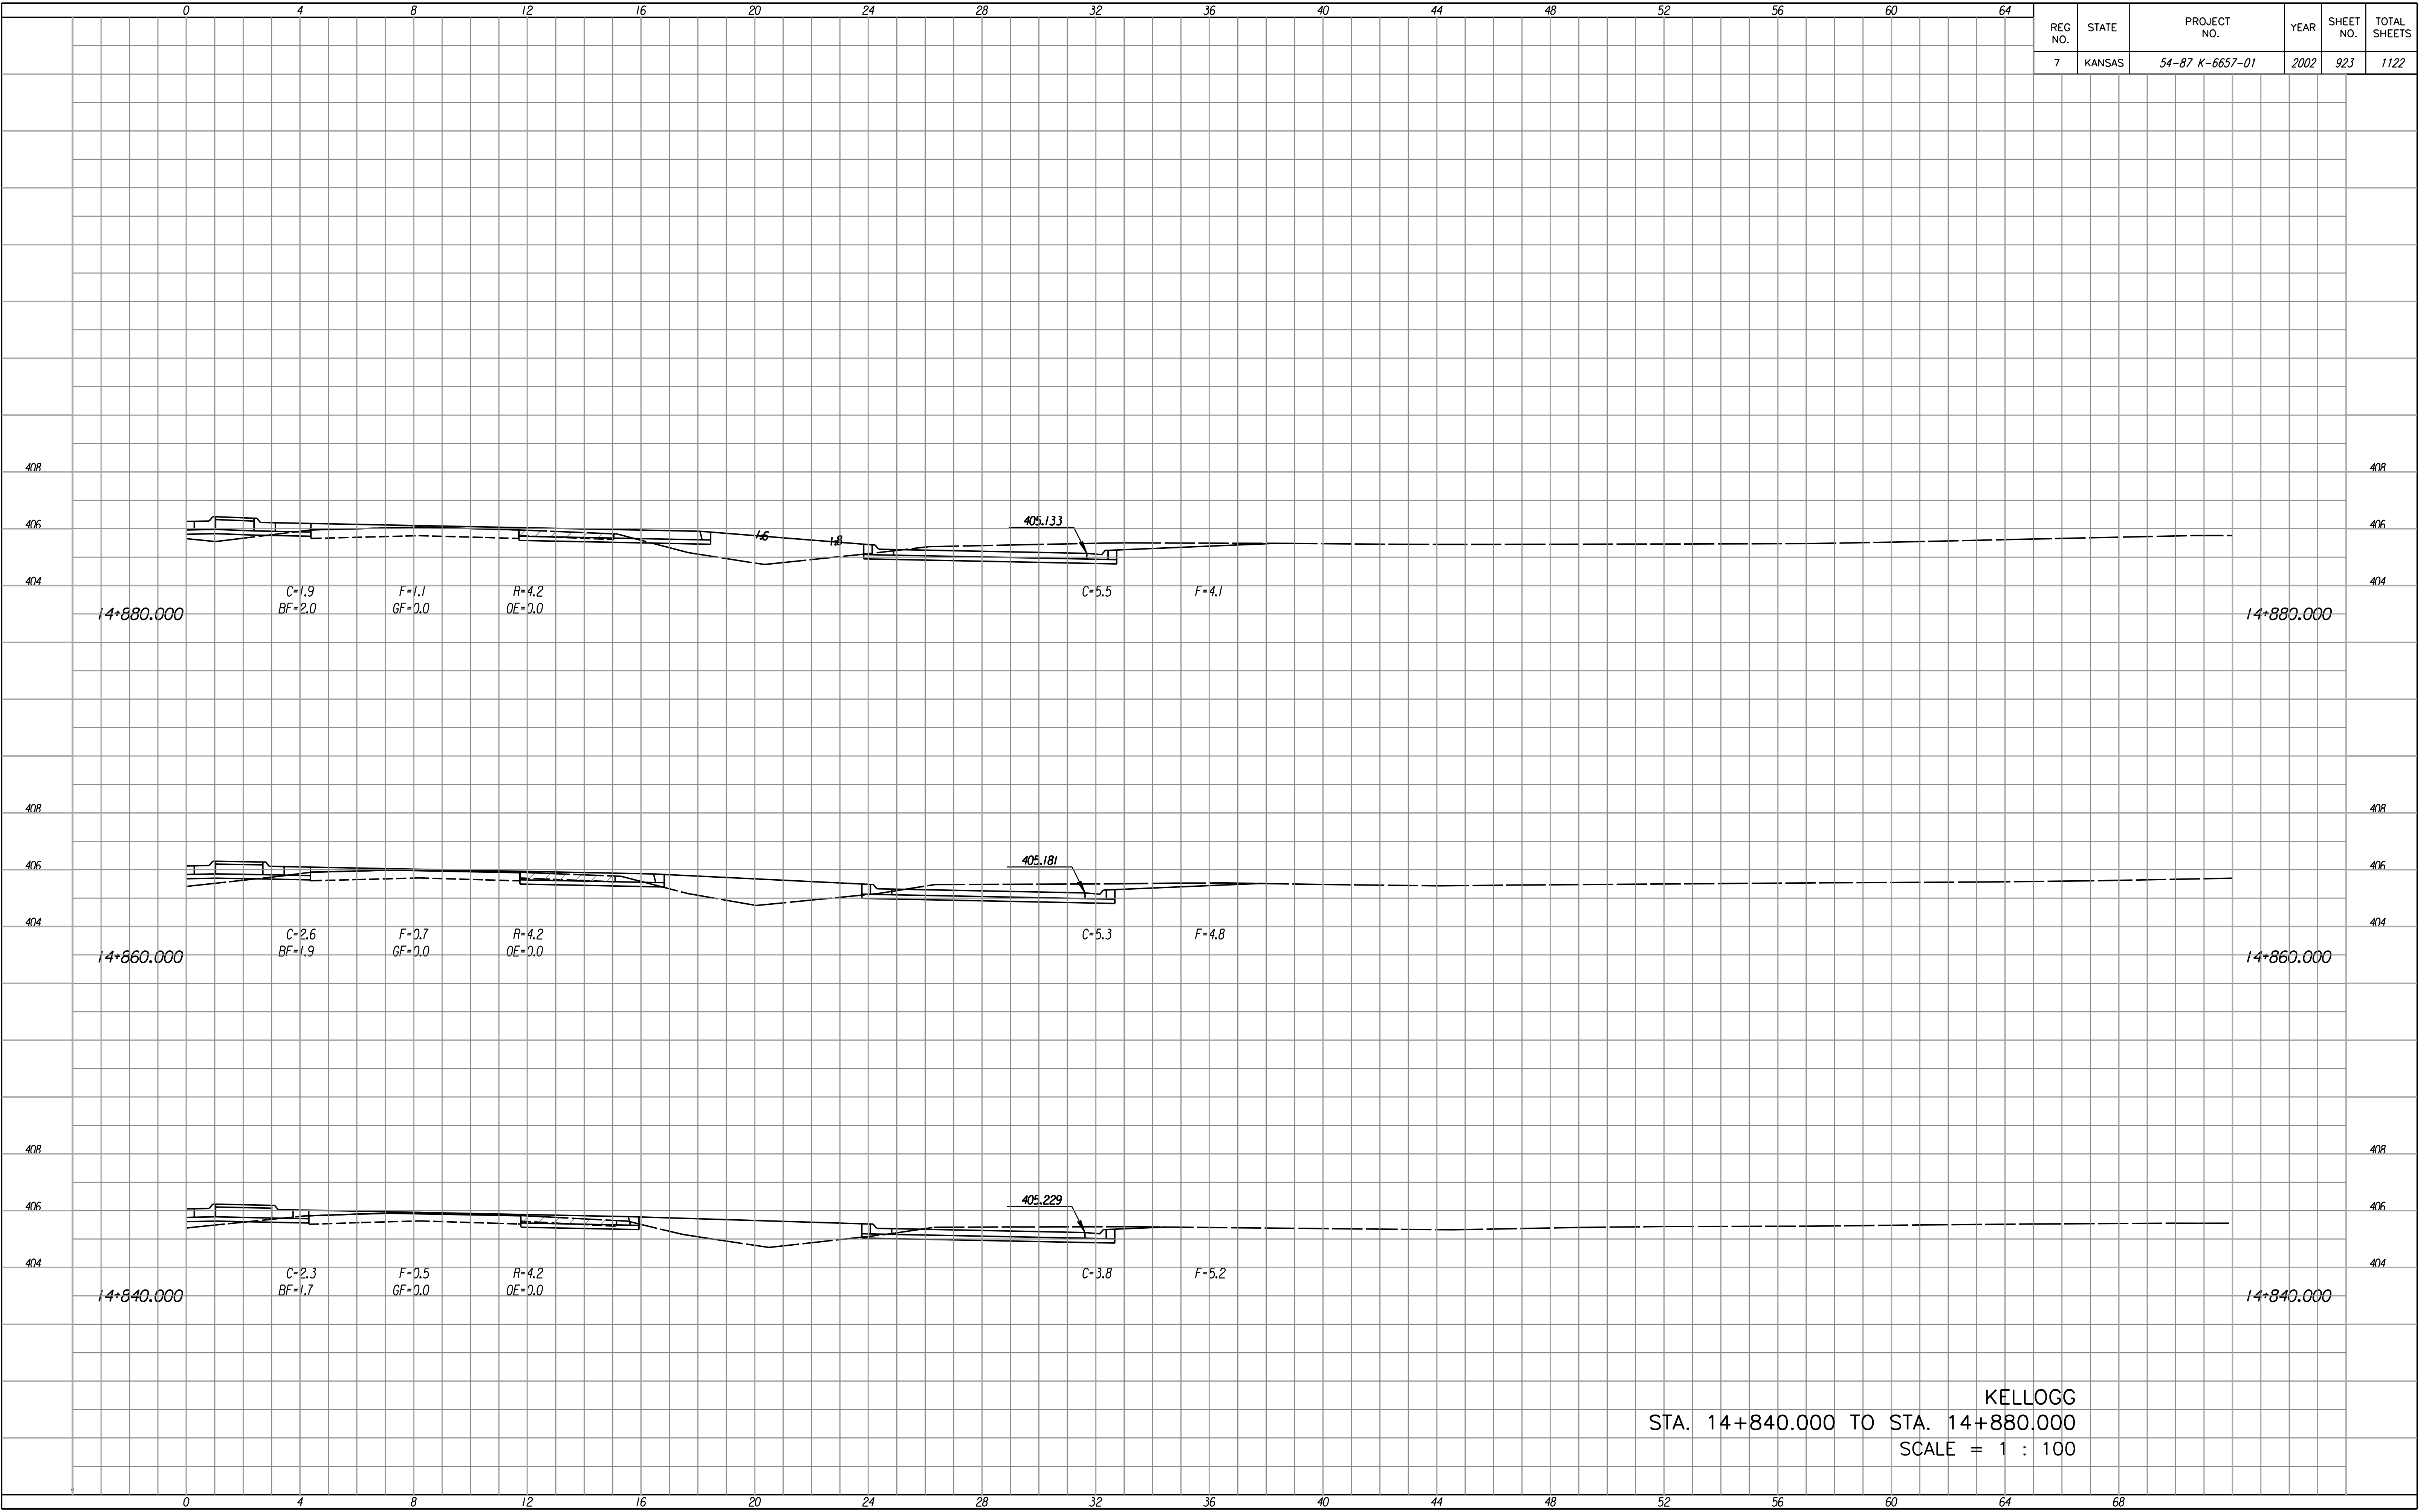

KELLOGG
 STA. 14+840.000 TO STA. 14+880.000
 SCALE = 1 : 100

Last Rev : 10-12-07 By: gdr
 Scale : 100
 Design File : I:\1997\97362\ls-Builds\ dgn\ Vol 5\St 0923-Mainline-x148400.dgn