REG NO.	STATE	PROJECT NO.	YEAR	SHEET NO.	TOTAL SHEETS
7	KANSAS	54-87 K-6657-01	2002	924	1122

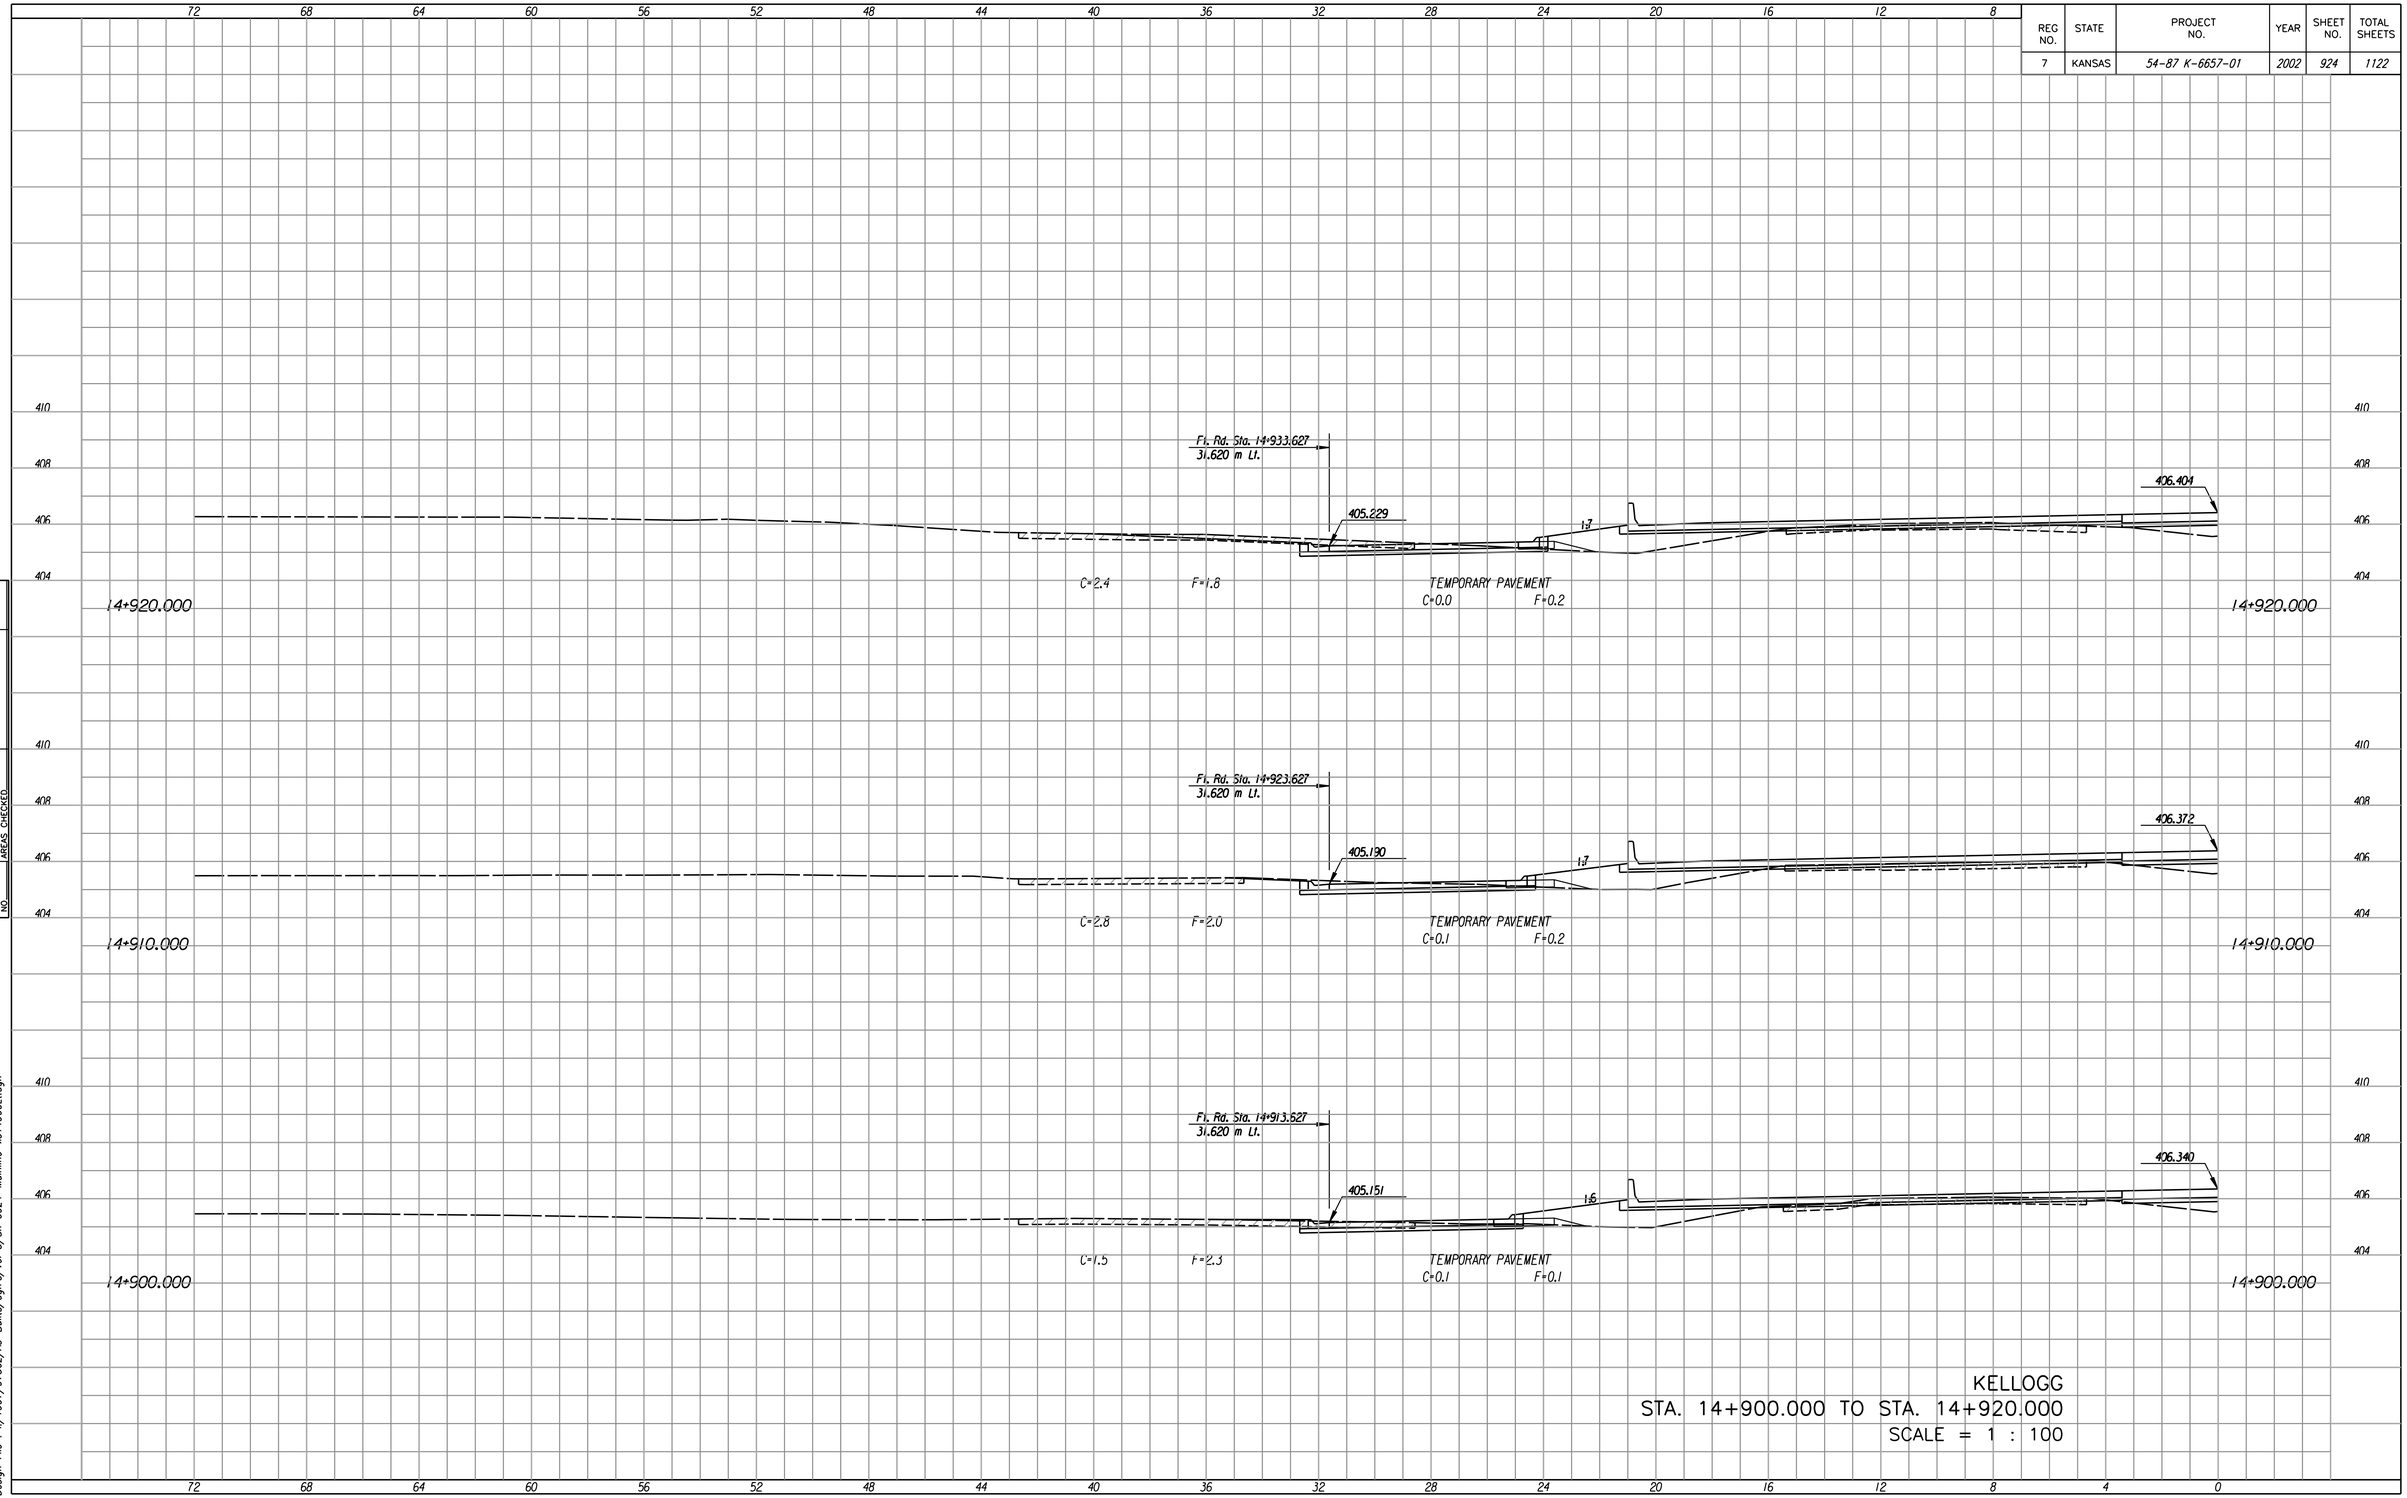

KELLOGG
STA. 14+900.000 TO STA. 14+920.000
SCALE = 1 : 100

DATE	BY

FINAL SURVEY
NOTE BOOK
NO.
SURVEYED
PLOTTED
TRACED
AREAS
AREAS CHECKED

Last Rev. : 10-12-07 By: gdr
Scale : 100
Design File : t:/1997/97362/As-Builts/dgns/Vol 5/Sh 0924-Mainline-xs14900L.dgn