REG NO.	STATE	PROJECT NO.	YEAR	SHEET NO.	TOTAL SHEETS
7	KANSAS	54-87 K-6657-01	2002	925	1122

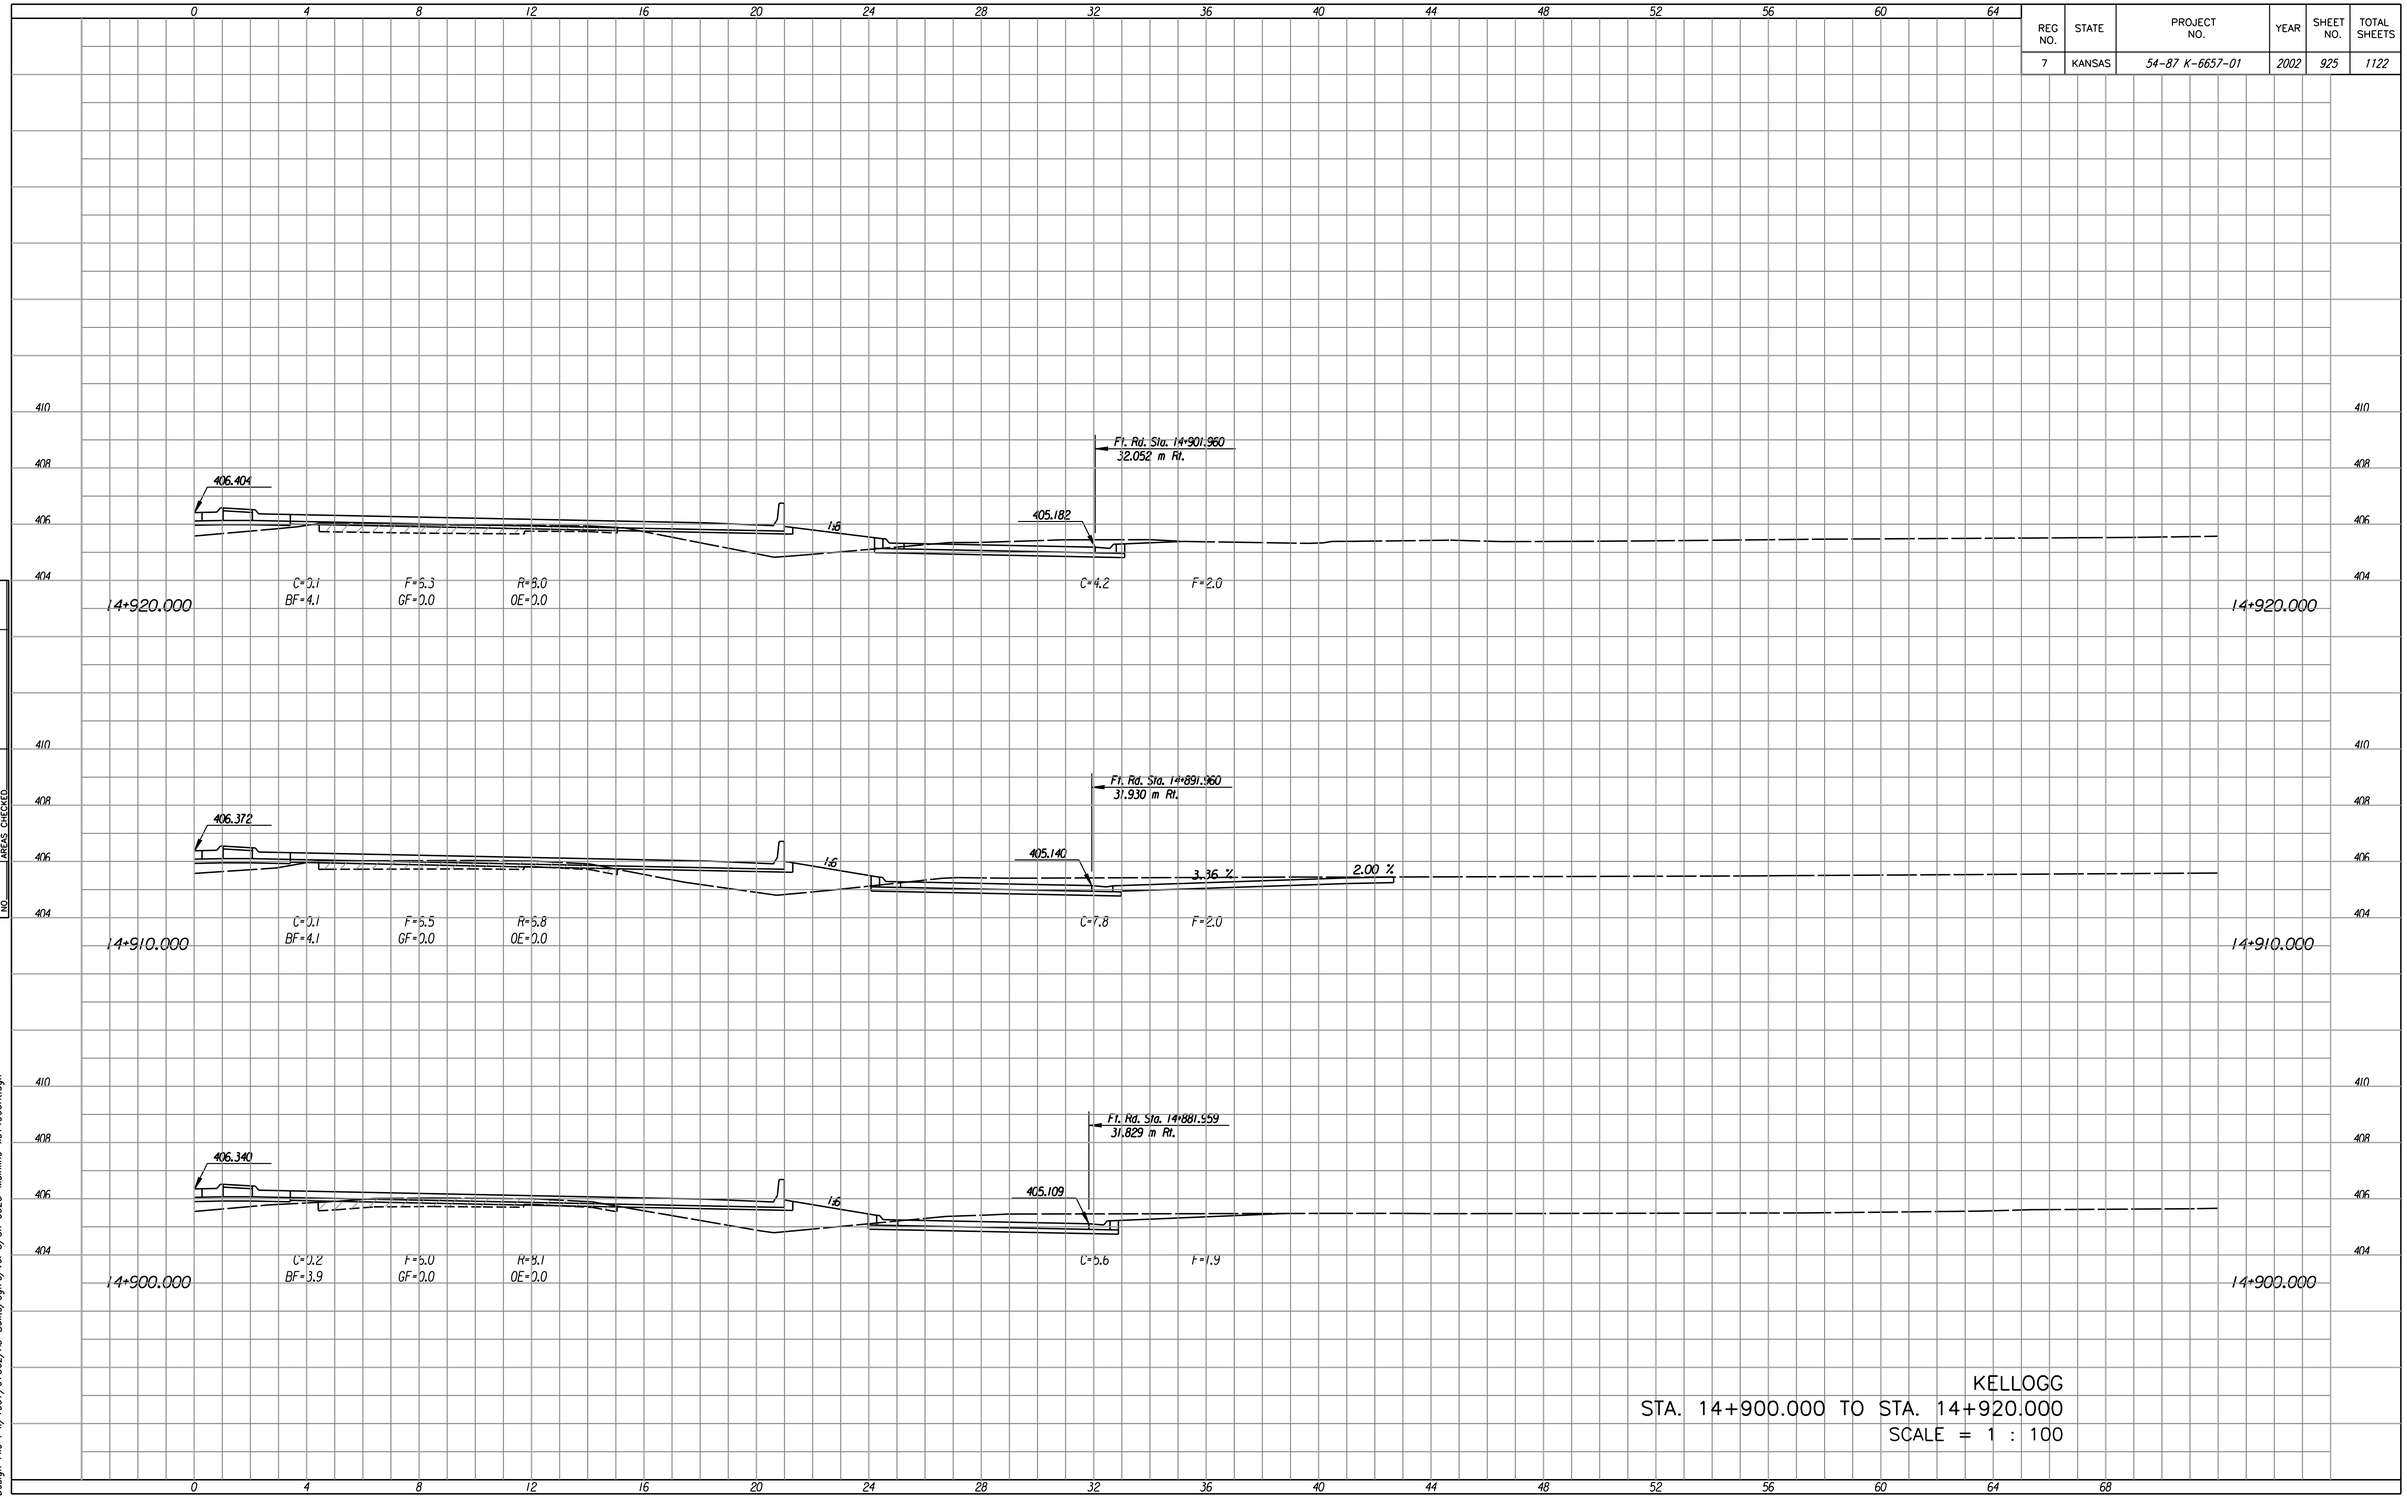

KELLOGG
STA. 14+900.000 TO STA. 14+920.000
SCALE = 1 : 100

FINAL SURVEY	DATE	BY
SURVEYED		
PLOTTED		
NOTE BOOK		
TAB NOTE		
AREAS		
NO. AREAS CHECKED		

Last Rev. : 10-12-07 By: gdr
Scale : 100
Design File : t:/1997/97362/As-Builts/dgn's/Vol 5/Sh 0925-Mainline-xs14900Rt.dgn