| REG NO. | STATE | PROJECT NO. | YEAR | SHEET NO. | TOTAL SHEETS |
|---|---|---|---|---|---|
| 7 | KANSAS | 54-87 K-6657-01 | 2002 | 931 | 1122 |

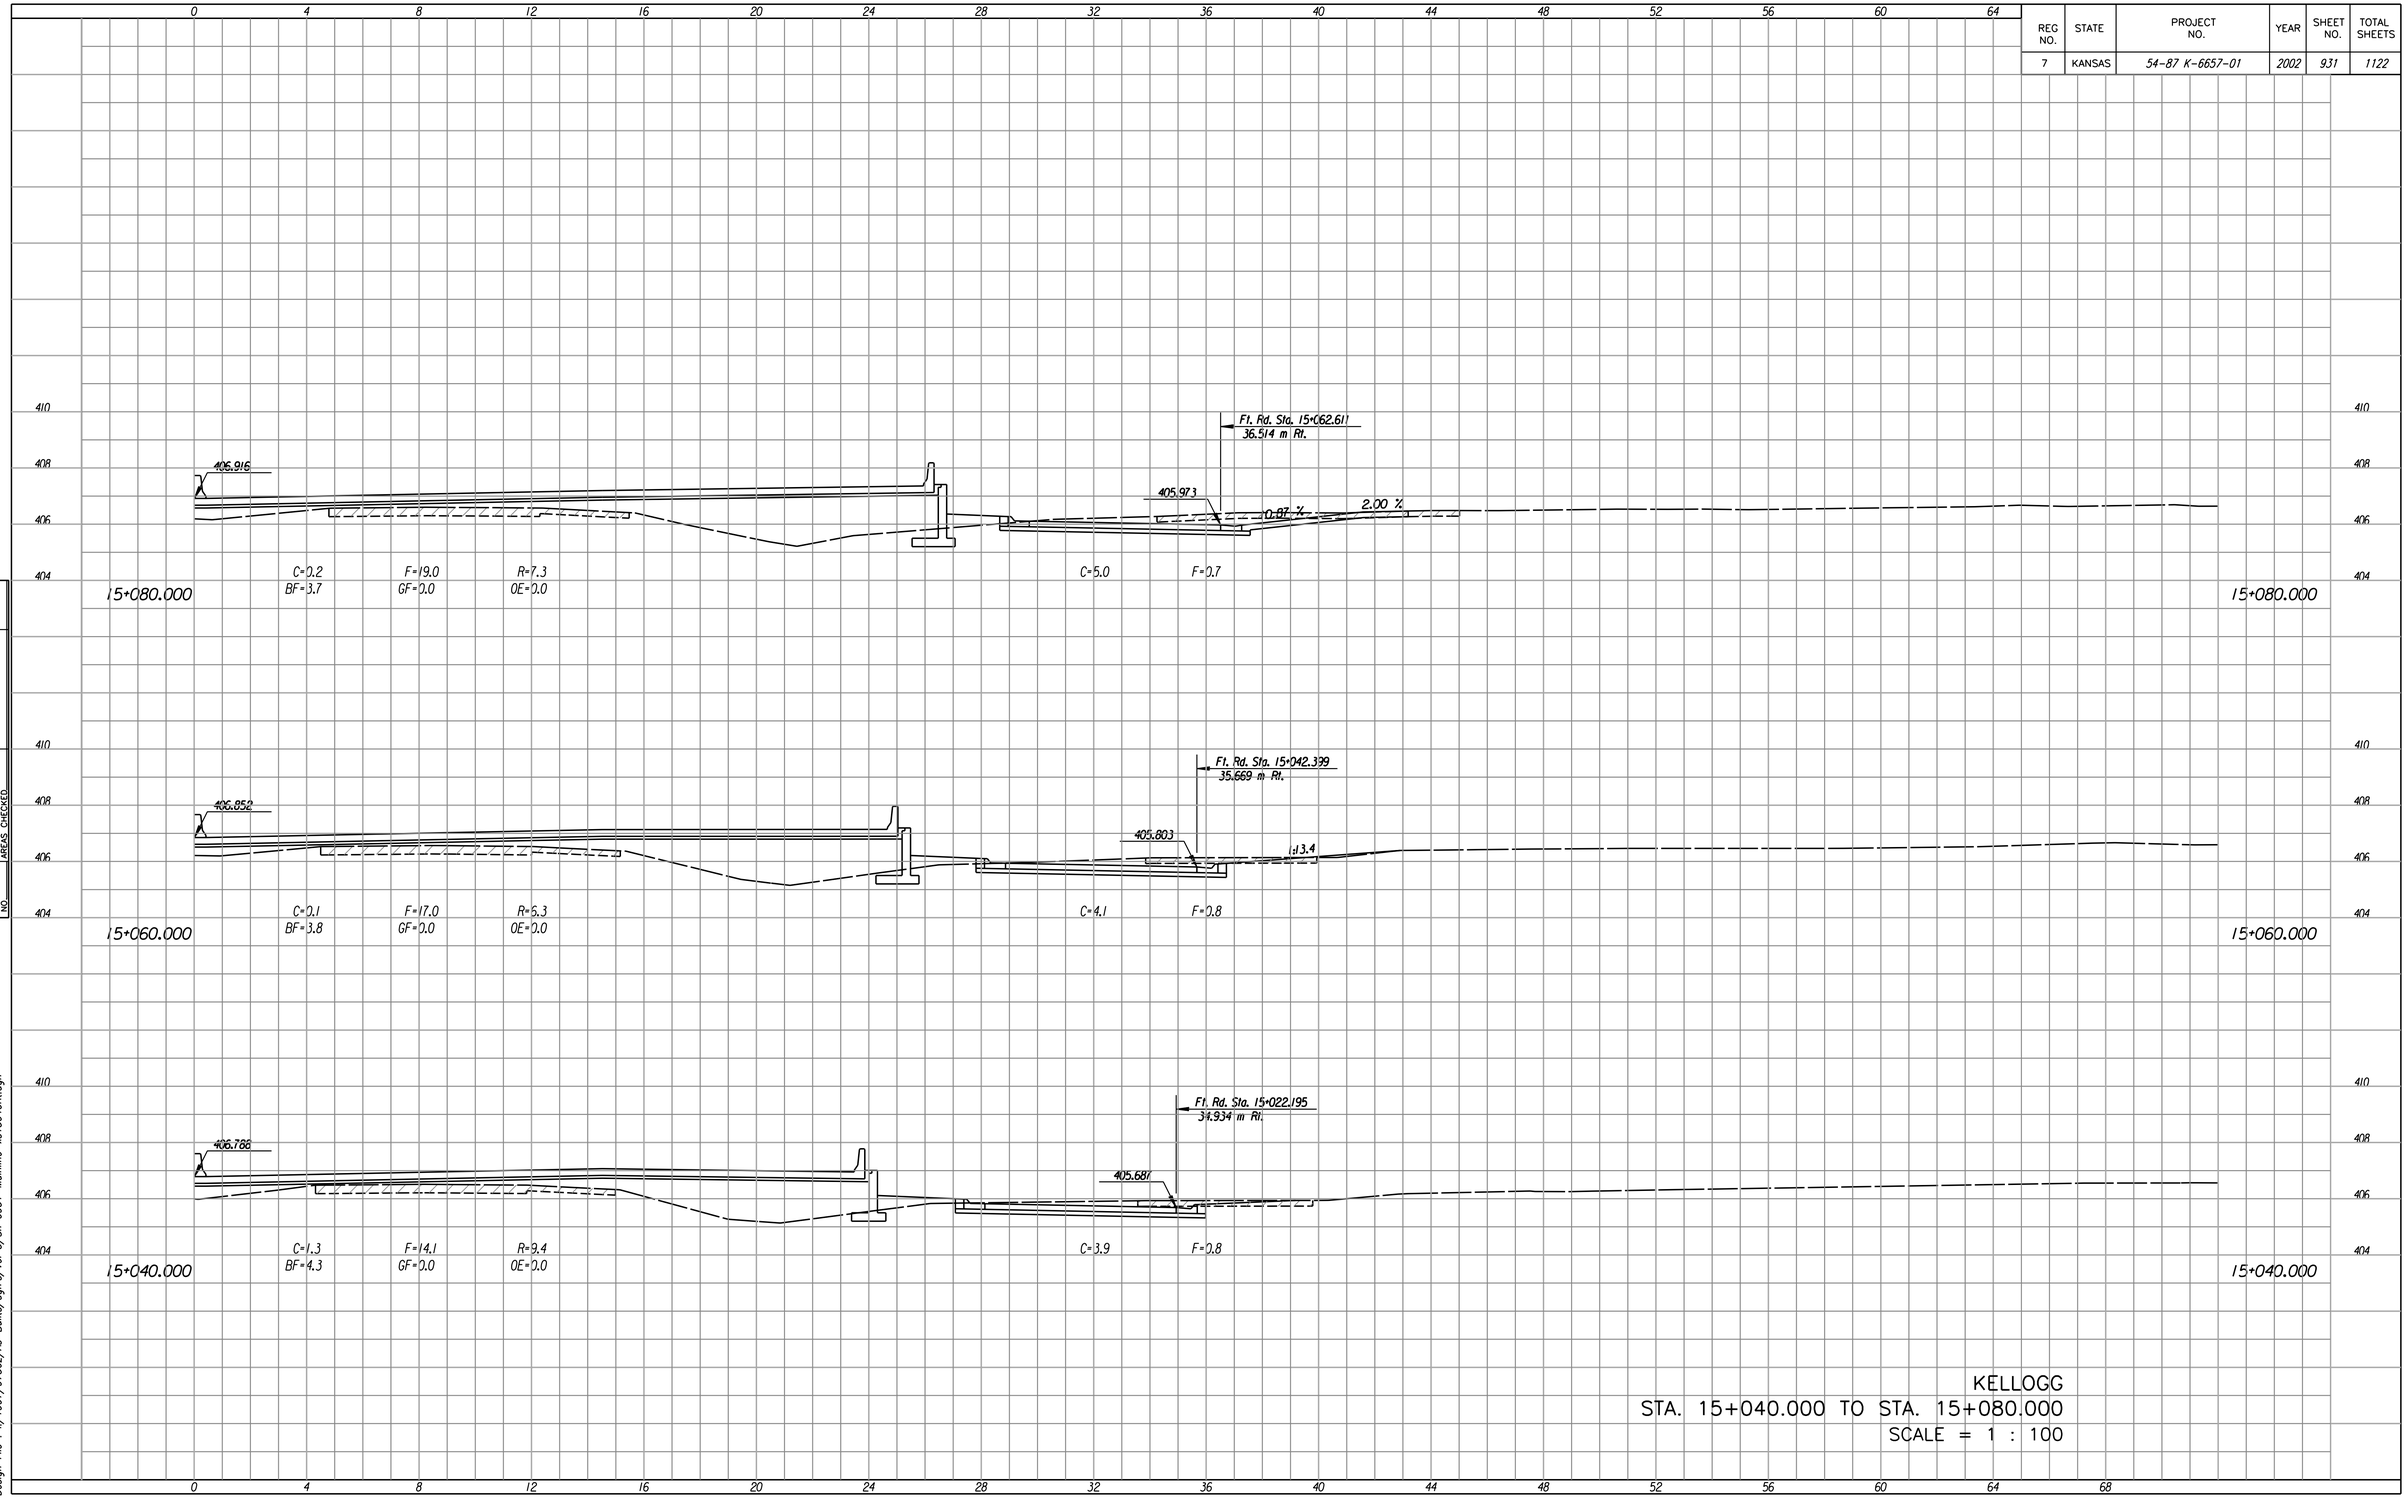


KELLOGG
STA. 15+040.000 TO STA. 15+080.000
SCALE = 1 : 100

| NO. | BY | DATE |
|---|---|---|
| AREAS CHECKED | | |
| AREAS WRITTEN | | |
| PLOTTED | | |
| SURVEYED | | |
| FINAL SURVEY | | |
| NOTE BOOK | | |

Last Rev. : 10-12-07 By: gdr
Scale : 100
Design File : t:/1997/97362/As-Builts/dgns/Vol 5/Sh 0931-Mainline-xs15040Rt.dgn