REG NO.	STATE	PROJECT NO.	YEAR	SHEET NO.	TOTAL SHEETS
7	KANSAS	54-87 K-6657-01	2002	949	1122

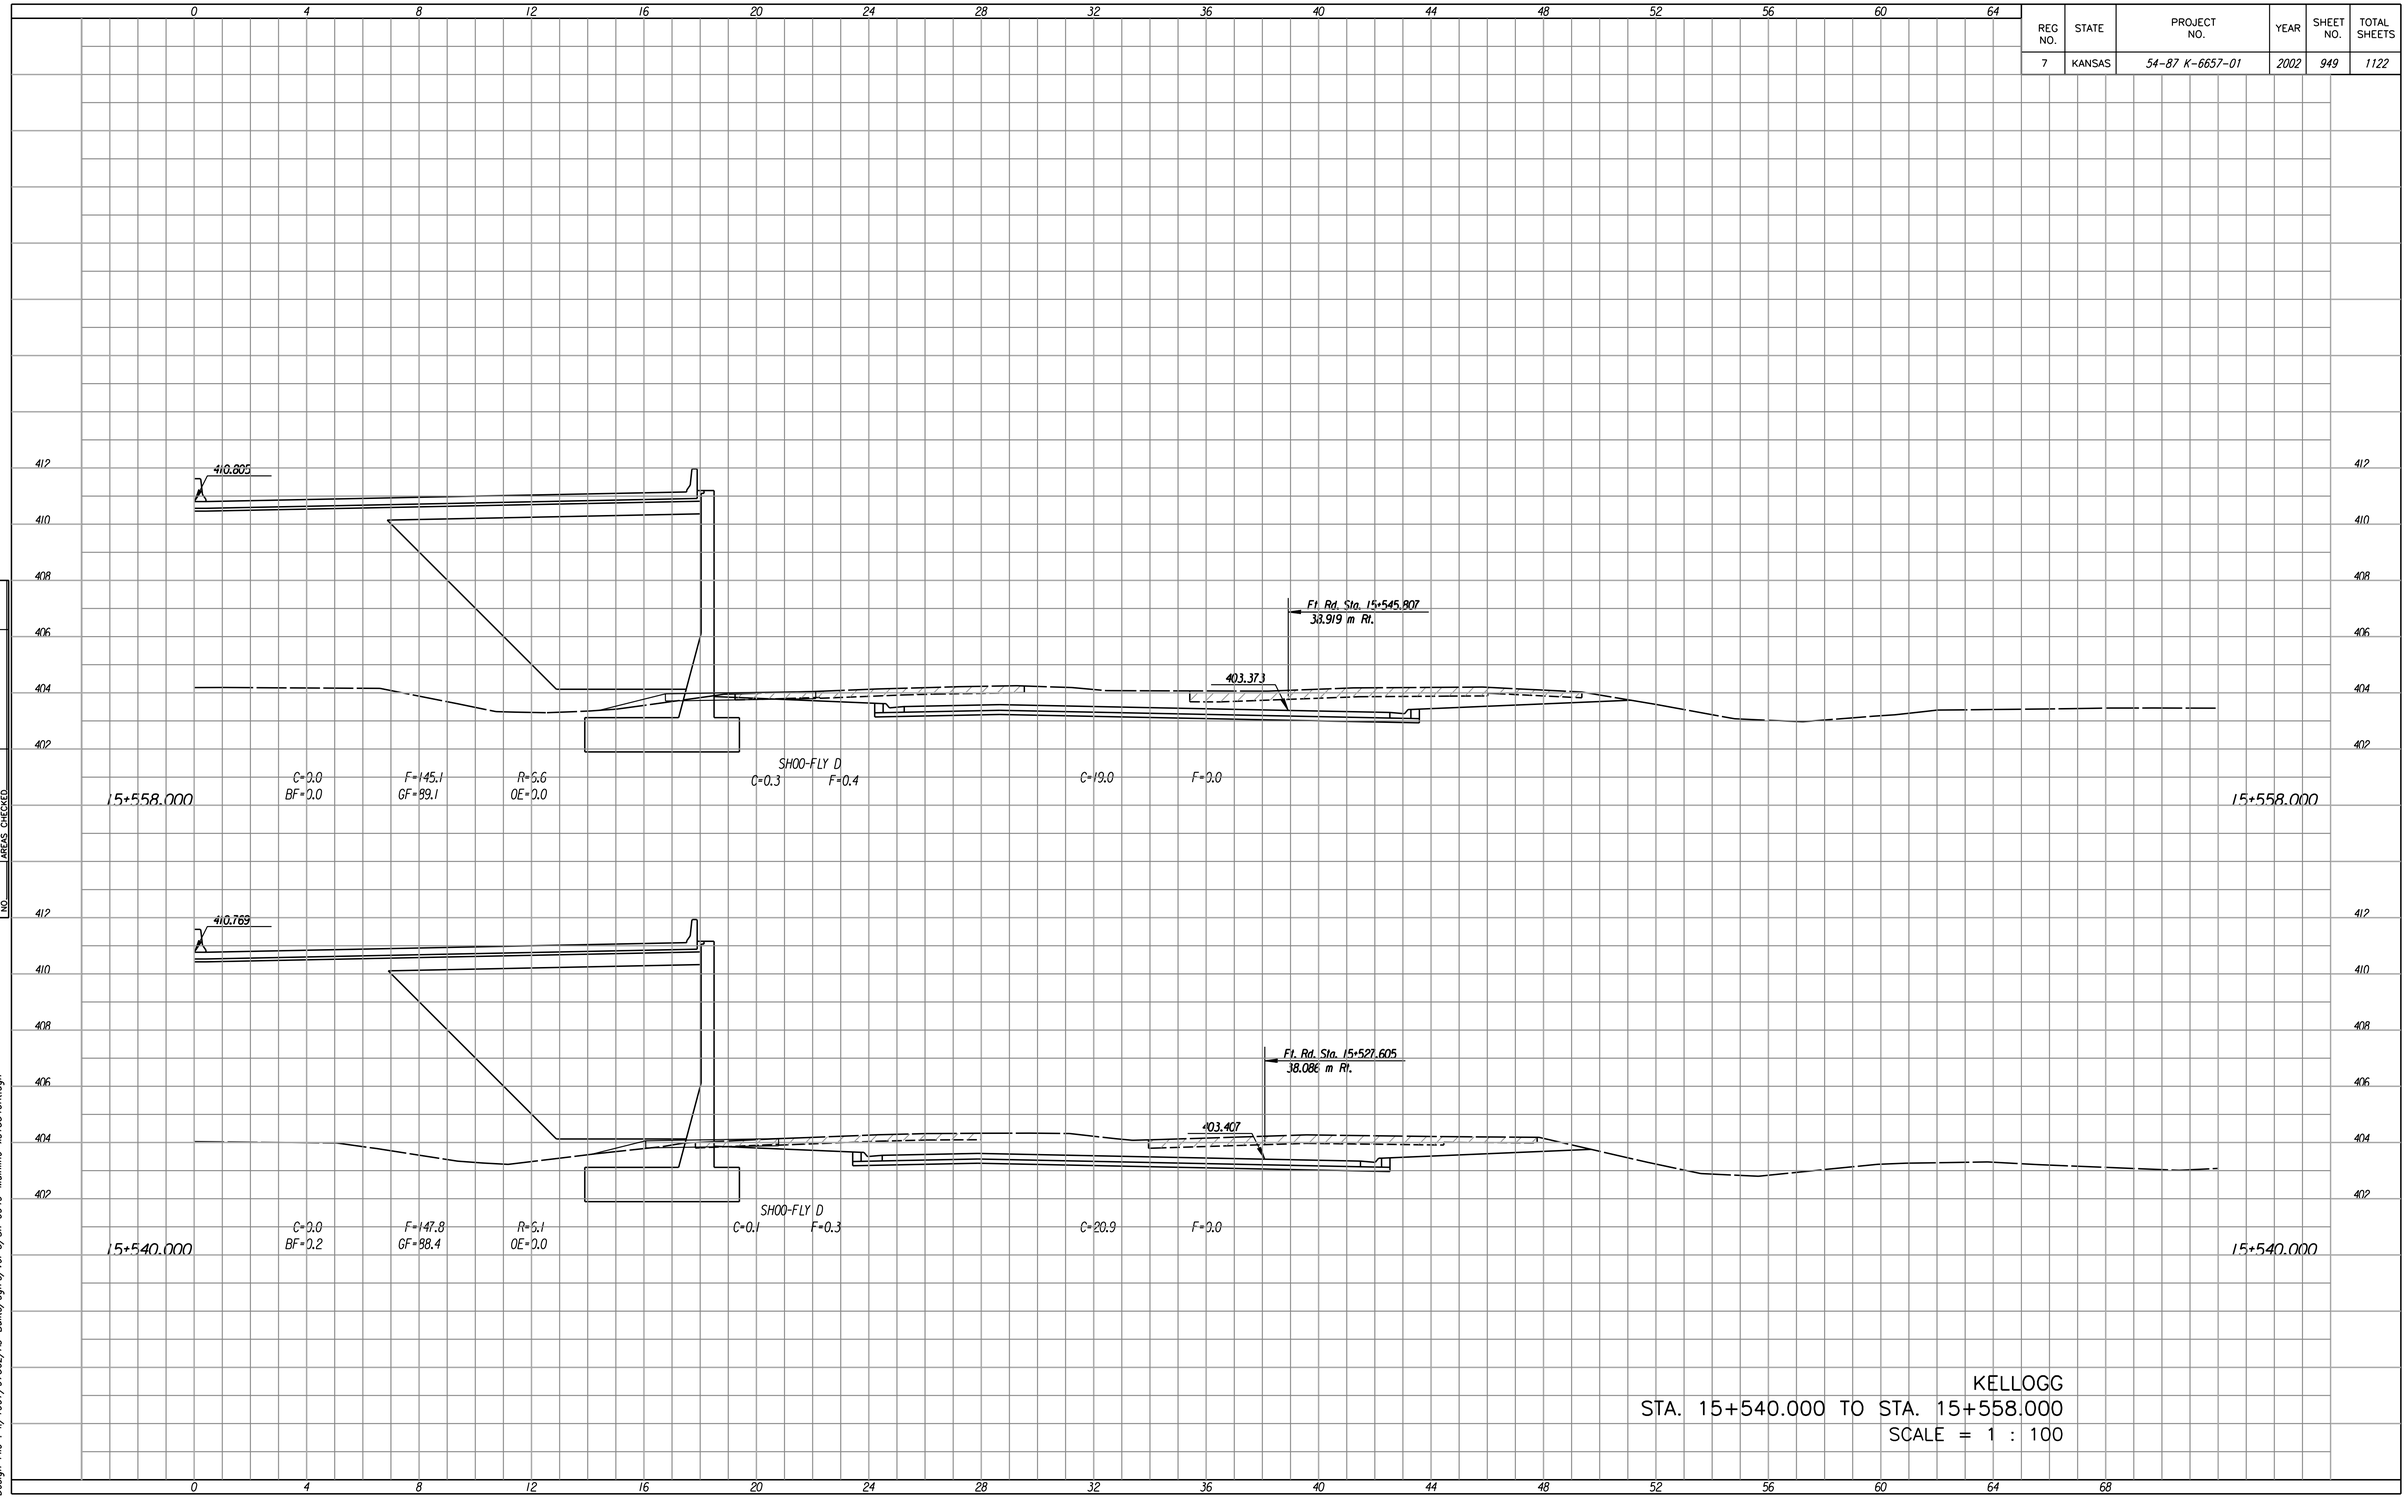

KELLOGG
STA. 15+540.000 TO STA. 15+558.000
SCALE = 1 : 100

FINAL SURVEY	
NOTE BOOK	SURVEYED
	PLOTTED
	DIGITIZE
	AREAS
NO.	AREAS CHECKED

DATE	BY

Last Rev. : 10-12-07 By: gdr
Scale : 100
Design File : I:/1997/97362/As-Builts/dgn's/Vol 5/Sh 0949-Mainline-xs15540Rt.dgn