


REG. NO.	STATE	PROJECT NO.	YEAR	SHEET NO.	TOTAL SHEETS
7	KANSAS	54-87 K-6657-01	2002	955	1122

FINAL SURVEY NO.	DATE
SURVEYED	
PLOTTED	
TEMPLATE	
AREAS	
CHECKED	

Last Rev : 10-12-07 By: gdr
 Scale : 100
 Design File : I:\1997\97362\ls-Builds\ dgn\ Vol 5\Sh 0955-Mainline-x515740Pl.dgn

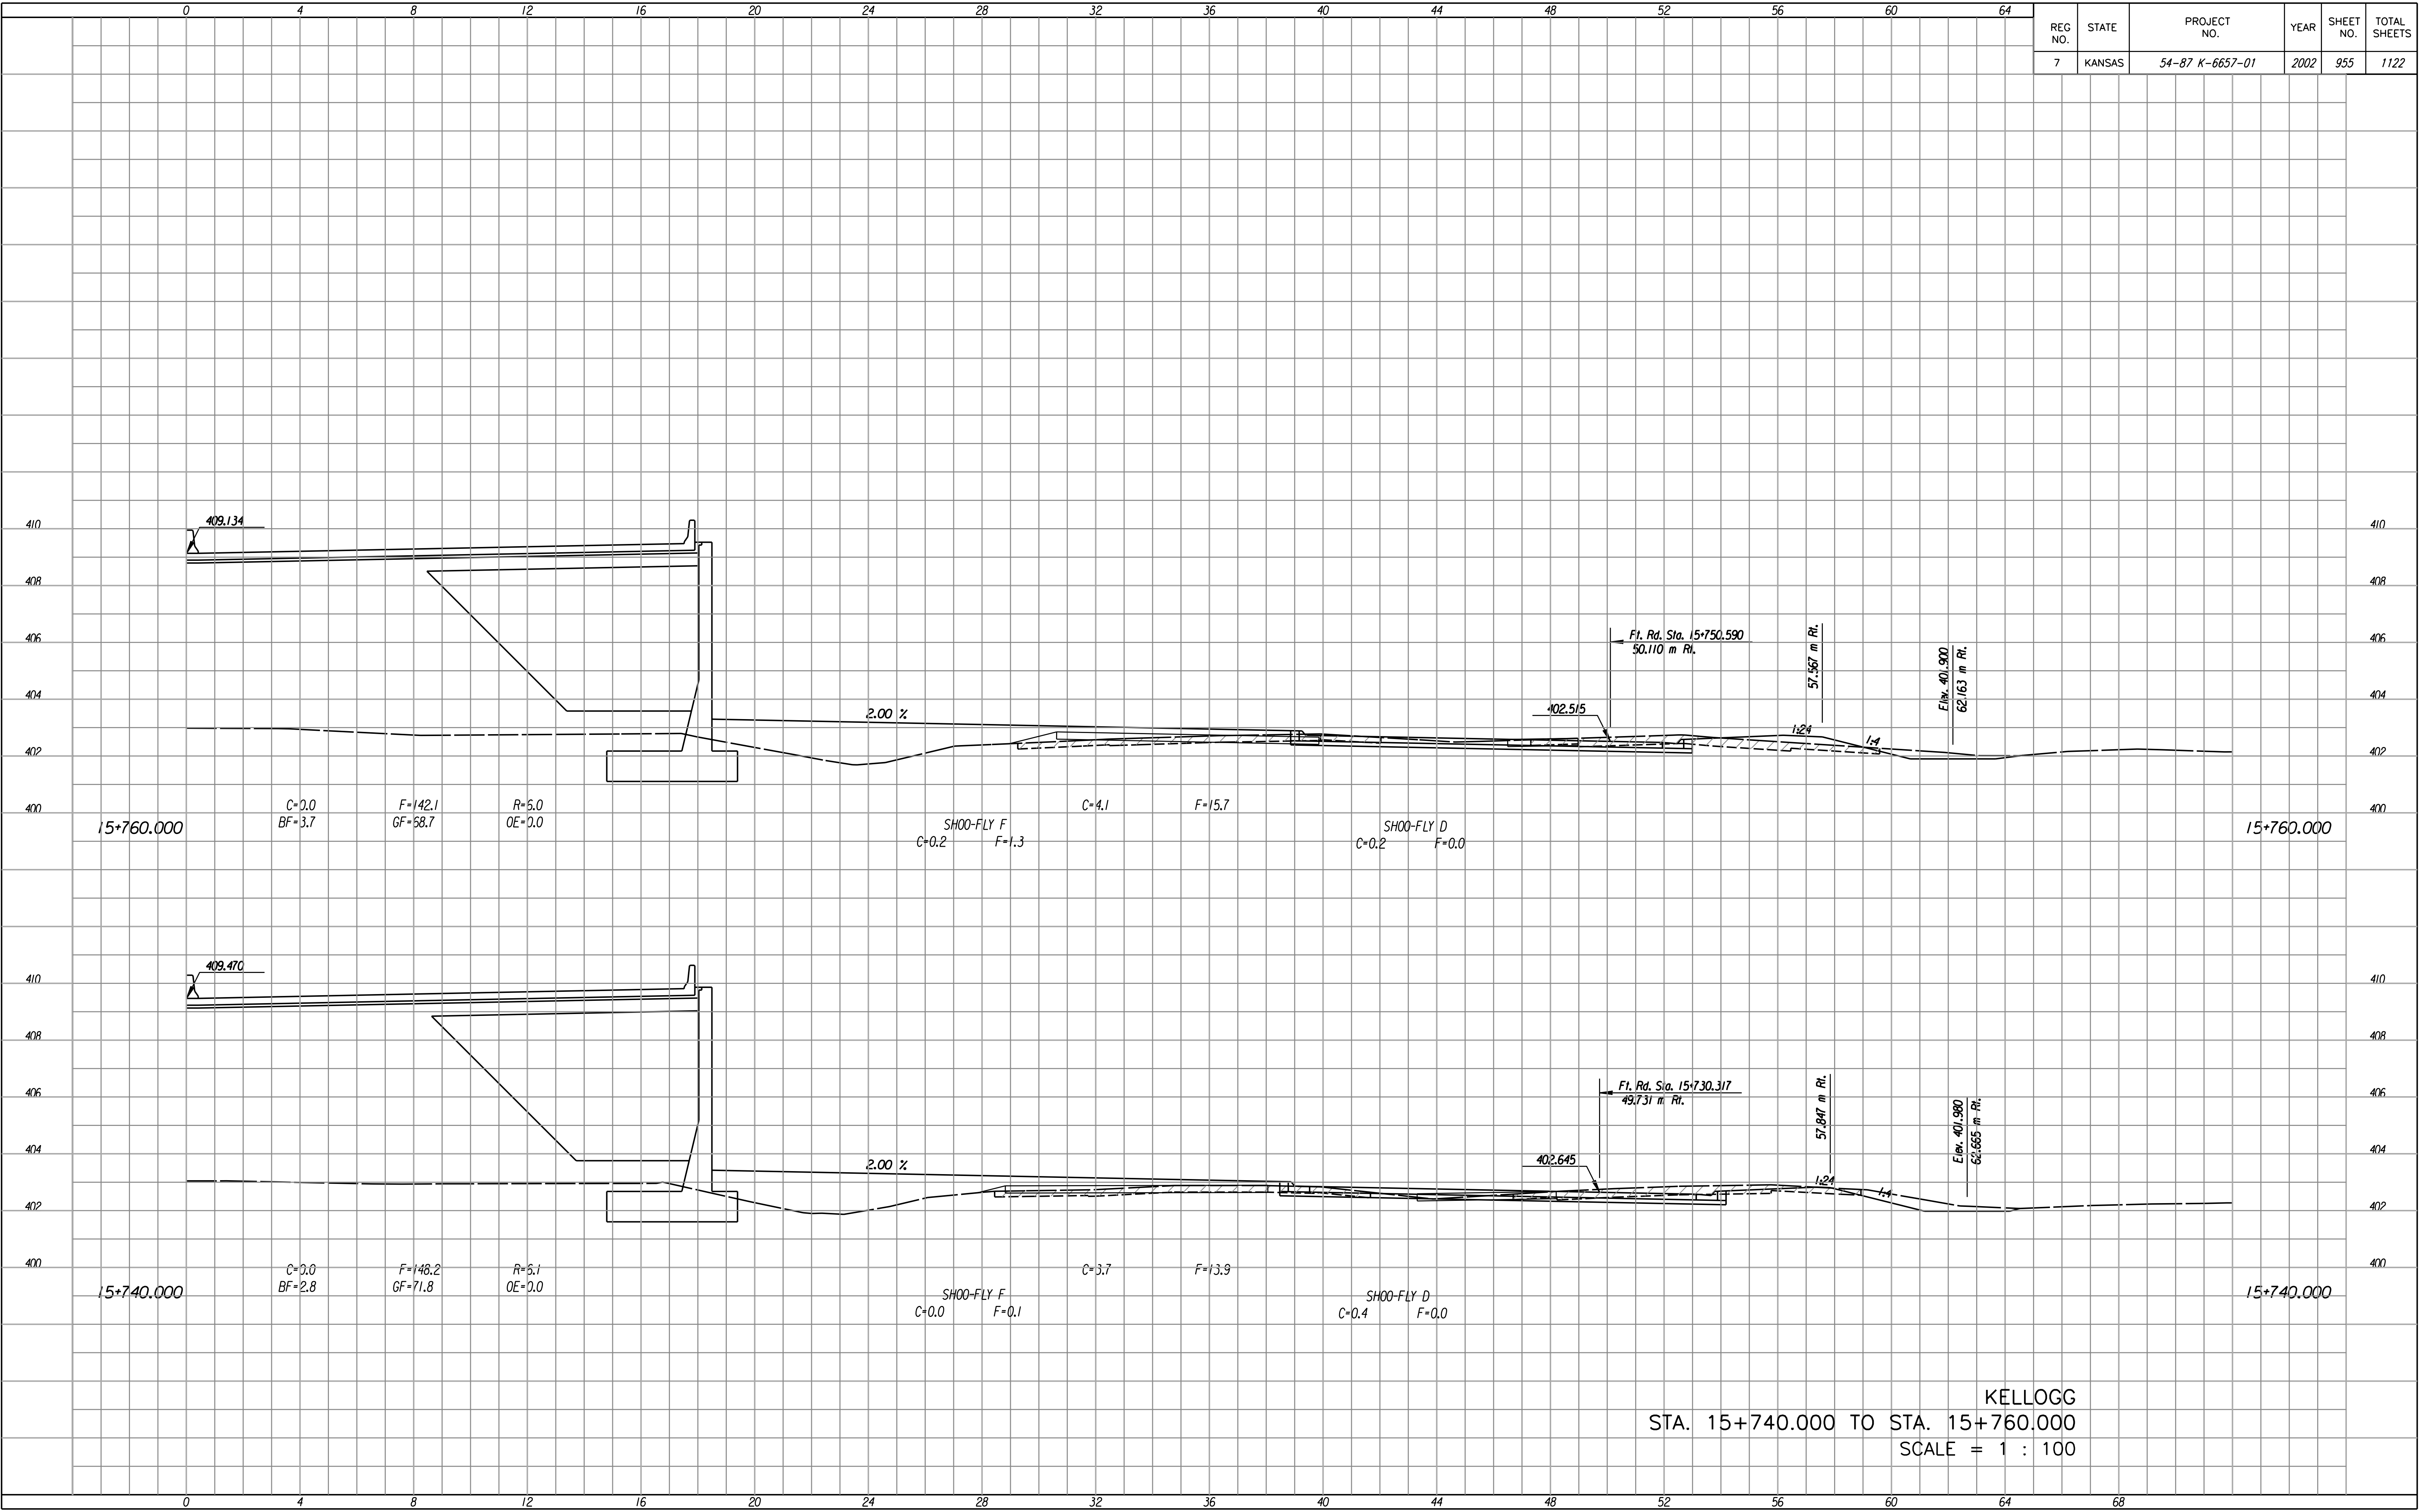

KELLOGG
 STA. 15+740.000 TO STA. 15+760.000
 SCALE = 1 : 100