| REG NO. | STATE | PROJECT NO. | YEAR | SHEET NO. | TOTAL SHEETS |
|---|---|---|---|---|---|
| 7 | KANSAS | 54-87 K-6657-01 | 2002 | 974 | 1122 |

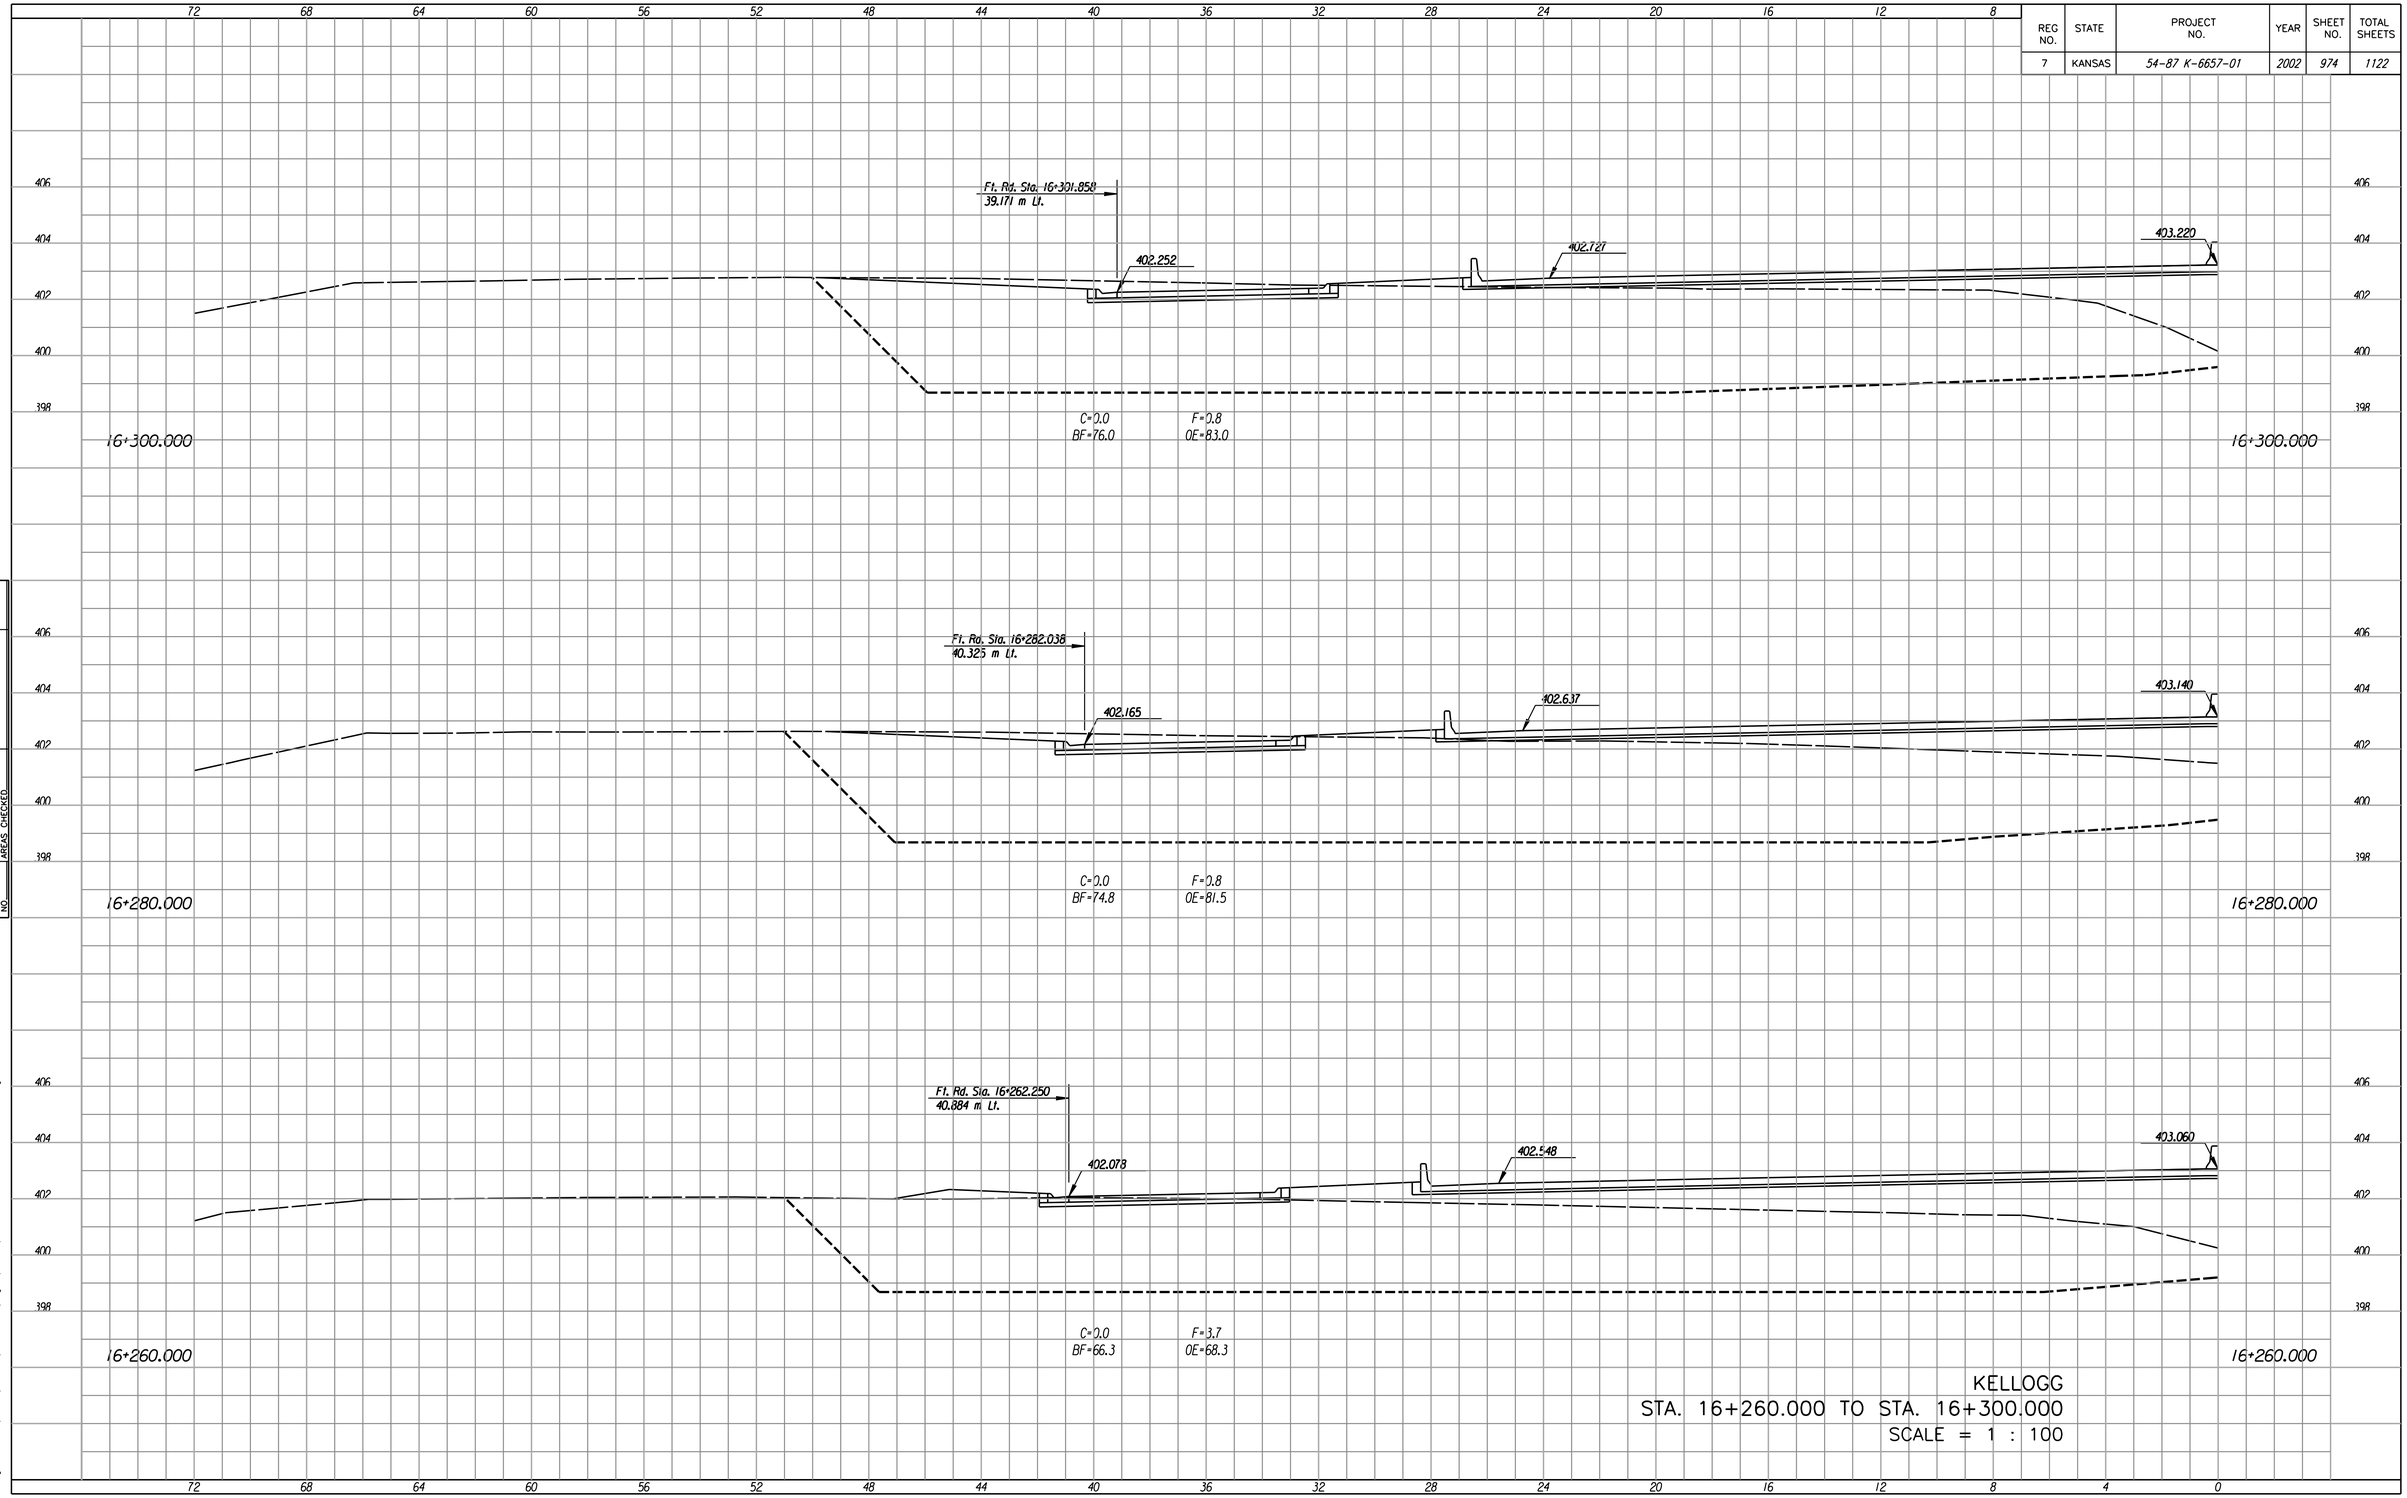


KELLOGG
STA. 16+260.000 TO STA. 16+300.000
SCALE = 1 : 100

| FINAL SURVEY | | BY | DATE |
|---|---|---|---|
| | SURVEYED | | |
| | PLOTTED | | |
| NOTE BOOK | PLANIMETER | | |
| | AREAS | | |
| NO. | AREAS CHECKED | | |

Last Rev. : 10-12-07 By: gdr
Scale : 100
Design File : I:/1997/97362/As-Builts/dgn's/Vol 5/Sh 0974-Mainline-xs162800l.dgn