REG NO.	STATE	PROJECT NO.	YEAR	SHEET NO.	TOTAL SHEETS
7	KANSAS	54-87 K-6657-01	2002	979	1122

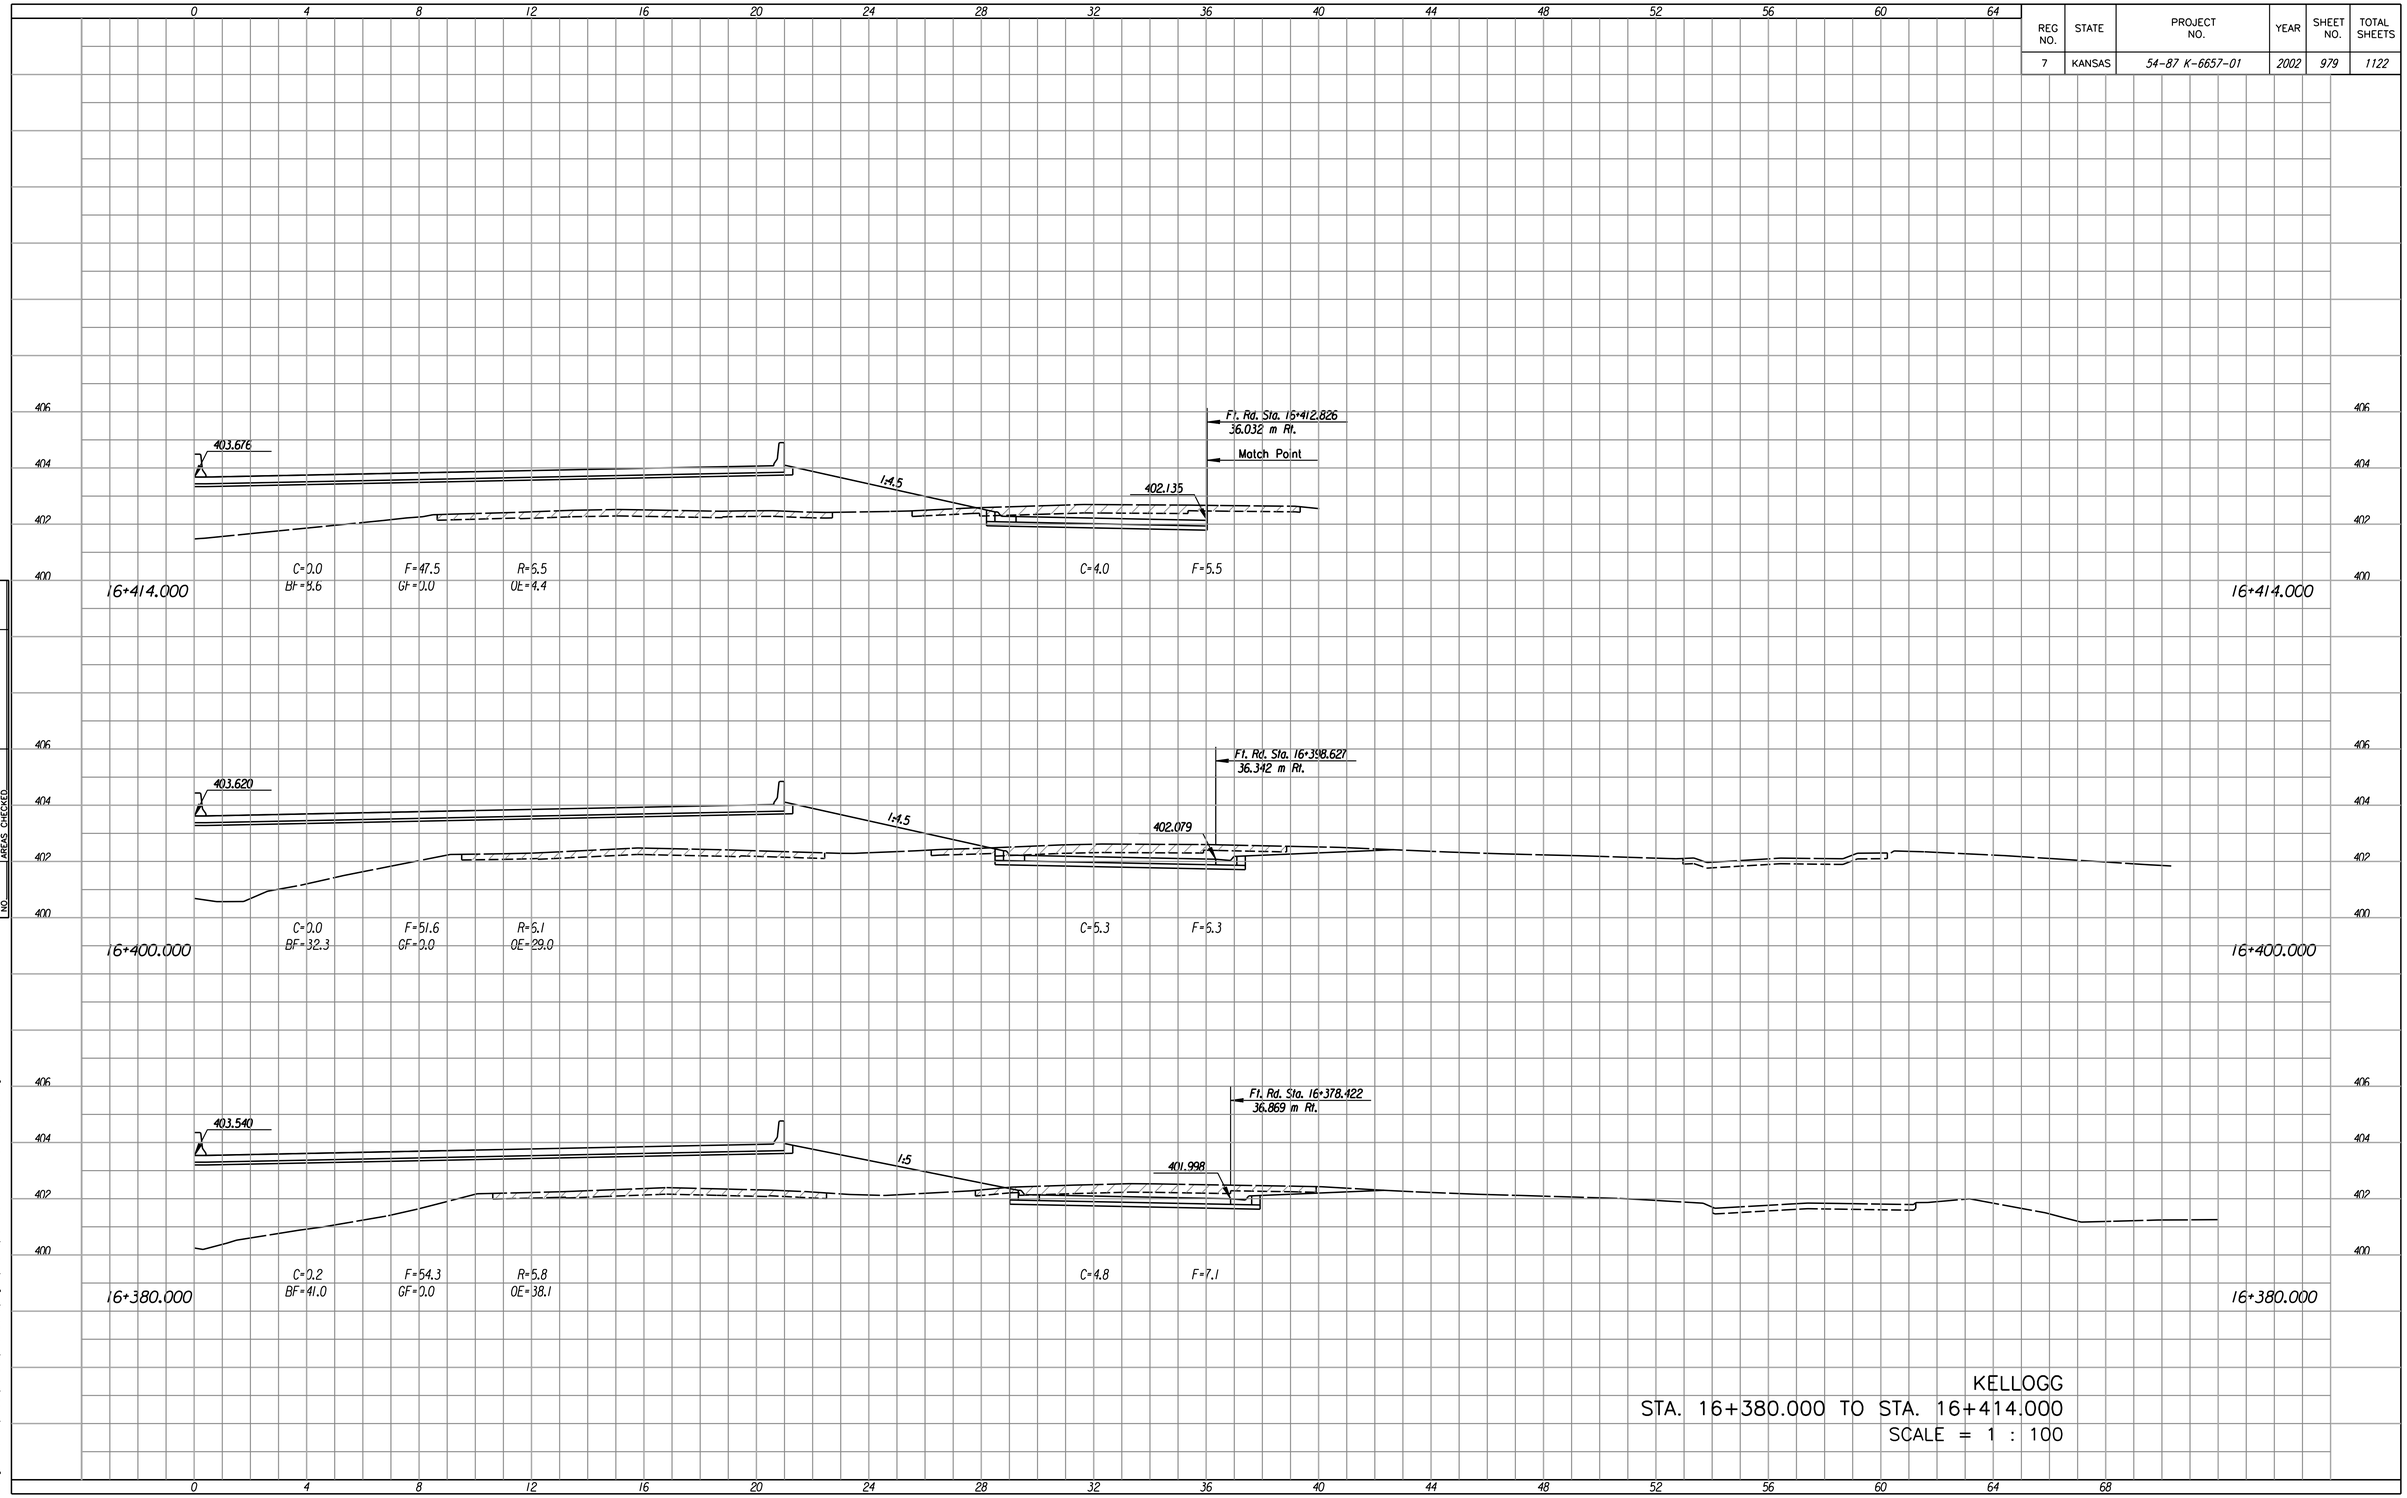

FINAL SURVEY			
	SURVEYED		
	PLOTTED		
NOTE BOOK	PLOT DATE		
	AREAS		
NO.	AREAS CHECKED	BY	DATE

Last Rev. : 10-12-07 By: gdr
Scale : 100
Design File : I:/1997/97362/As-Builts/dgn's/Vol 5/Sh 0979-Mainline-xs16380Rt.dgn