REG NO.	STATE	PROJECT NO.	YEAR	SHEET NO.	TOTAL SHEETS
7	KANSAS	54-87 K-6657-01	2002	980	1122

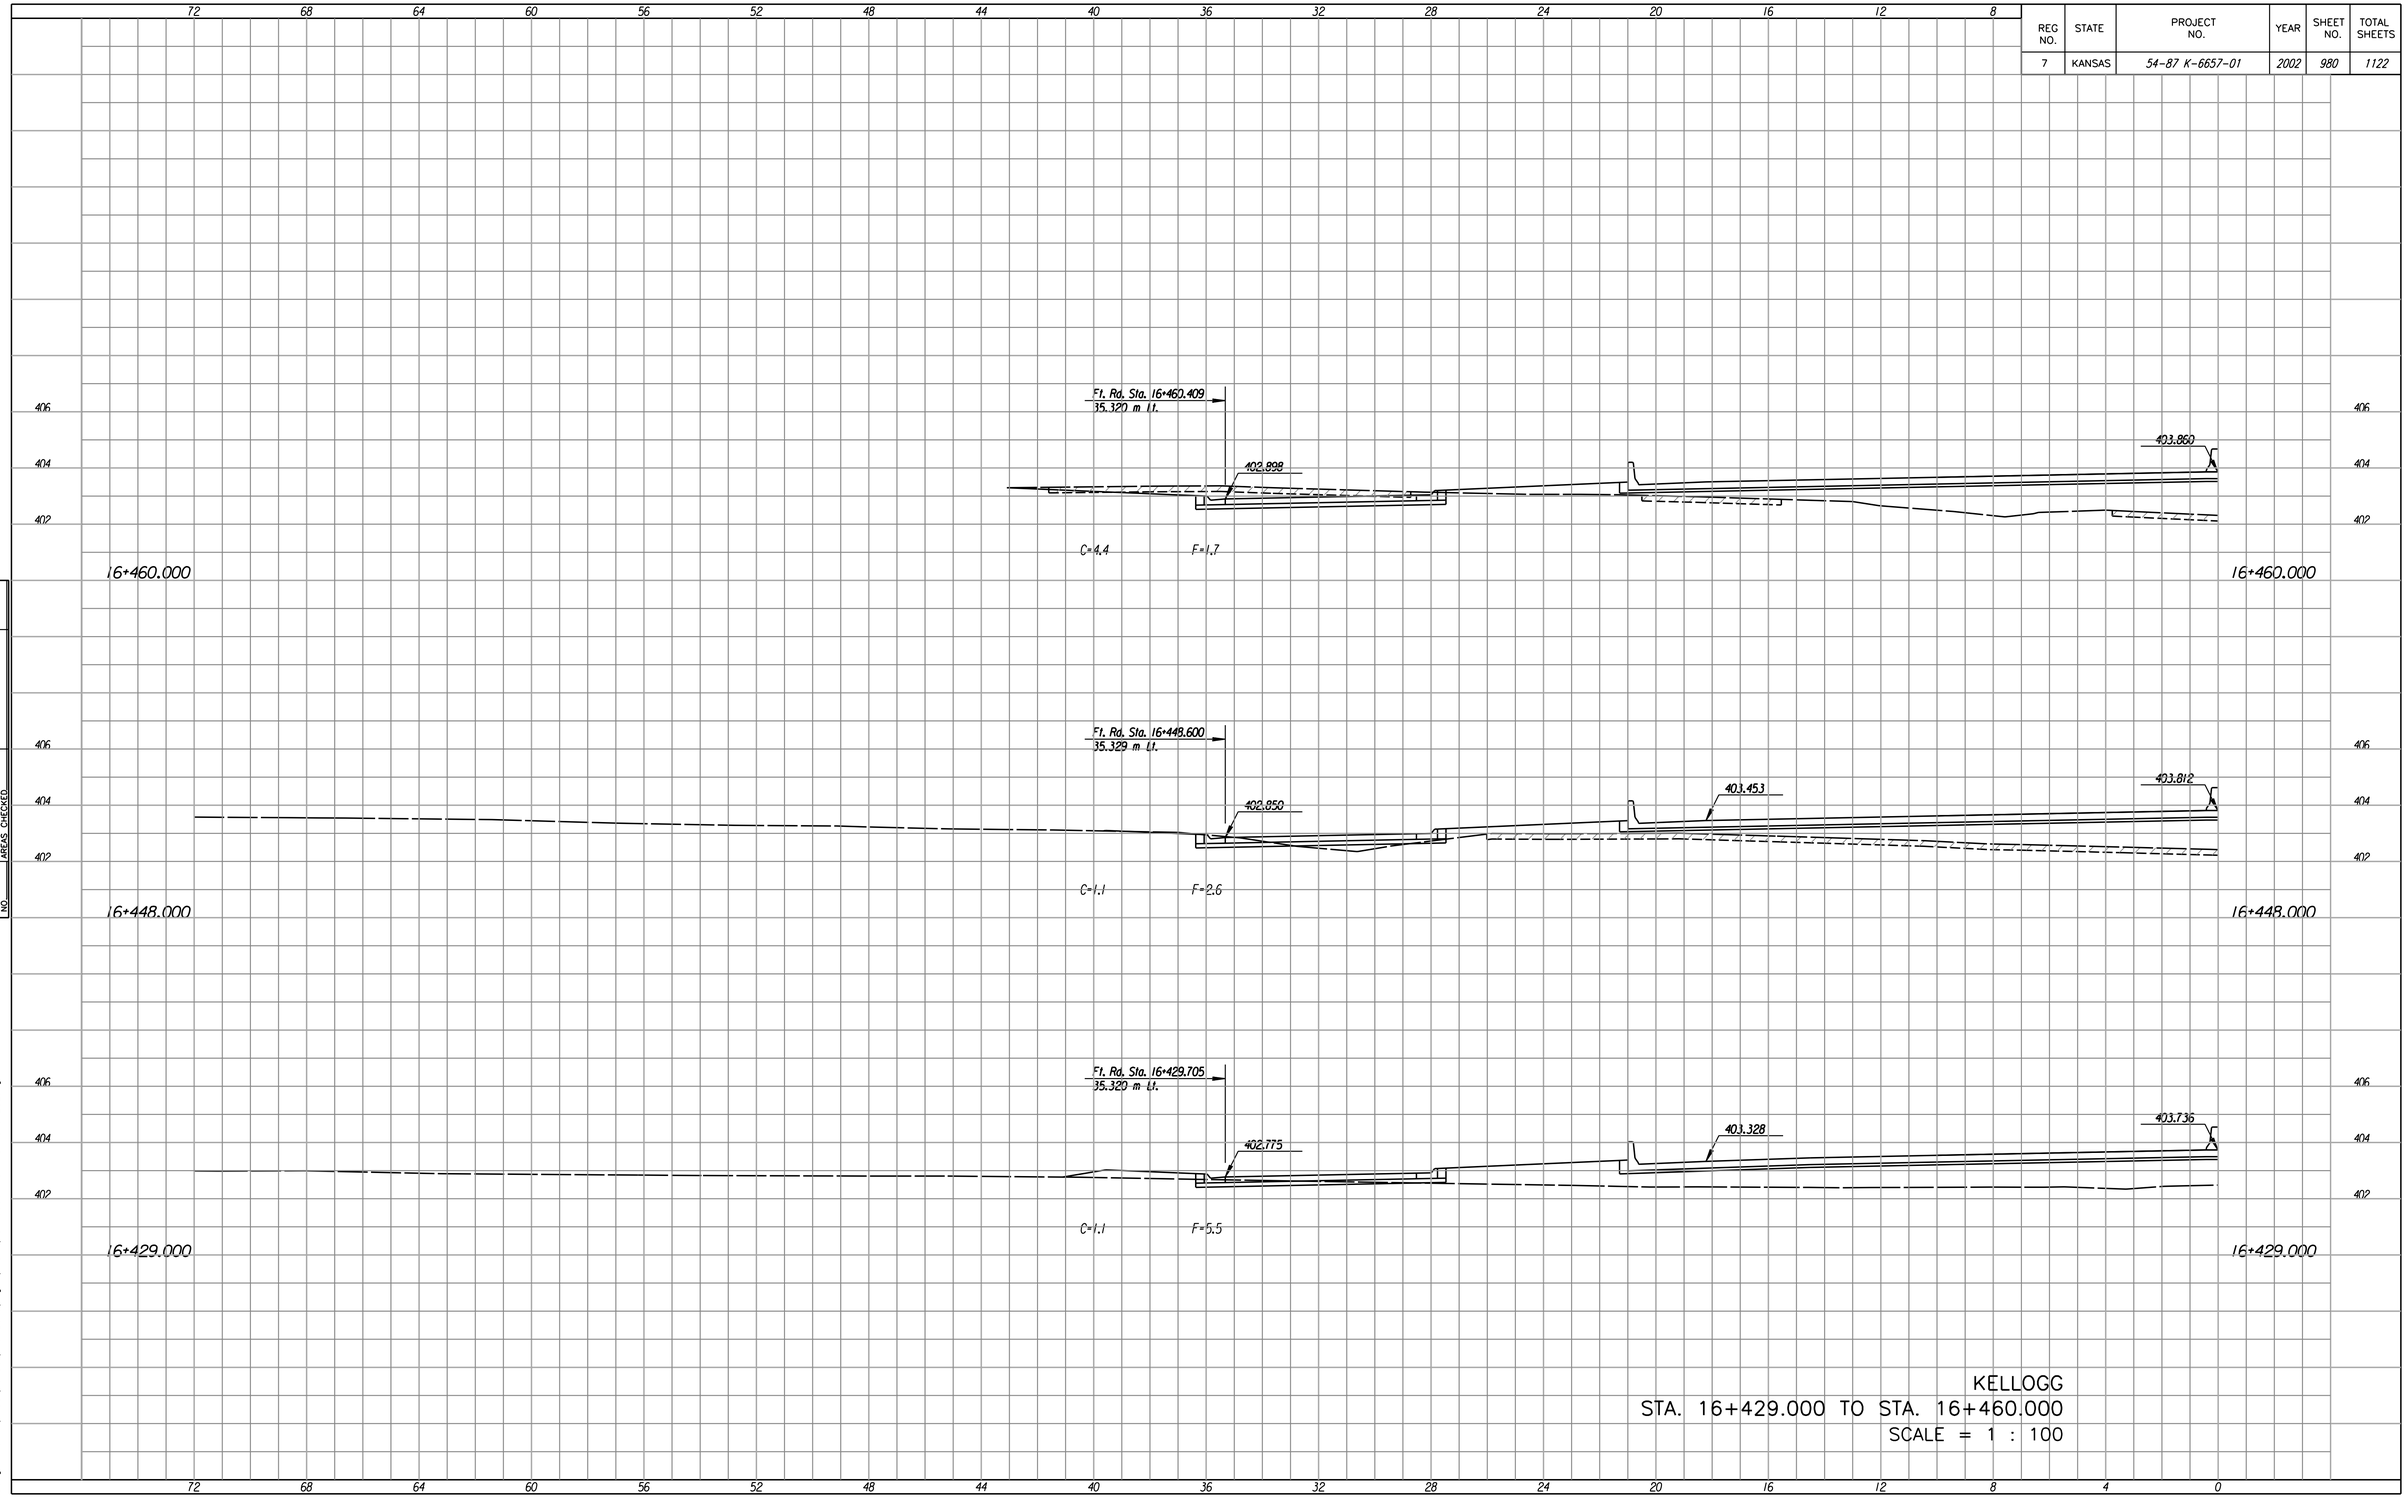

KELLOGG
STA. 16+429.000 TO STA. 16+460.000
SCALE = 1 : 100

NO.	FINAL SURVEY	BY	DATE
	SURVEYED		
	PLOTTED		
	NOTE BOOK	TRACE	
	AREAS		
	AREAS CHECKED		

Last Rev. : 10-12-07 By: gdr
Scale : 100
Design File : I:/1997/97362/As-Builts/dgns/Vol 5/Sh 0980-Mainline-xs164291.dgn