REG NO.	STATE	PROJECT NO.	YEAR	SHEET NO.	TOTAL SHEETS
7	KANSAS	54-87 K-6657-01	2002	983	1122

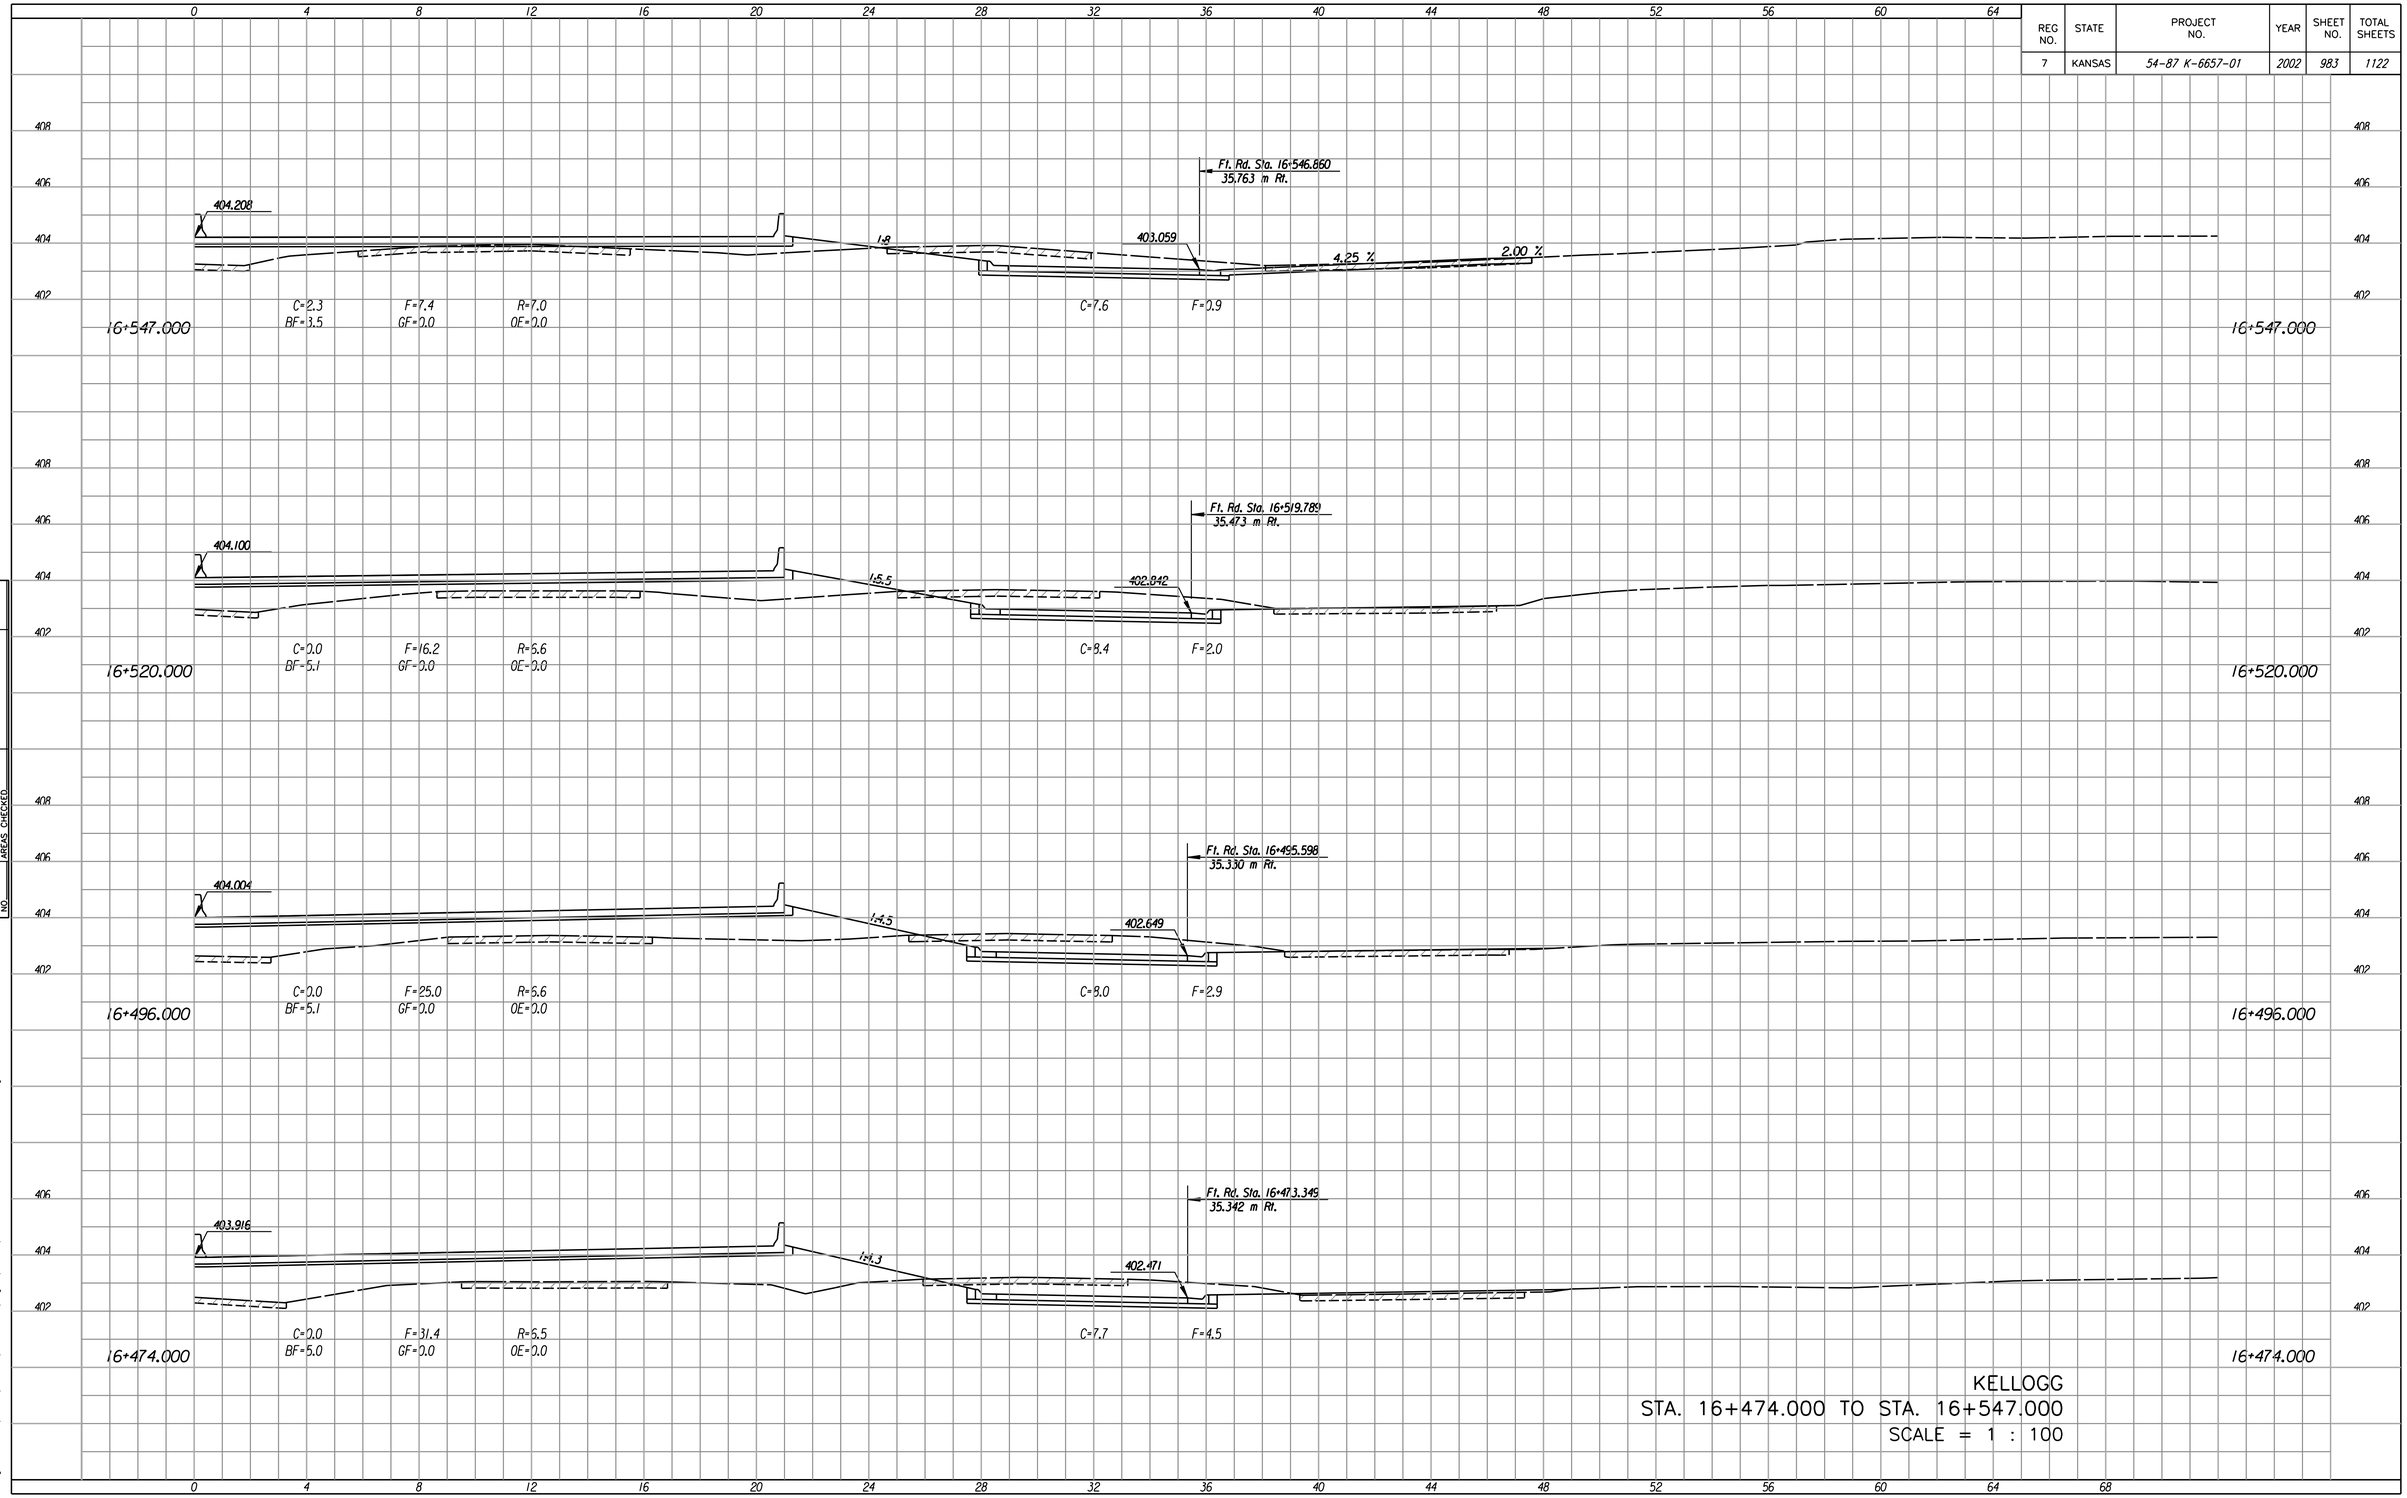

FINAL SURVEY		DATE
	SURVEYED	
	PLOTTED	
NOTE BOOK	ROUTE	
	AREAS	
NO.	AREAS CHECKED	BY

Last Rev. : 10-12-07 By: gdr
Scale : 100
Design File : I:/1997/97362/As-Builts/dgn's/Vol 5/Sh 0983-Mainline-xs16474RI.dgn