REG NO.	STATE	PROJECT NO.	YEAR	SHEET NO.	TOTAL SHEETS
7	KANSAS	54-87 K-6657-01	2002	1028	1122

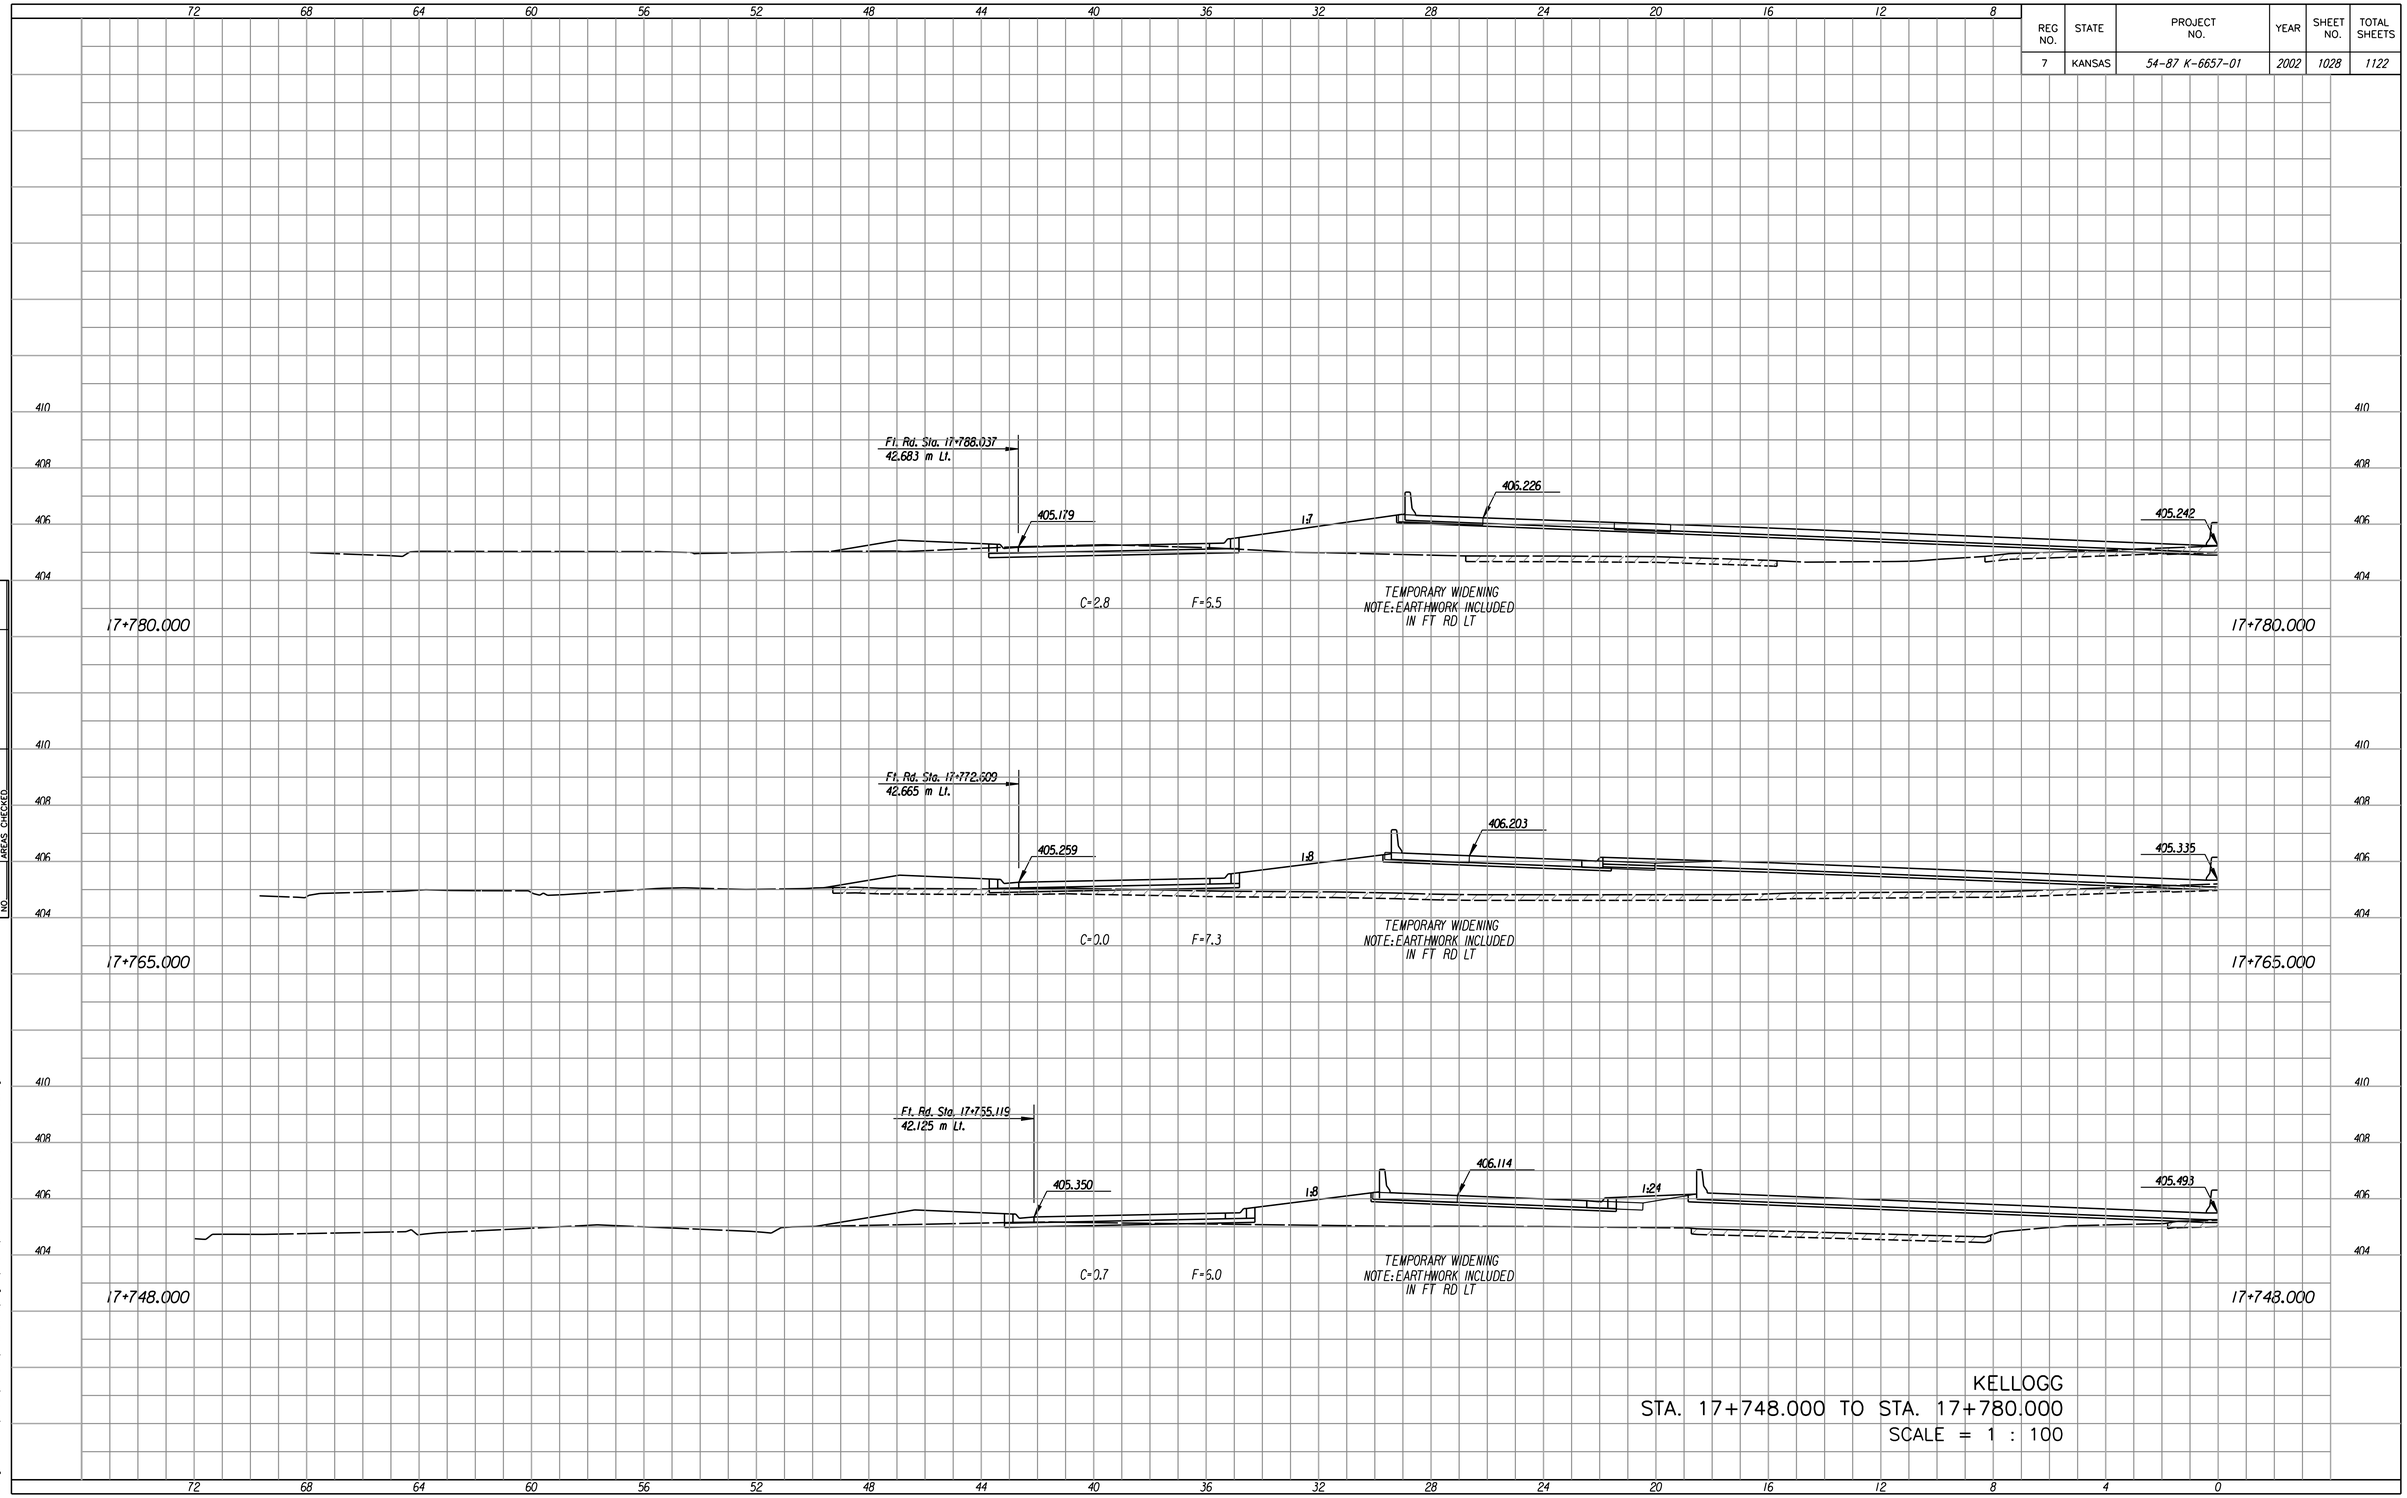

KELLOGG
STA. 17+748.000 TO STA. 17+780.000
SCALE = 1 : 100

FINAL SURVEY		BY	DATE
	SURVEYED		
	PLOTTED		
NOTE BOOK	TRAVERSE		
	AREAS		
NO.	AREAS CHECKED		

Last Rev. : 10-12-07 By: gdr
Scale : 100
Design File : I:/1997/97362/As-Builts/dgn's/Vol 5/Sh 1028-Mainline-xs17748l.dgn