REG NO.	STATE	PROJECT NO.	YEAR	SHEET NO.	TOTAL SHEETS
7	KANSAS	54-87 K-6657-01	2002	1038	1122

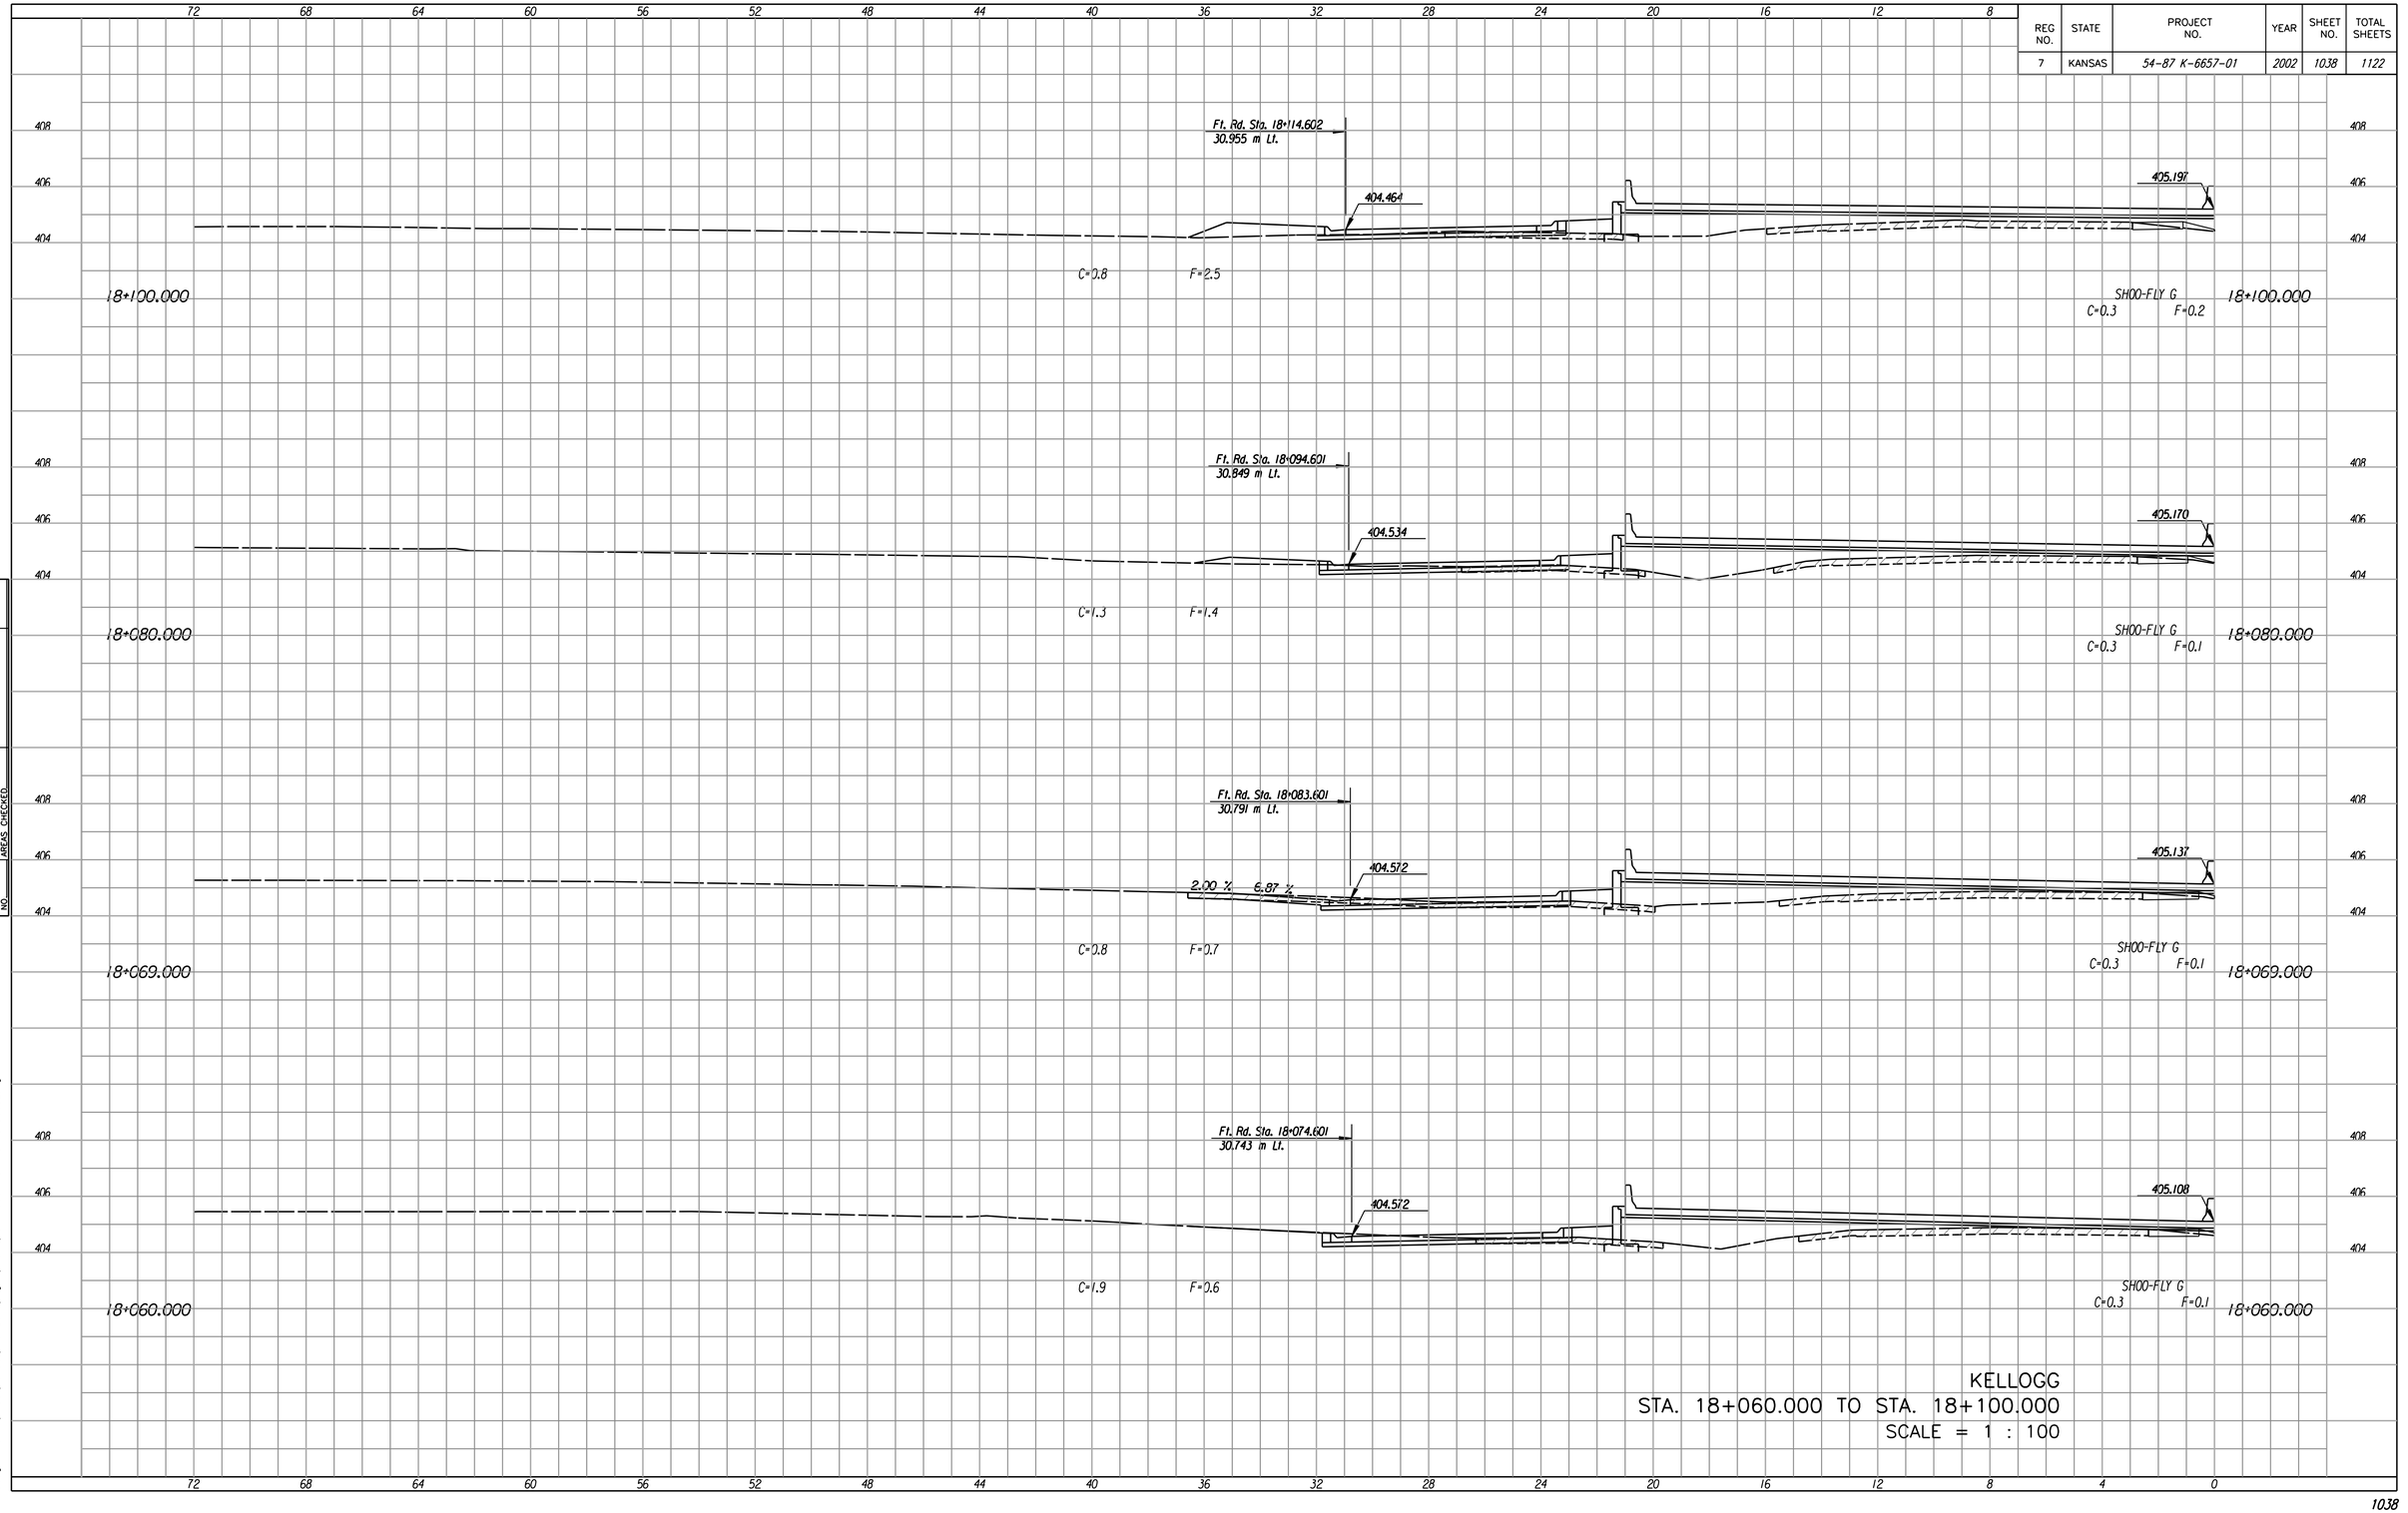

KELLOGG
STA. 18+060.000 TO STA. 18+100.000
SCALE = 1 : 100

FINAL SURVEY	NOTE BOOK	NO.
SURVEYED	PLOTTED	AREAS
PLOTTED	PLOTTED	AREAS CHECKED
DRAWN	DRAWN	
CHECKED	CHECKED	
DATE	DATE	
BY	BY	

Last Rev. : 10-12-07 By: gdr
Scale : 100
Design File : i:/1997/97362/As-Builts/dgn's/Vol 5/Sh 1038-Mainline-xs180801.dgn