REG NO.	STATE	PROJECT NO.	YEAR	SHEET NO.	TOTAL SHEETS
7	KANSAS	54-87 K-6657-01	2002	1047	1122

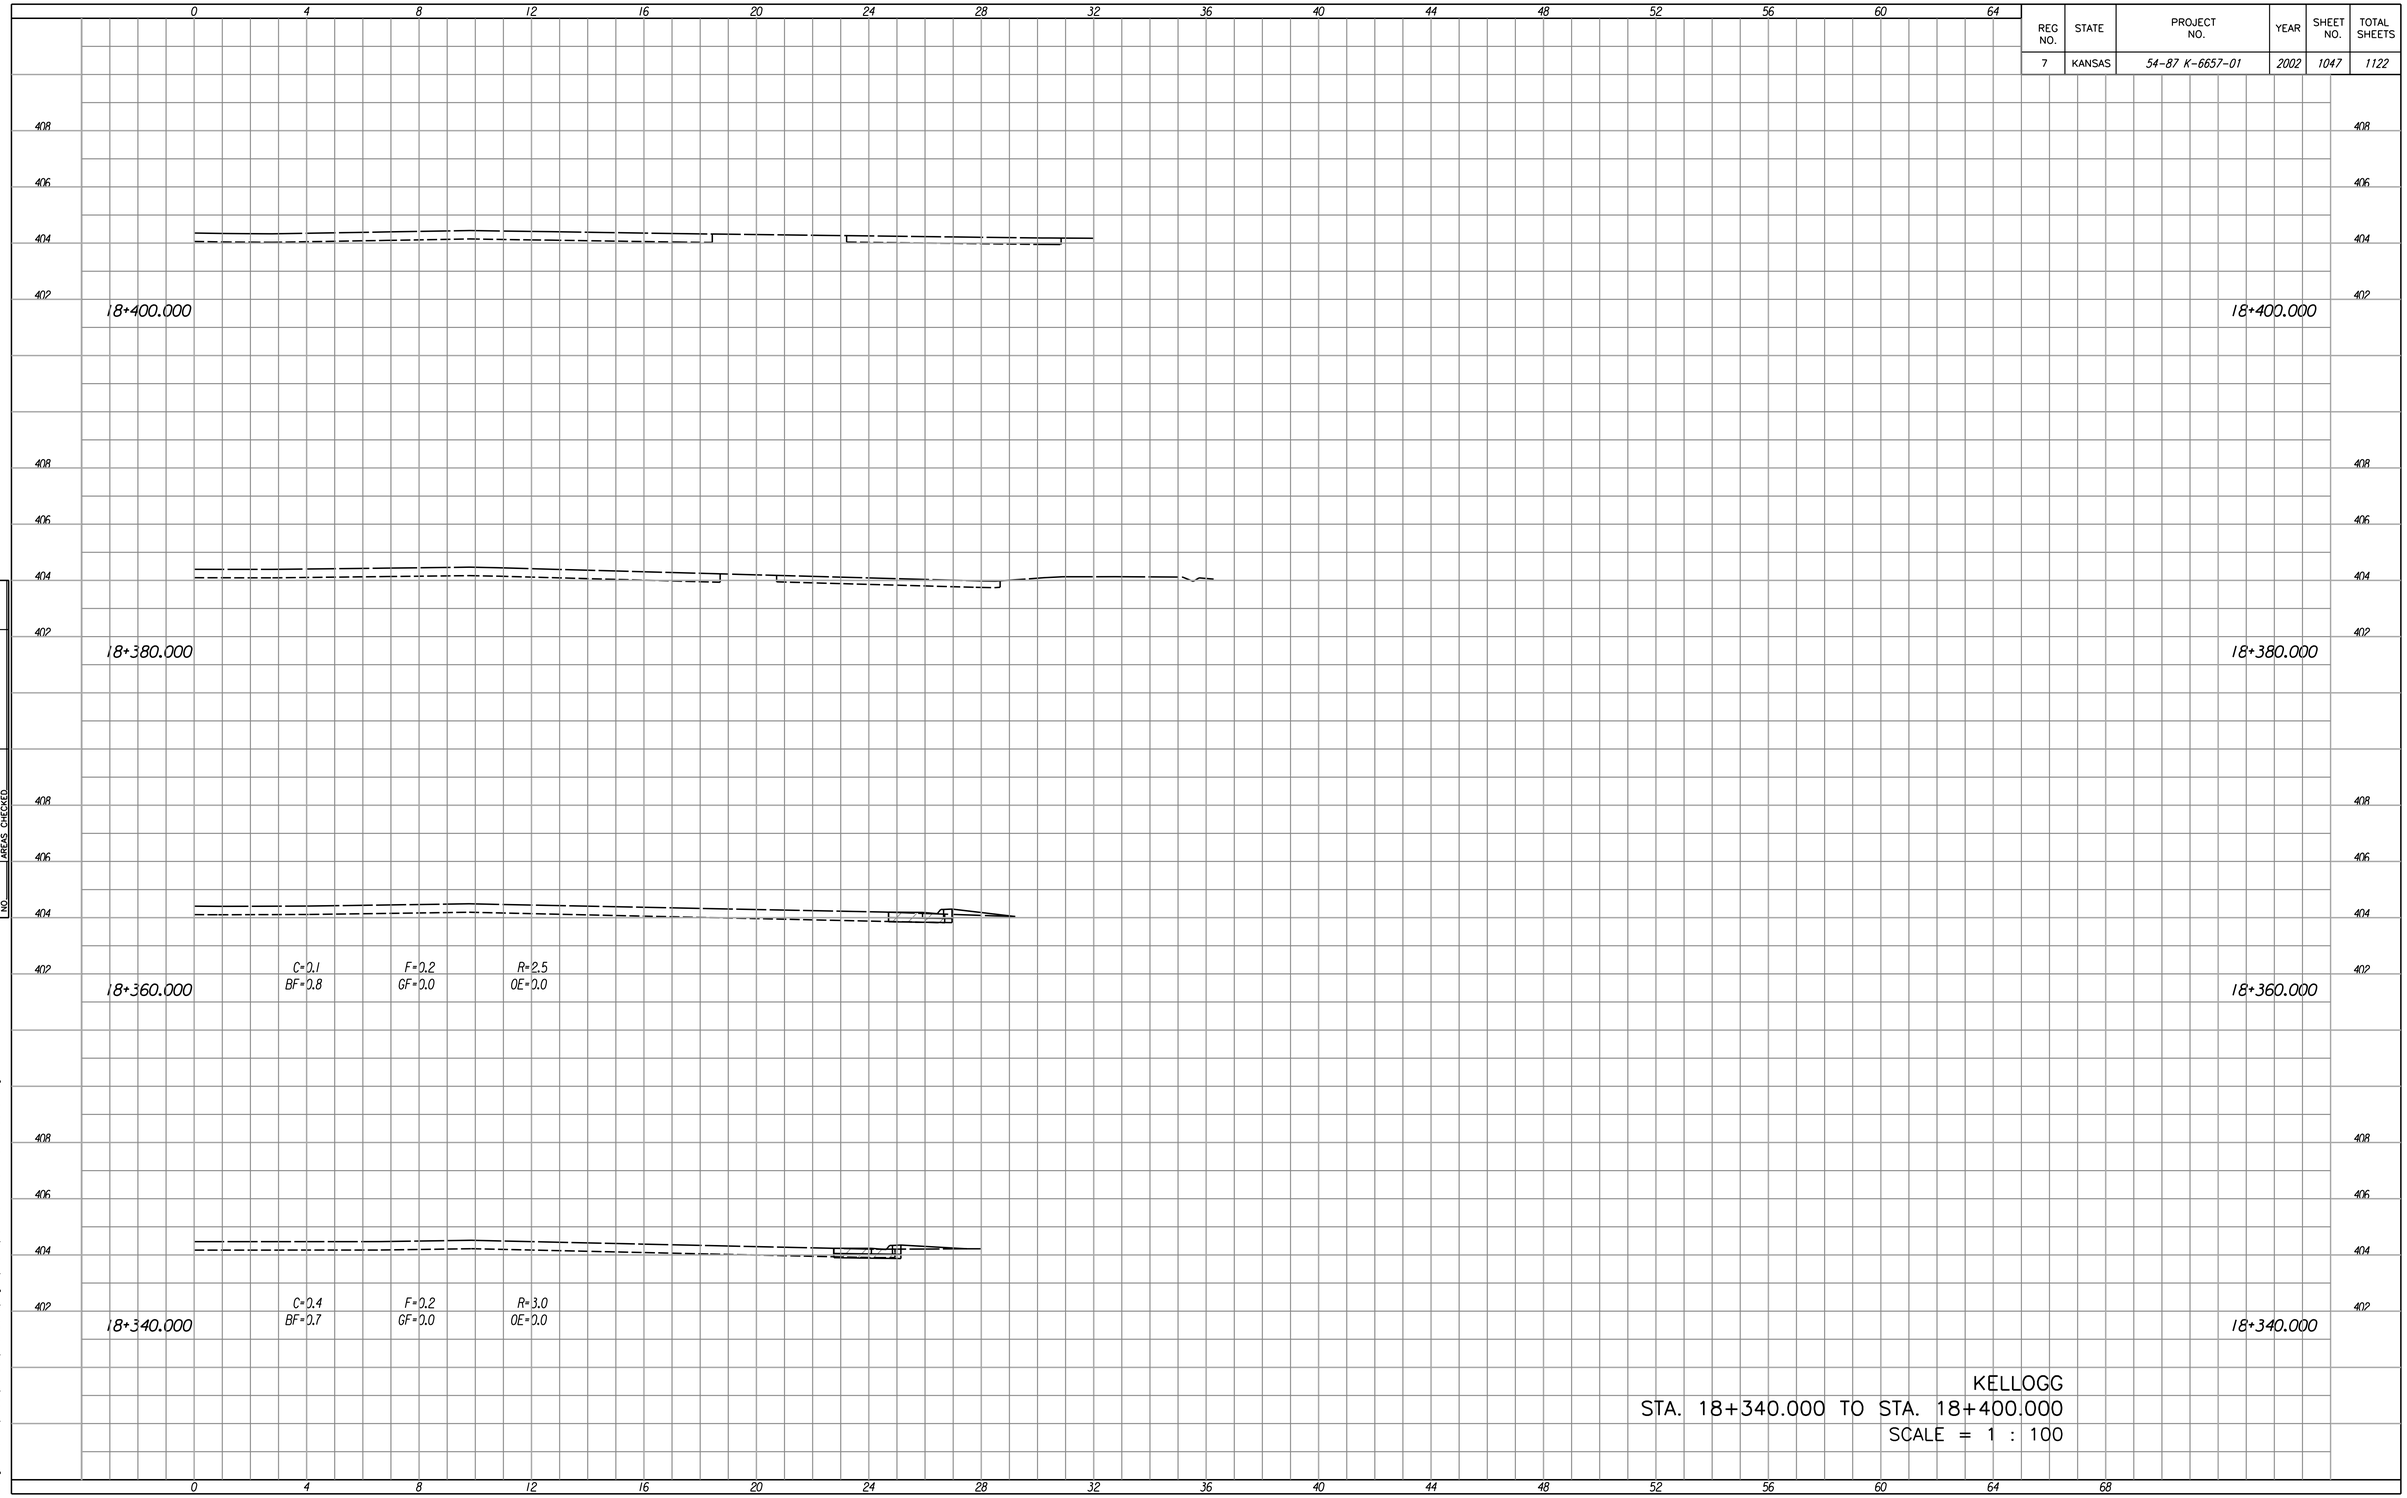

FINAL SURVEY	
SURVEYED	
PLOTTED	
NOTE BOOK	PAGE(S)
	AREAS
NO.	AREAS CHECKED

BY	DATE

Last Rev. : 10-12-07 By: gdr
Scale : 100
Design File : I:/1997/97362/As-Builts/dgn's/Vol 5/Sh 1047-Mainline-xs18340RI.dgn