REG NO.	STATE	PROJECT NO.	YEAR	SHEET NO.	TOTAL SHEETS
7	KANSAS	54-87 K-6657-01	2002	1060	1122

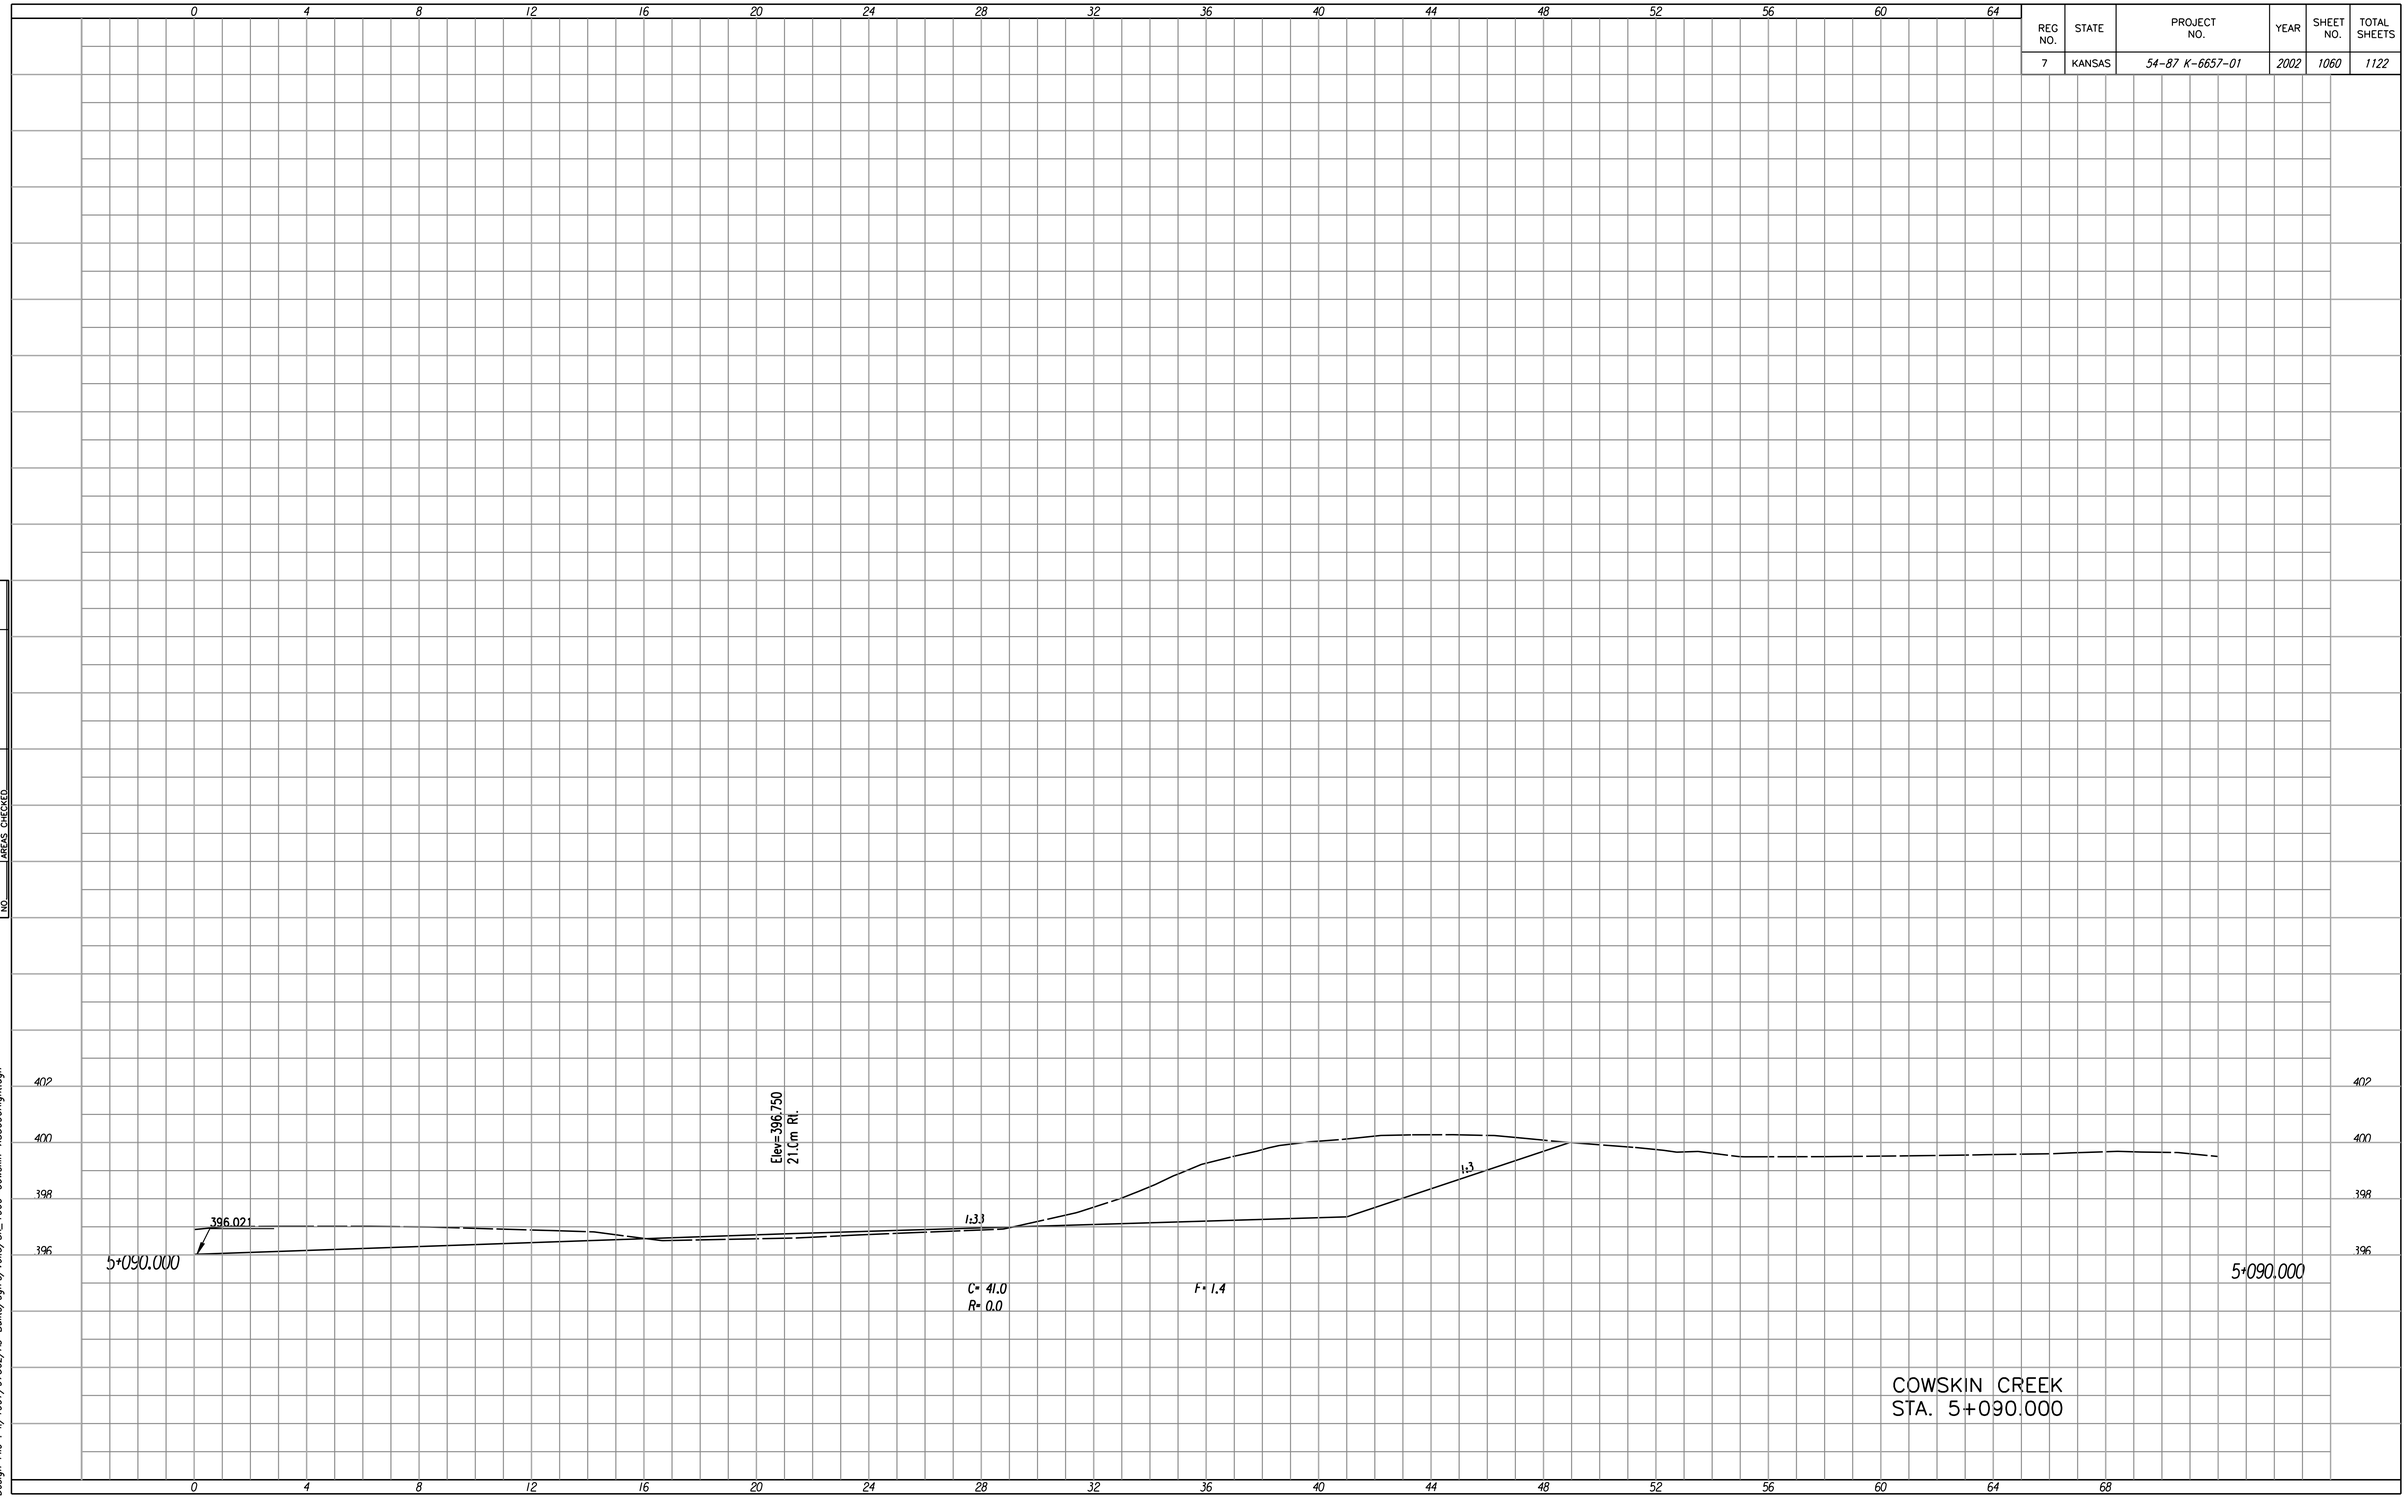

FINAL SURVEY		BY	DATE
	SURVEYED		
	PLOTTED		
NOTE BOOK	PLOTTED		
	AREAS		
NO.	AREAS CHECKED		

Scale = 1 : 100

Plotted By :

Sheet : i:/1997/97362/As-Builts/dgns/Vol.5/SH_1060-Cowskin-X5090Right.dgn

Design File :