FHWA REG NO.	STATE	PROJECT NO.	YEAR	SHEET NO.	TOTAL SHEETS
7	KANSAS	54-87 K-6657-01	2002	1065	1122

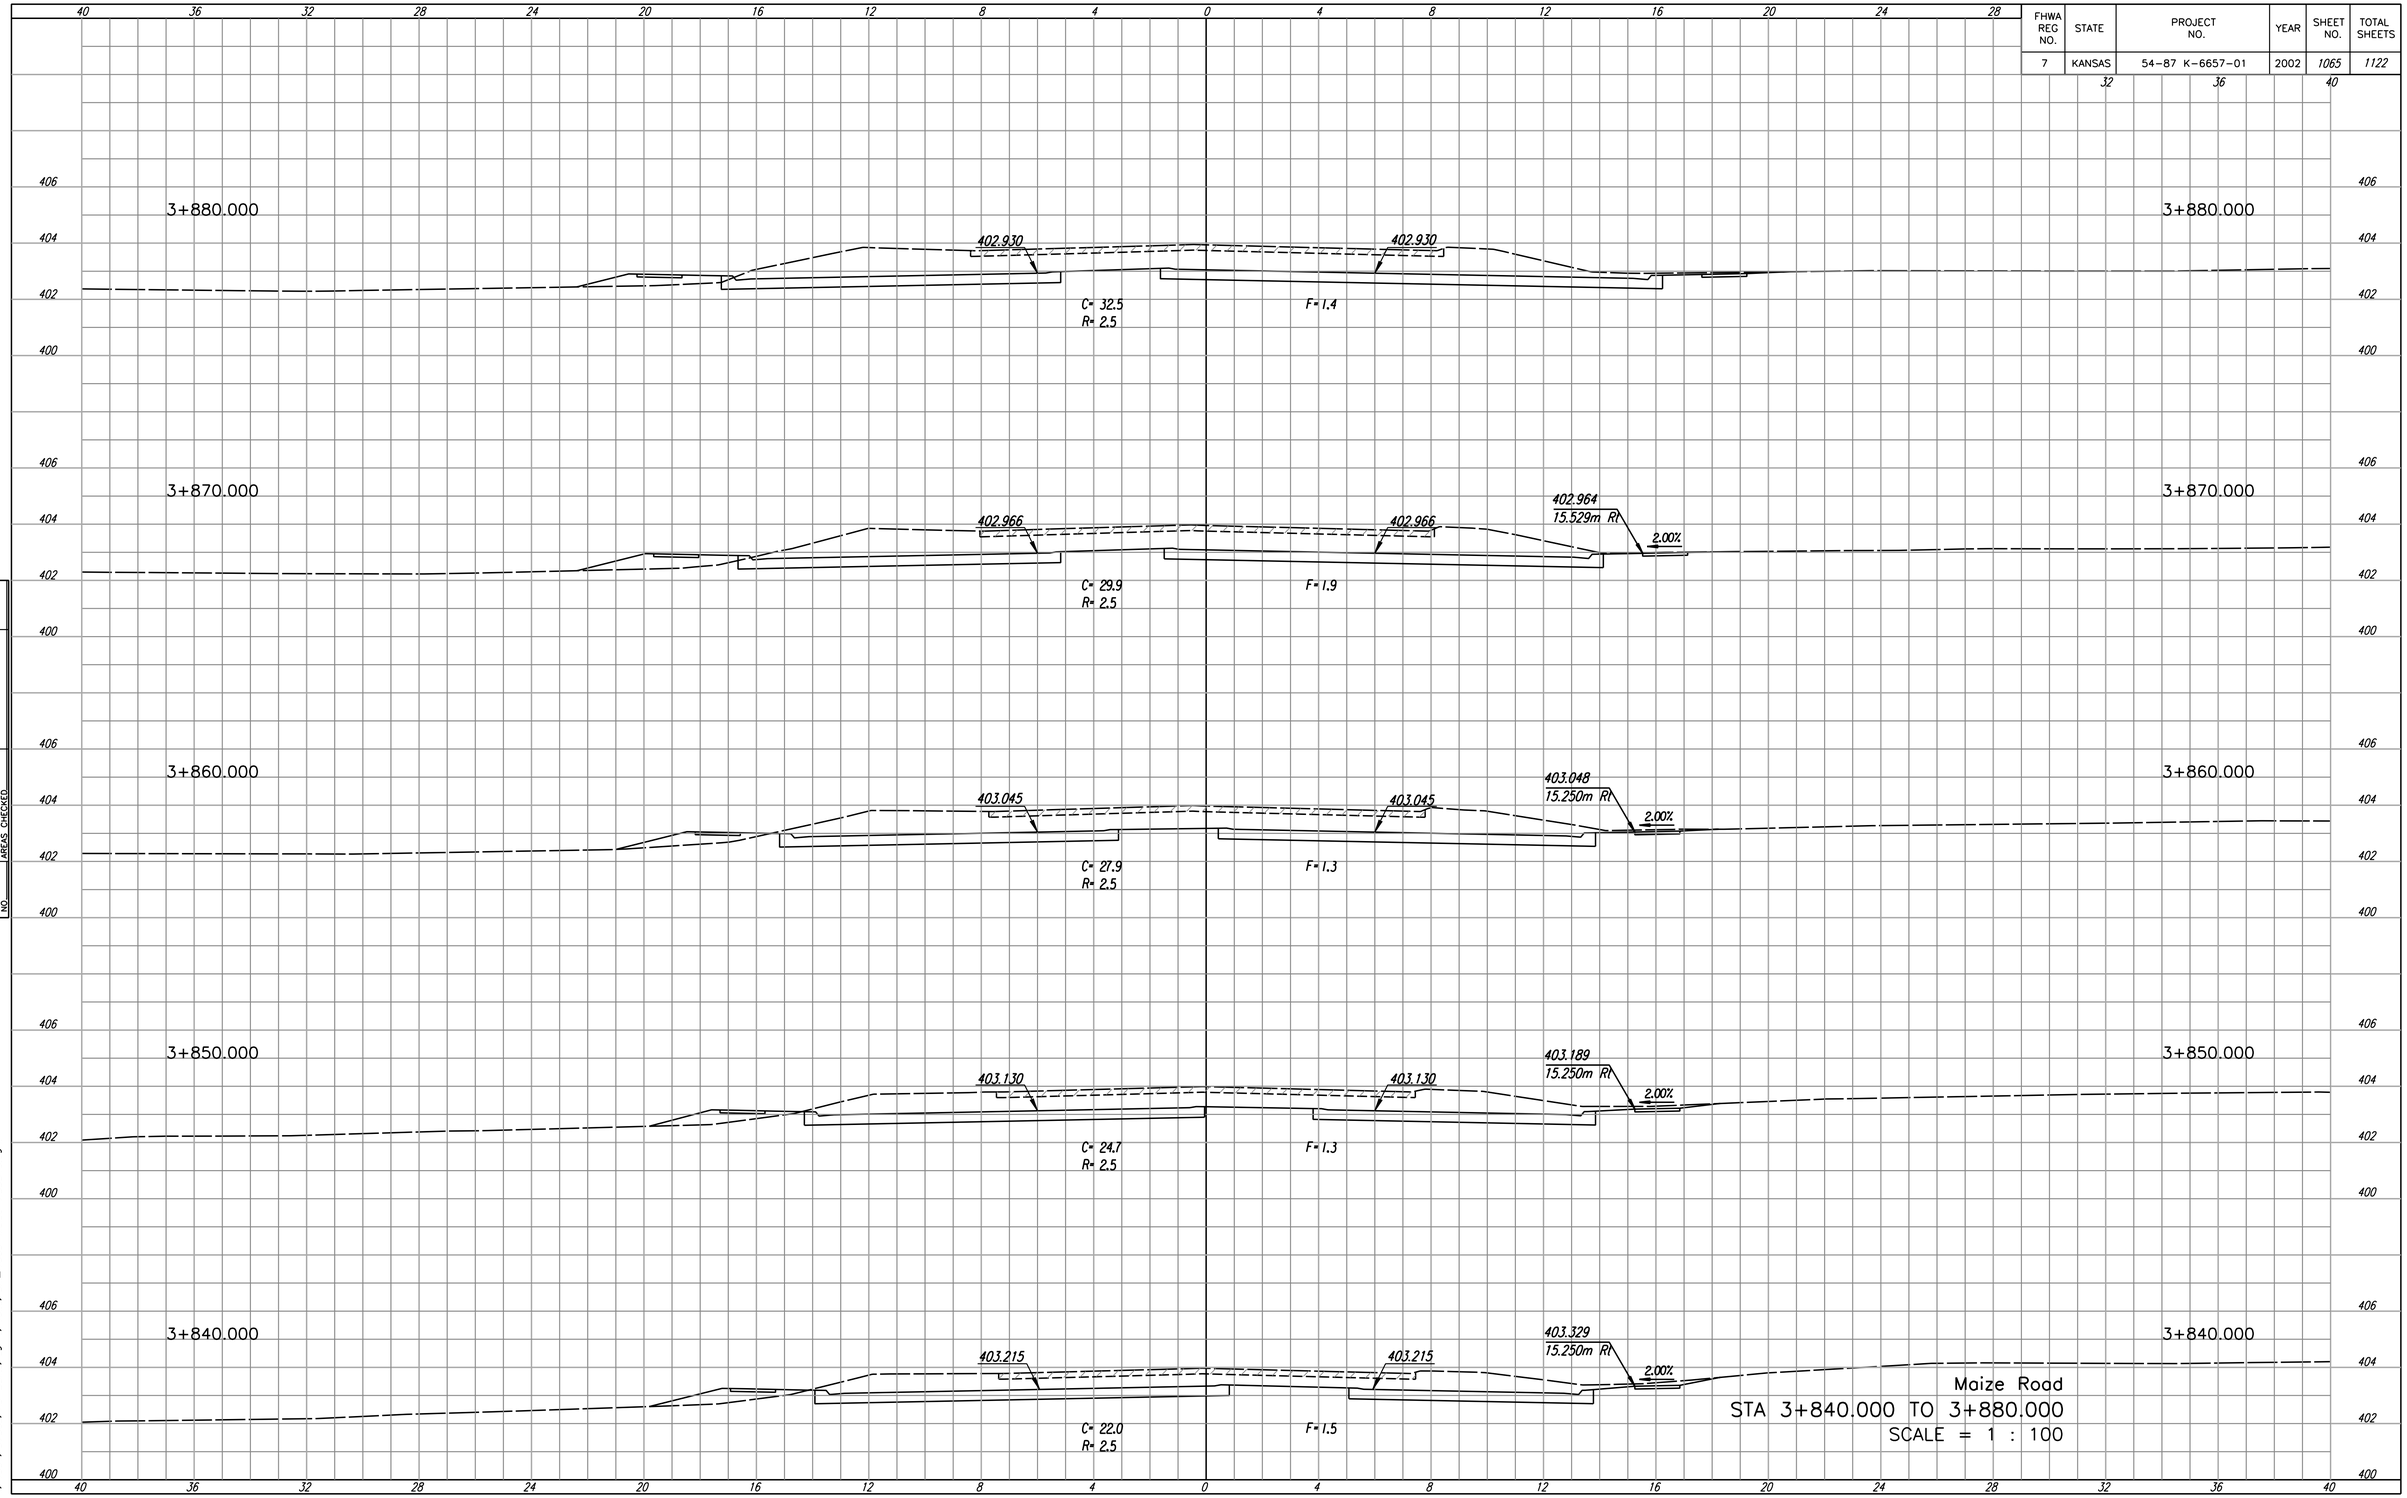

NO.	DATE	BY

FINAL SURVEY
NOTE BOOK
SURVEYED
PLOTTED
TRIANGULATE
AREAS
AREAS CHECKED

DSN#: RCH OPER: SVB SCALE: 1:100
I:/1997/97362/As-Builts/dgn's/Vol.5/Sh_ 1065-Maize-XS3840.dgn.