FHWA REG NO.	STATE	PROJECT NO.	YEAR	SHEET NO.	TOTAL SHEETS
7	KANSAS	54-87 K-6657-01	2002	1066	1122

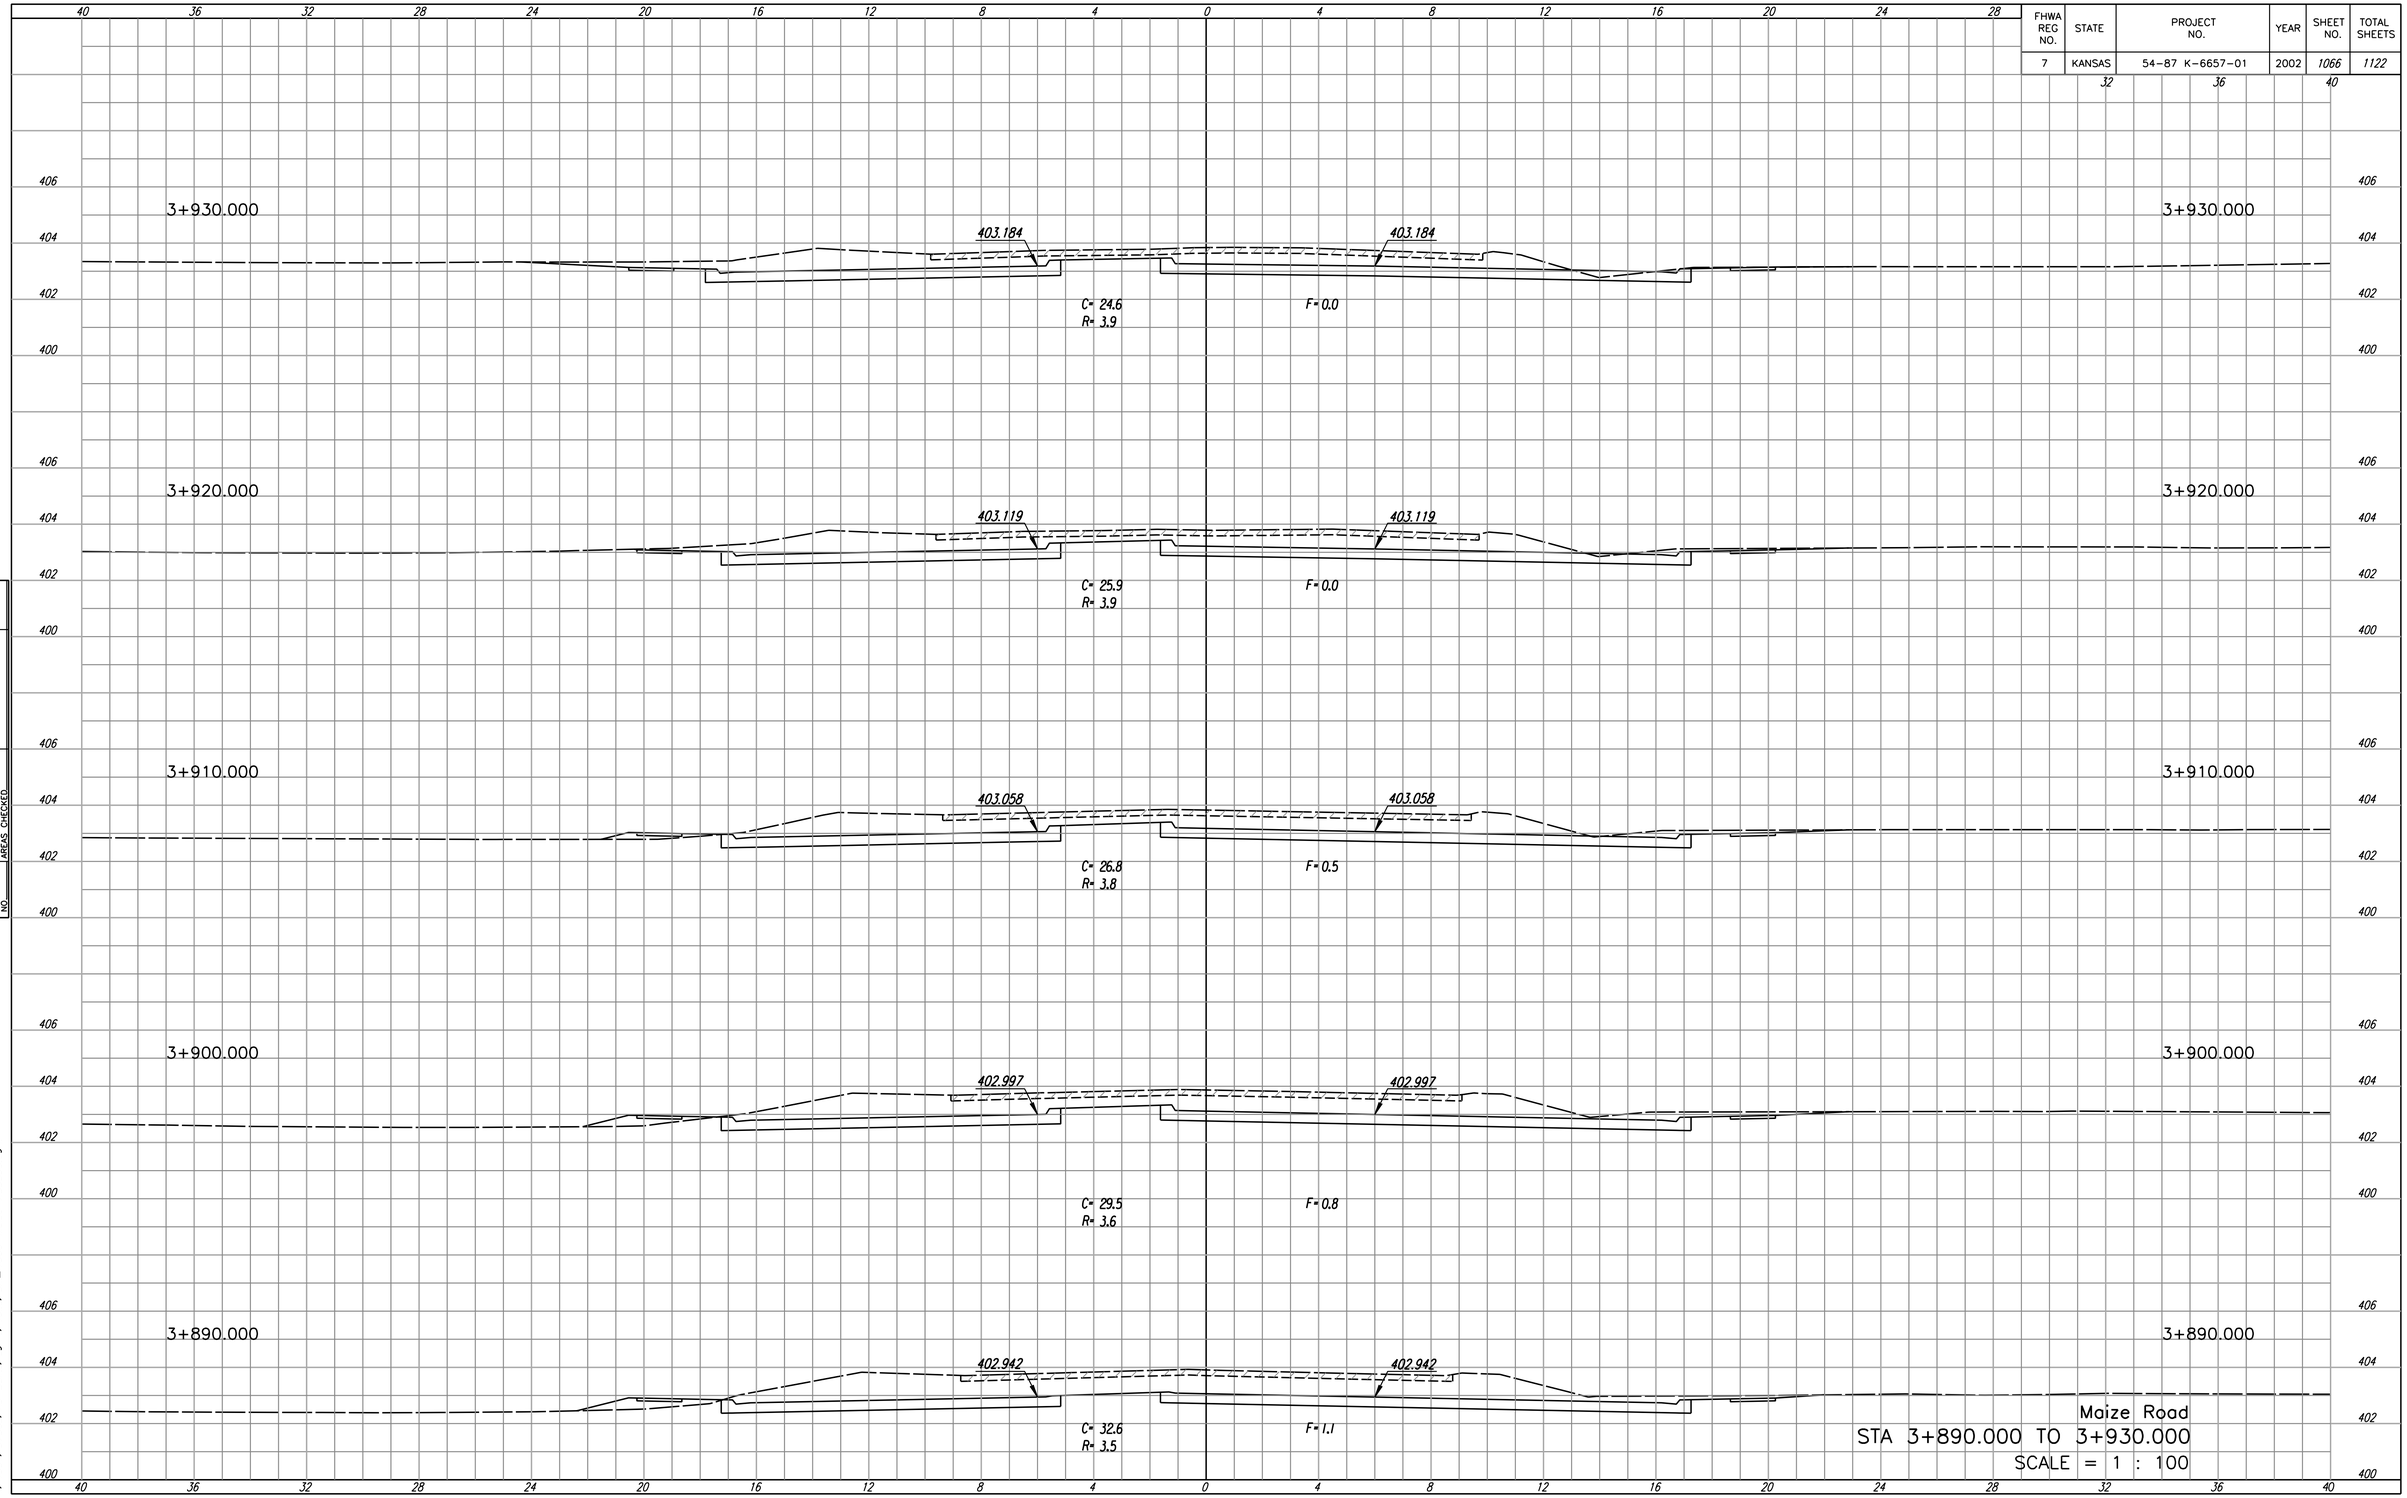

FINAL SURVEY	BY	DATE
SURVEYED		
PLOTTED		
NOTE BOOK	TRAVERSE	
	AREAS	
NO.	AREAS CHECKED	

DSNR: RCH OPER: SVB SCALE: 1:100
I:/1997/97362/As-Builts/dgn's/Vol.5/Sh_ 1066-Maize-XS3890.dgn.