FHWA REG NO.	STATE	PROJECT NO.	YEAR	SHEET NO.	TOTAL SHEETS
7	KANSAS	54-87 K-6657-01	2002	1074	1122

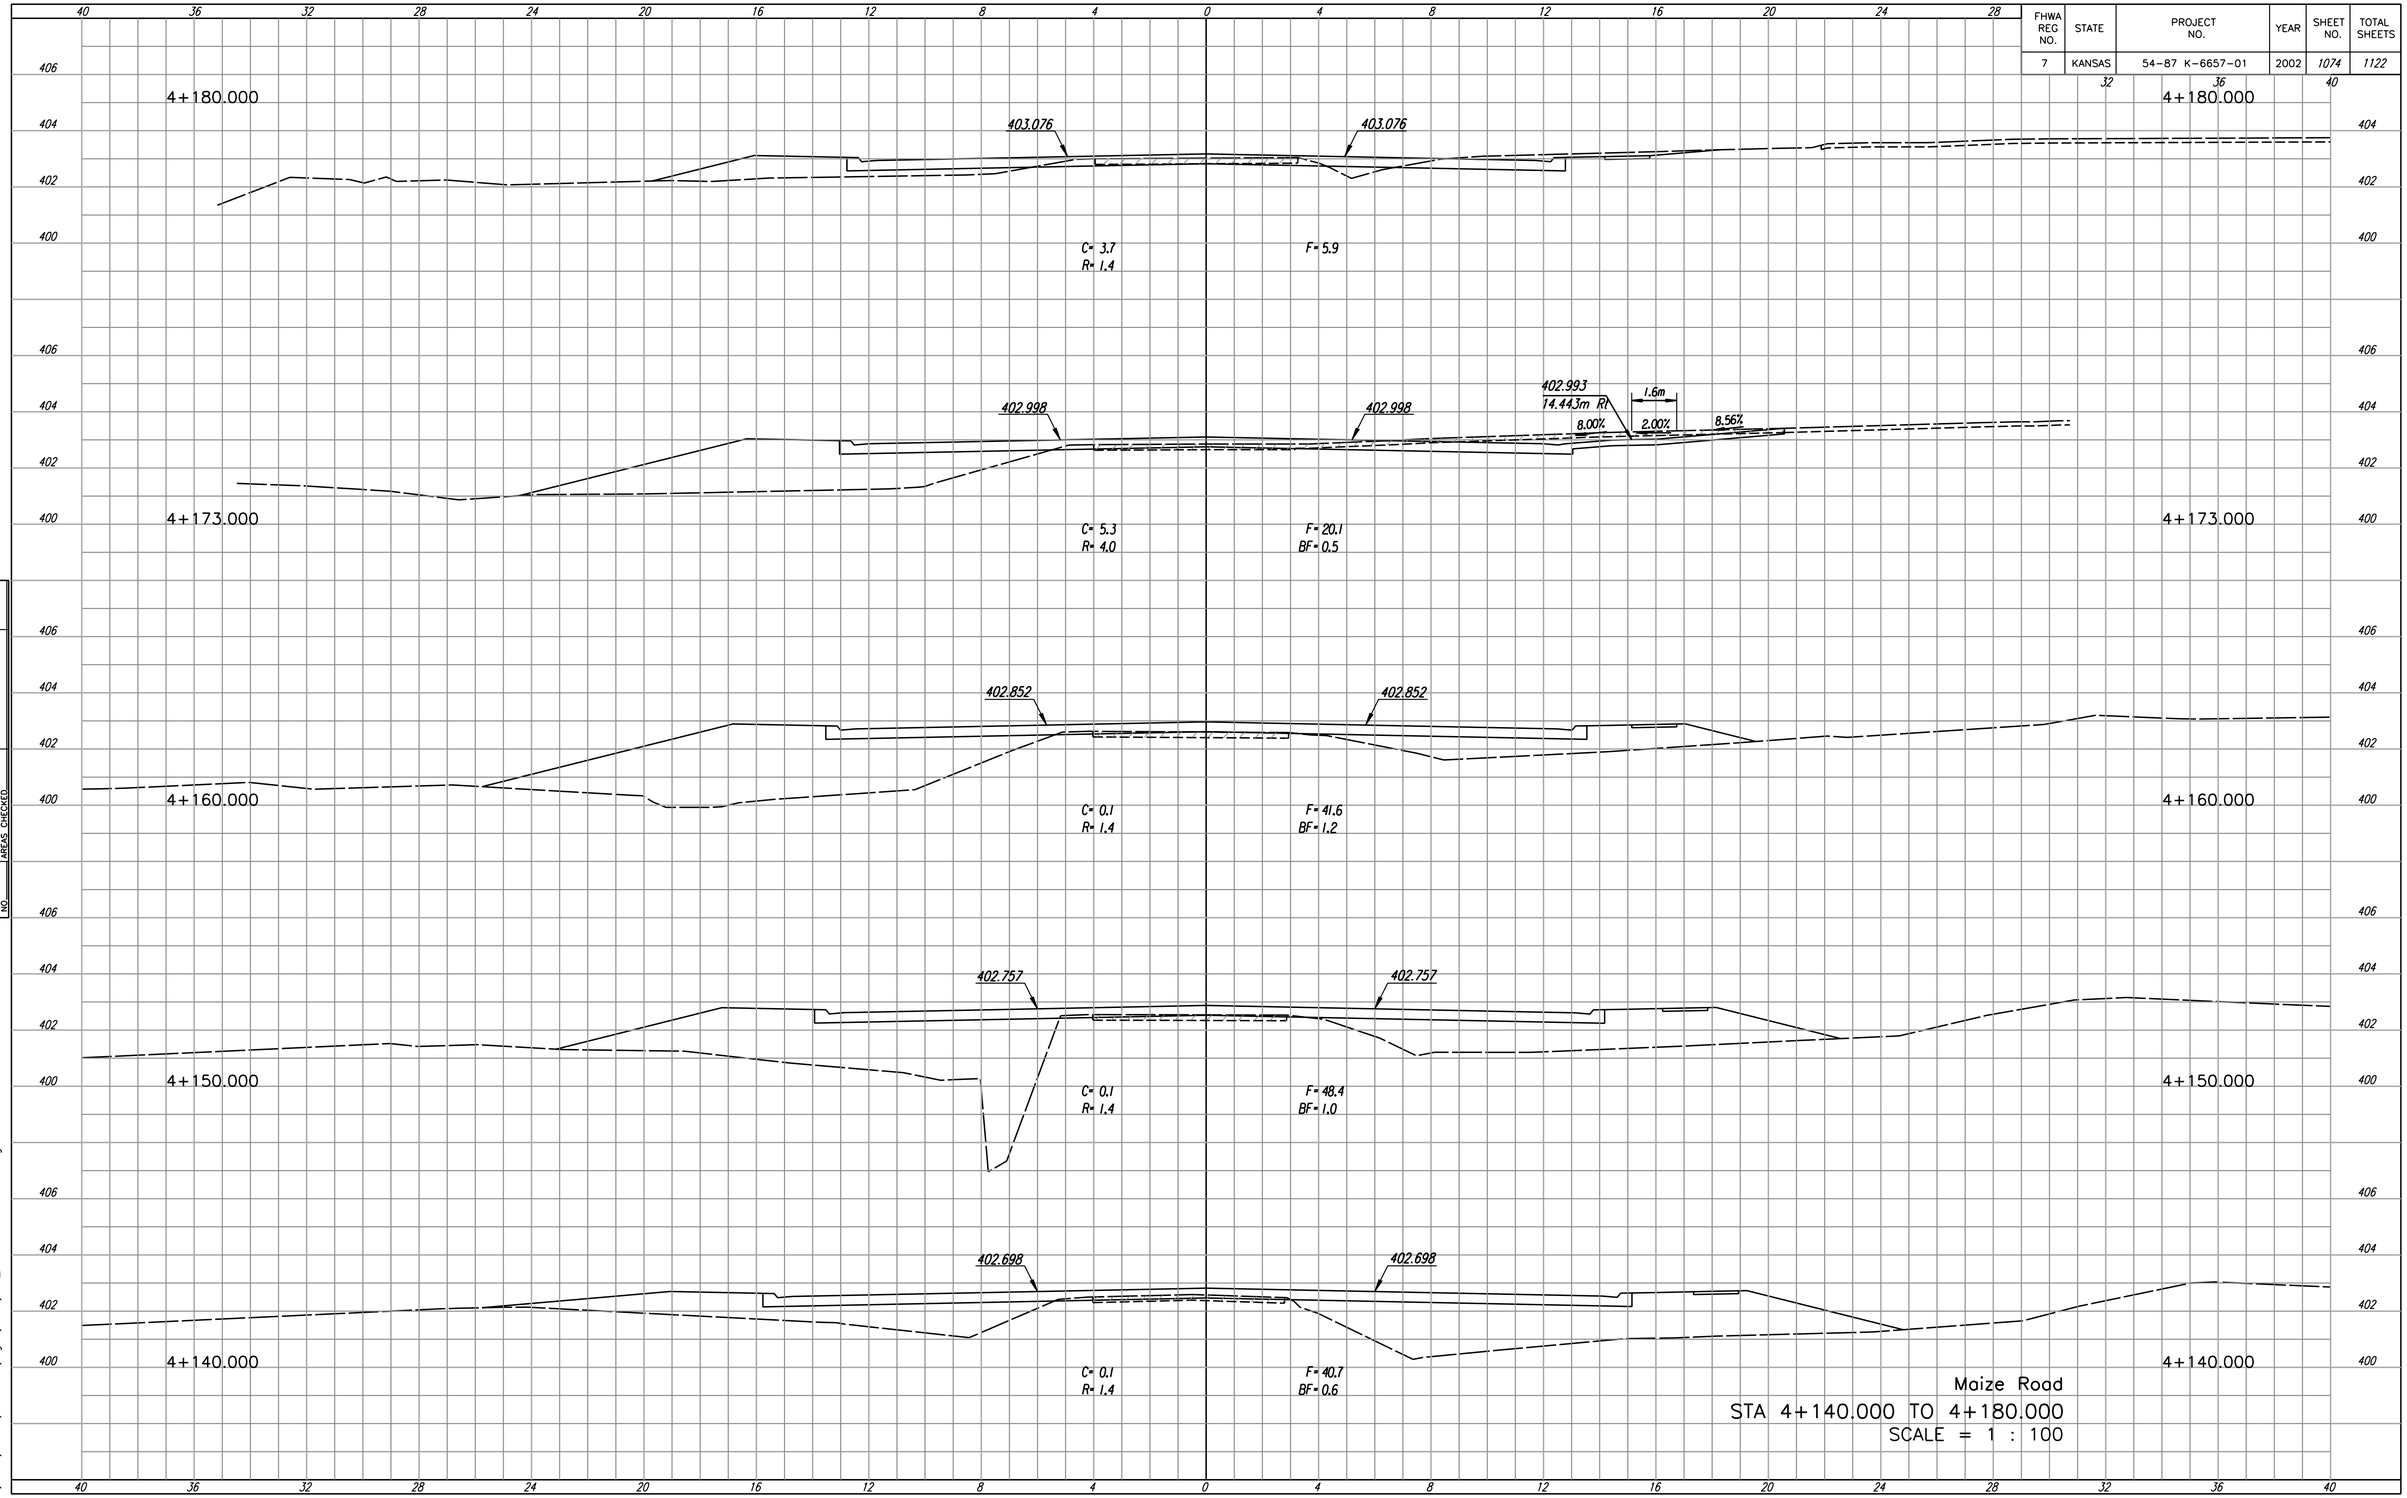

FINAL SURVEY		BY	DATE
	SURVEYED		
	PLOTTED		
NOTE BOOK	PLOTTED		
	AREAS		
NO.	AREAS CHECKED		

DSWR: RCH OPER: SVB SCALE: 1:100
I:/199/9/362/As-Builts/dgns/Vol.5/Sh_1074-Maize-XS4140.dgn