


FHWA REG NO.	STATE	PROJECT NO.	YEAR	SHEET NO.	TOTAL SHEETS
7	KANSAS	54-87 K-6657-01	2002	1078	1122
	32	36		40	

FINAL SURVEY NO.	DATE
SURVEYED BY	
PLOTTED BY	
TEMPLATE AREAS CHECKED	

DSWR: RCH OPER: SVB SCALE: 1:100
 I:/1997/97362/as-Bulls/dgn's/Vol.5/Sh_1078-Maize-KS4330.dgn

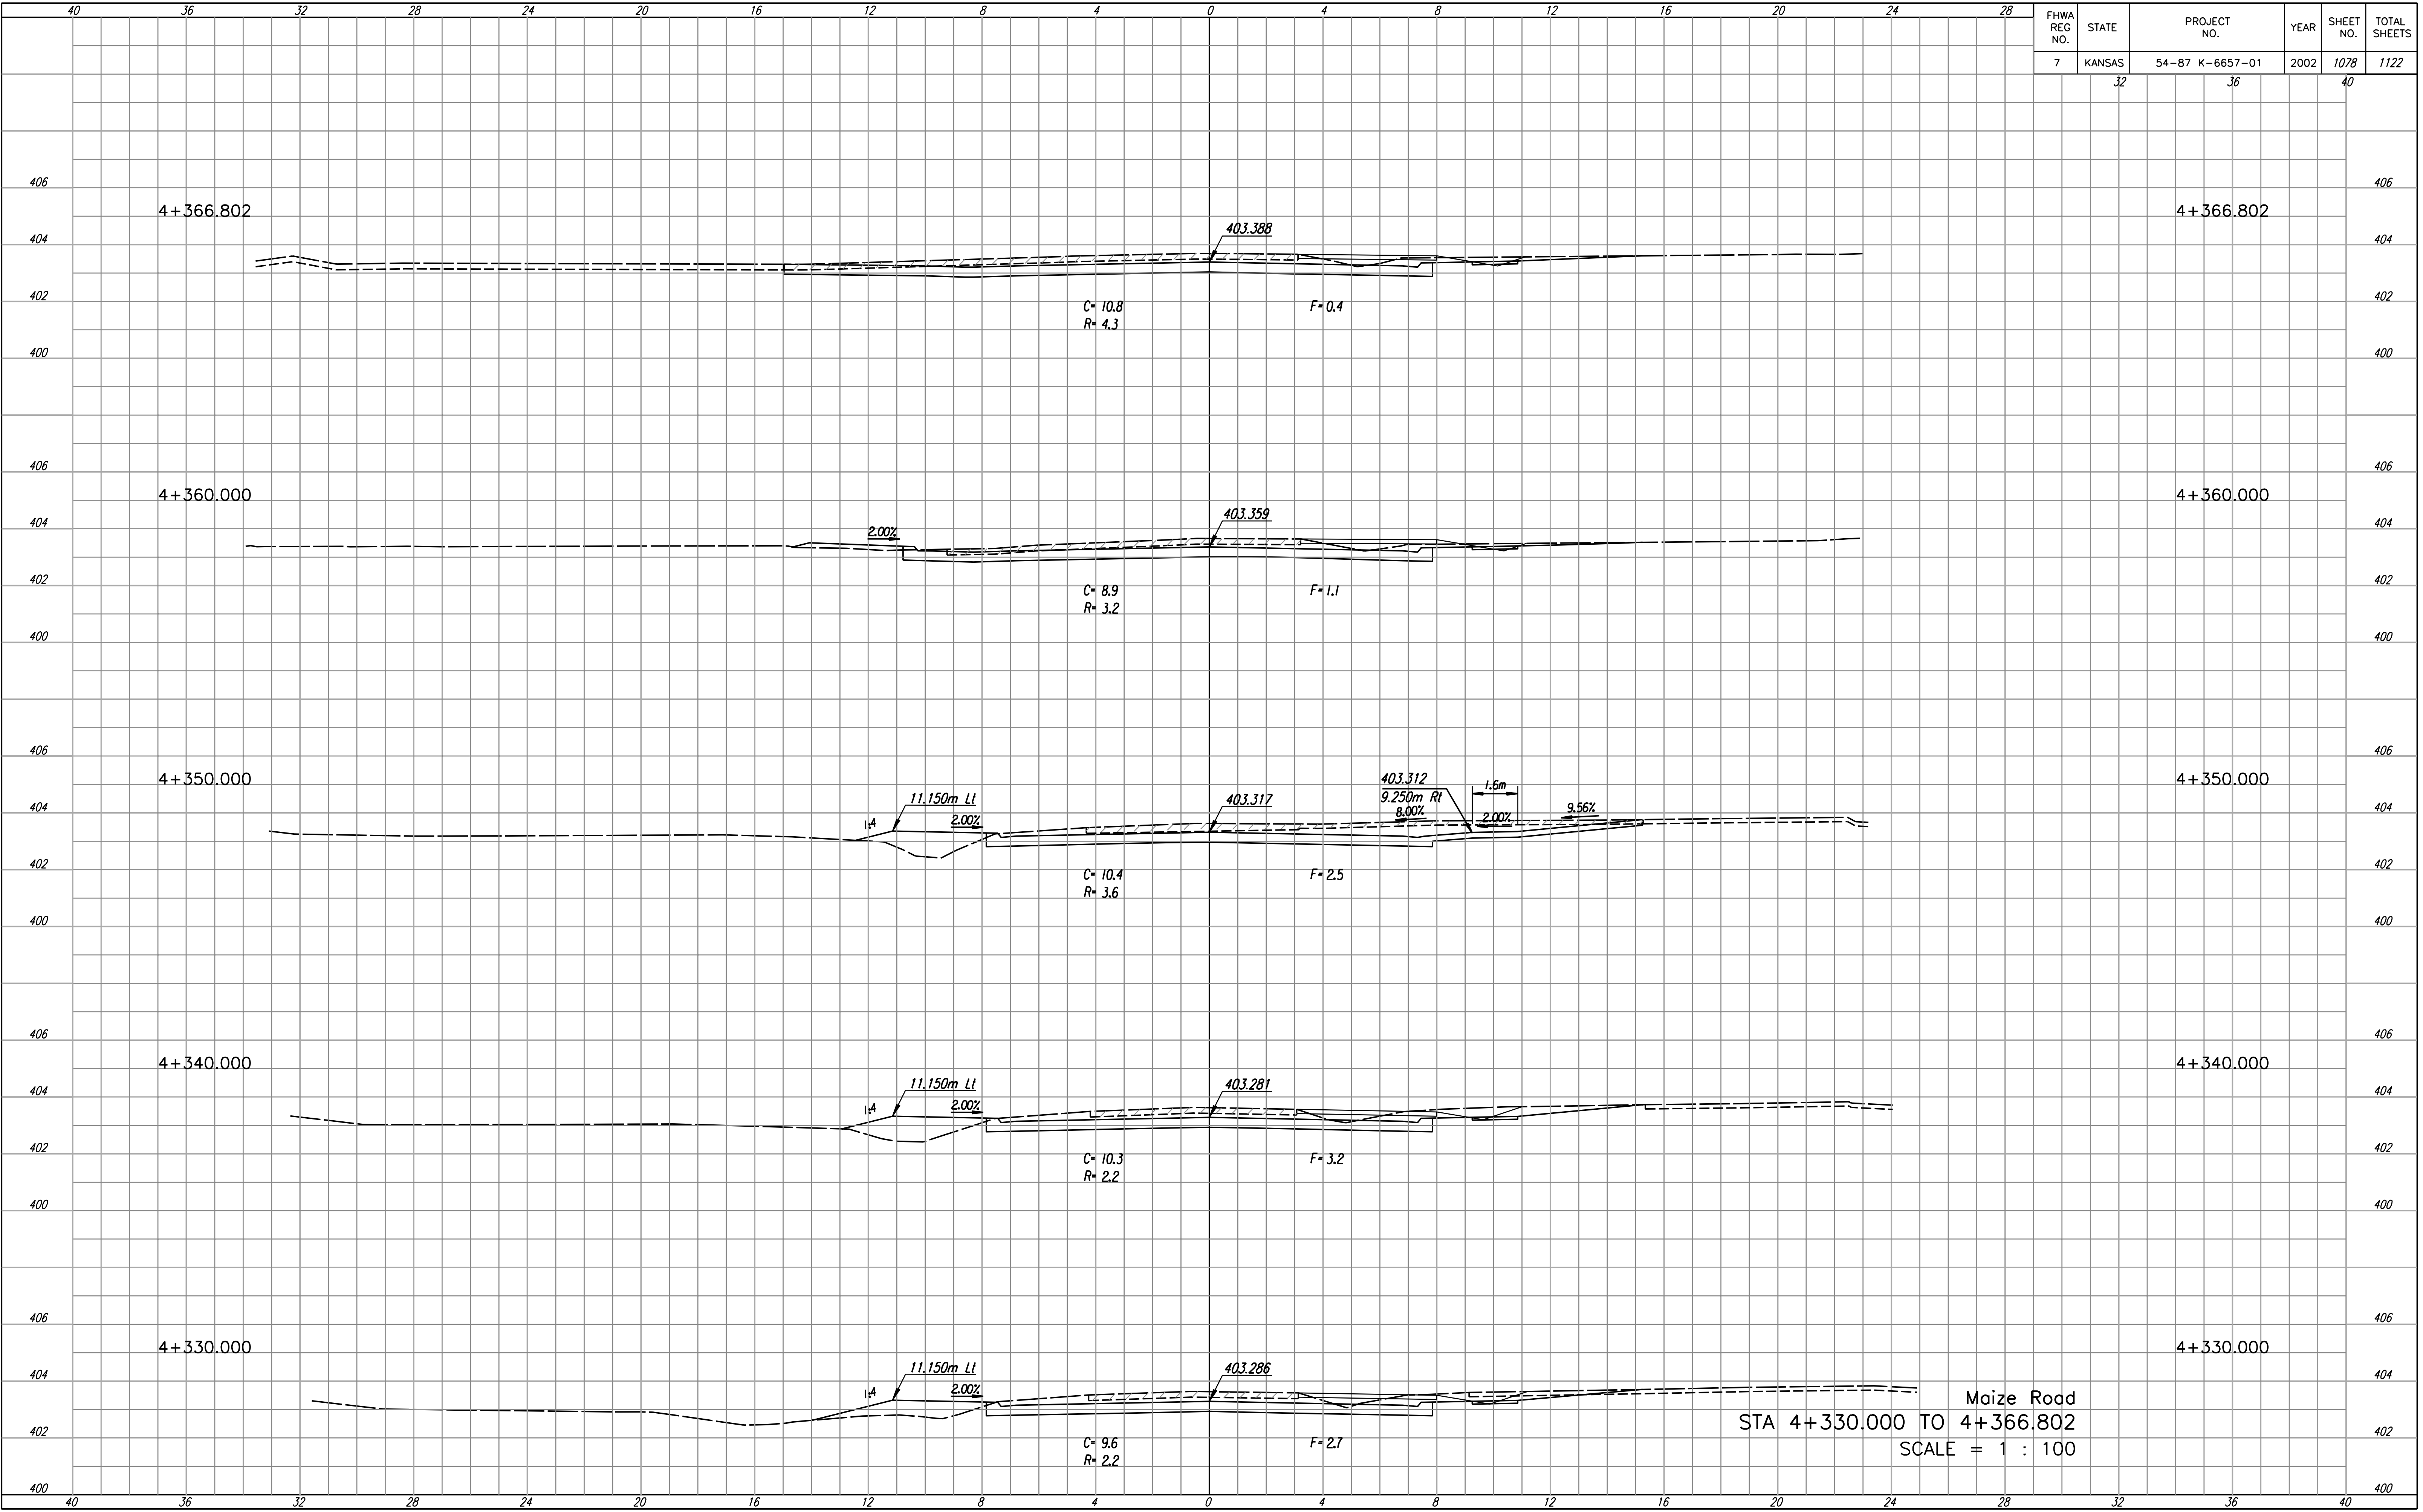

Maize Road
 STA 4+330.000 TO 4+366.802
 SCALE = 1 : 100