| FHWA REG NO. | STATE | PROJECT NO. | YEAR | SHEET NO. | TOTAL SHEETS |
|---|---|---|---|---|---|
| 7 | KANSAS | 54-87 K-6657-01 | 2002 | 1087 | 1122 |

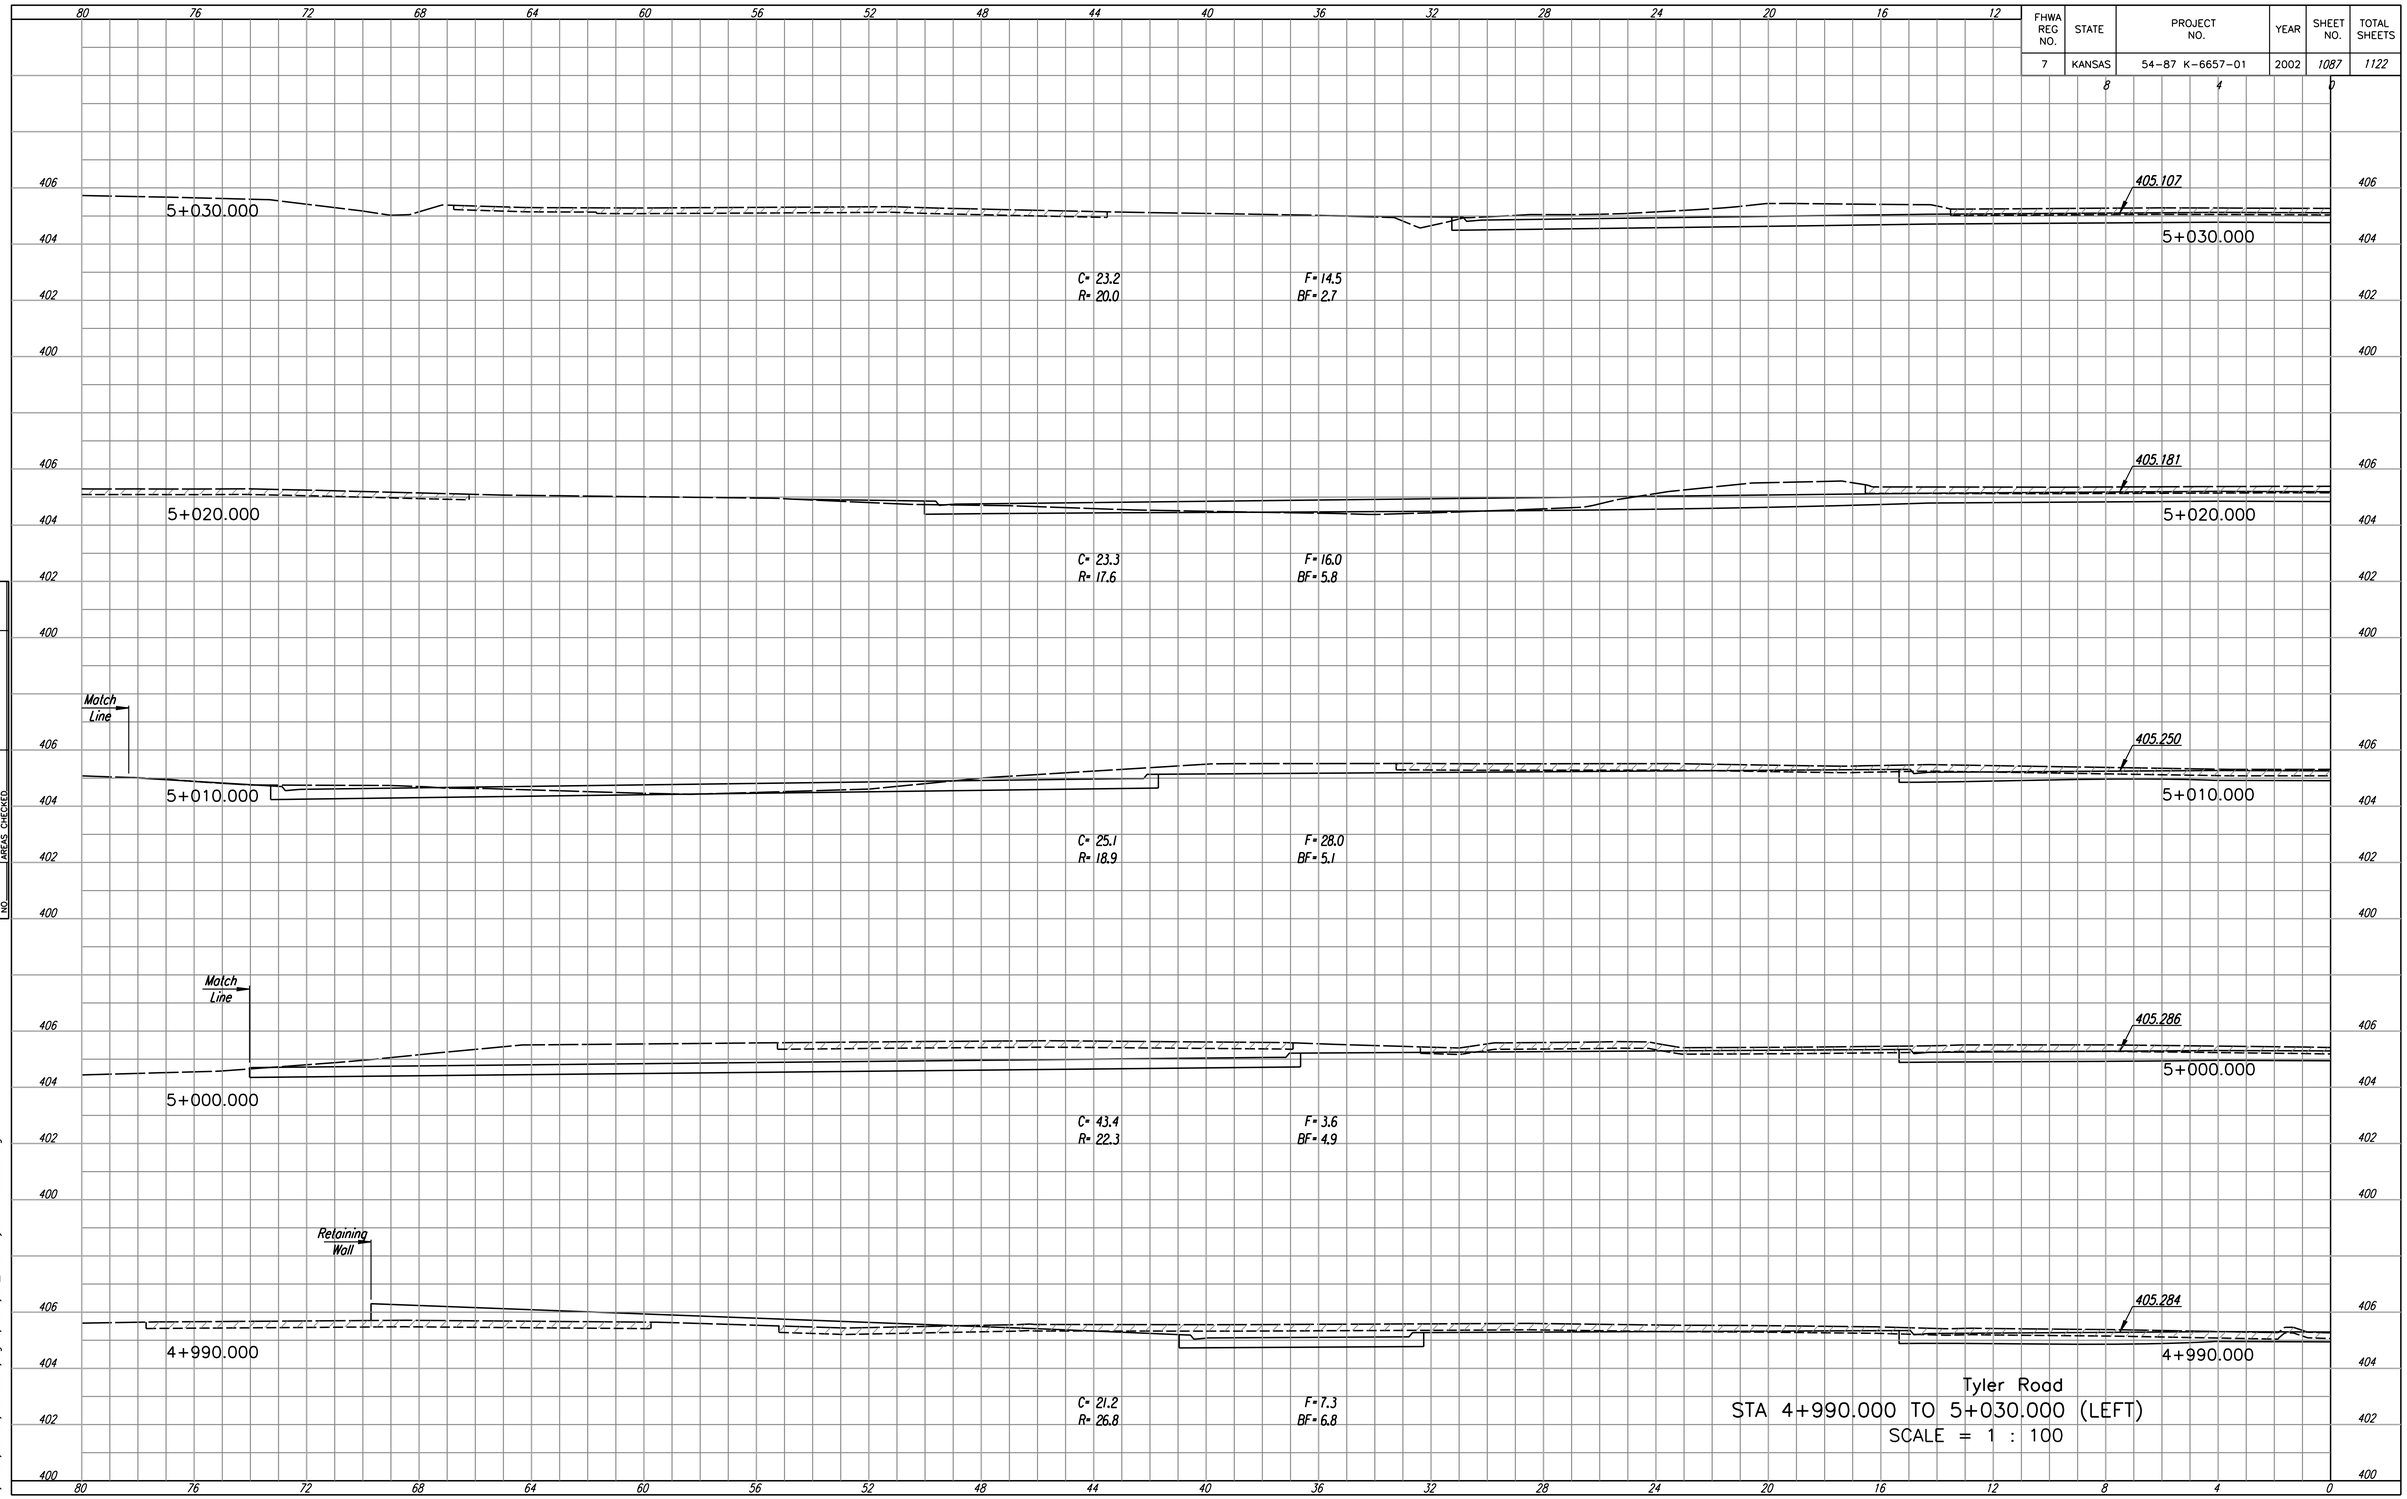


| FINAL SURVEY | | BY | DATE |
|---|---|---|---|
| | SURVEYED | | |
| | PLOTTED | | |
| NOTE BOOK | NUMBER | | |
| | AREAS | | |
| NO. | AREAS CHECKED | | |

DSWR: RCH OPER: SVB SCALE: 1:100
I:/1997/97362/As-Builts/dgn's/Vol.5/Sh_1087-Tyler-XS4990Left.dgn