FHWA REG NO.	STATE	PROJECT NO.	YEAR	SHEET NO.	TOTAL SHEETS
7	KANSAS	54-87 K-6657-01	2002	1095	1122

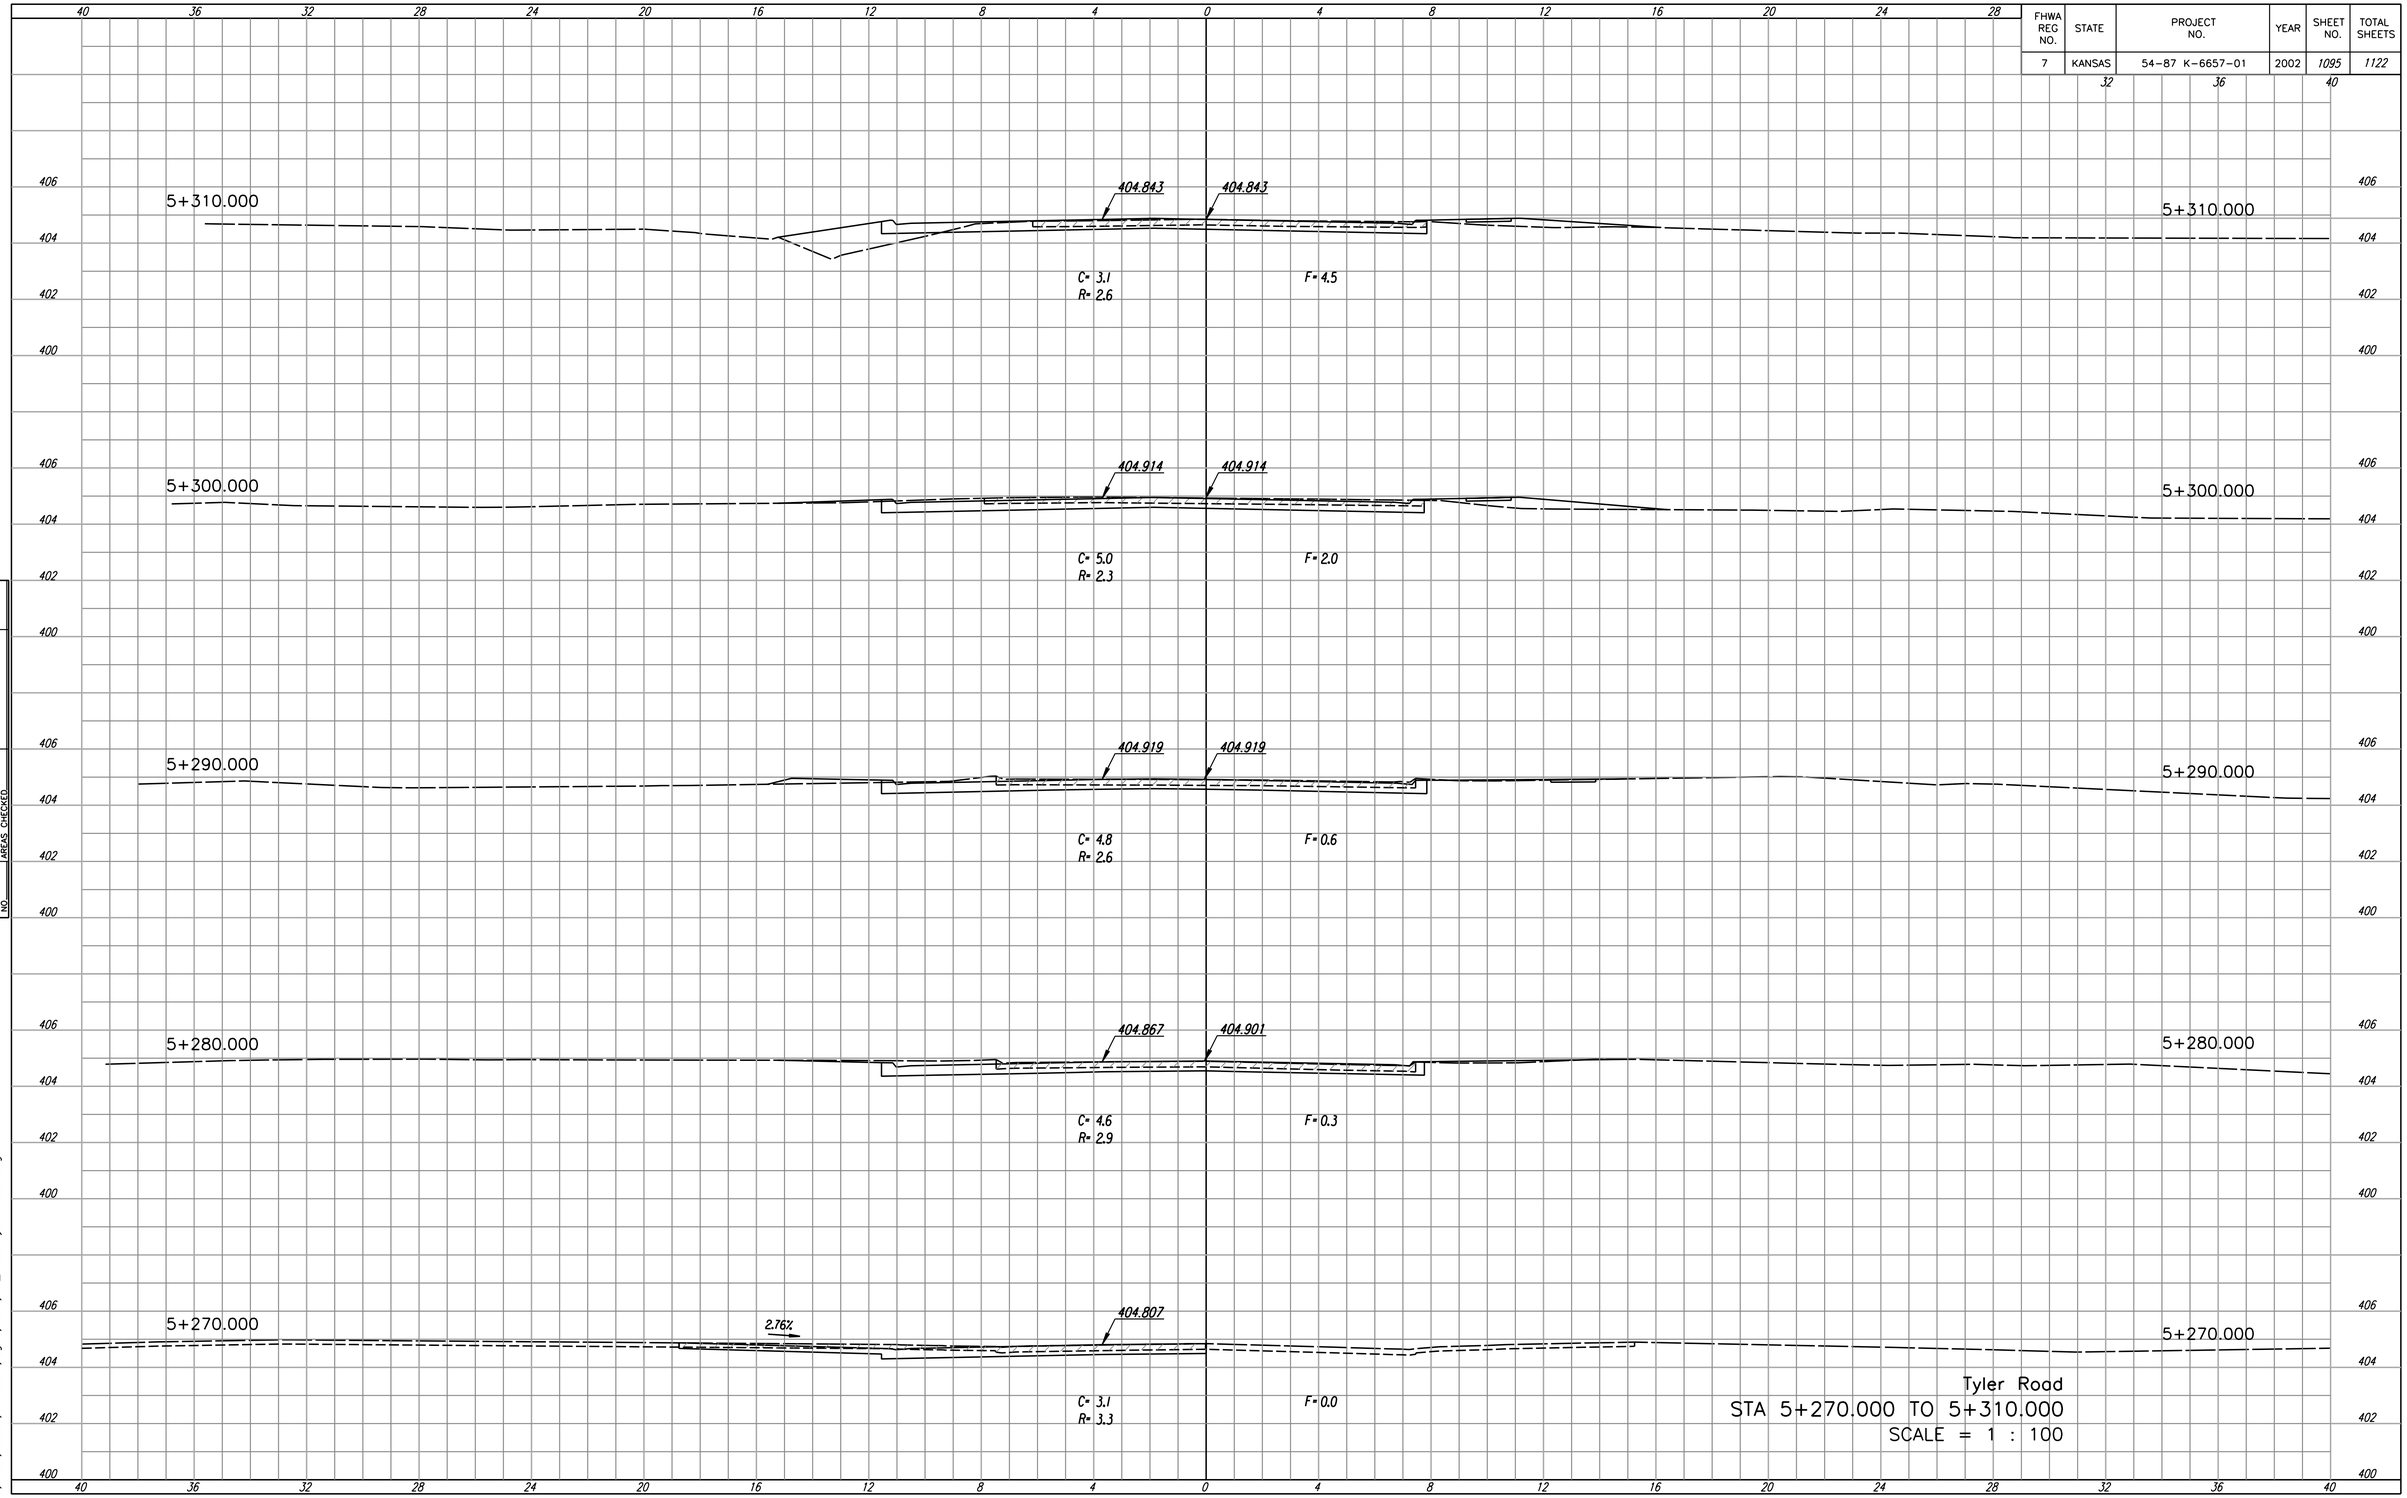

FINAL SURVEY	BY	DATE
NOTE BOOK	SURVEYED	
NO.	PLOTTED	
	TRAVERSE	
	AREAS	
	AREAS CHECKED	

DSNR: RCH OPER: SVB SCALE: 1:100
I:/1997/97362/As-Builts/dgn's/Vol.5/SH_1095-Tyler-XS5270.dgn