FHWA REG NO.	STATE	PROJECT NO.	YEAR	SHEET NO.	TOTAL SHEETS
7	KANSAS	54-87 K-6657-01	2002	1107	1122

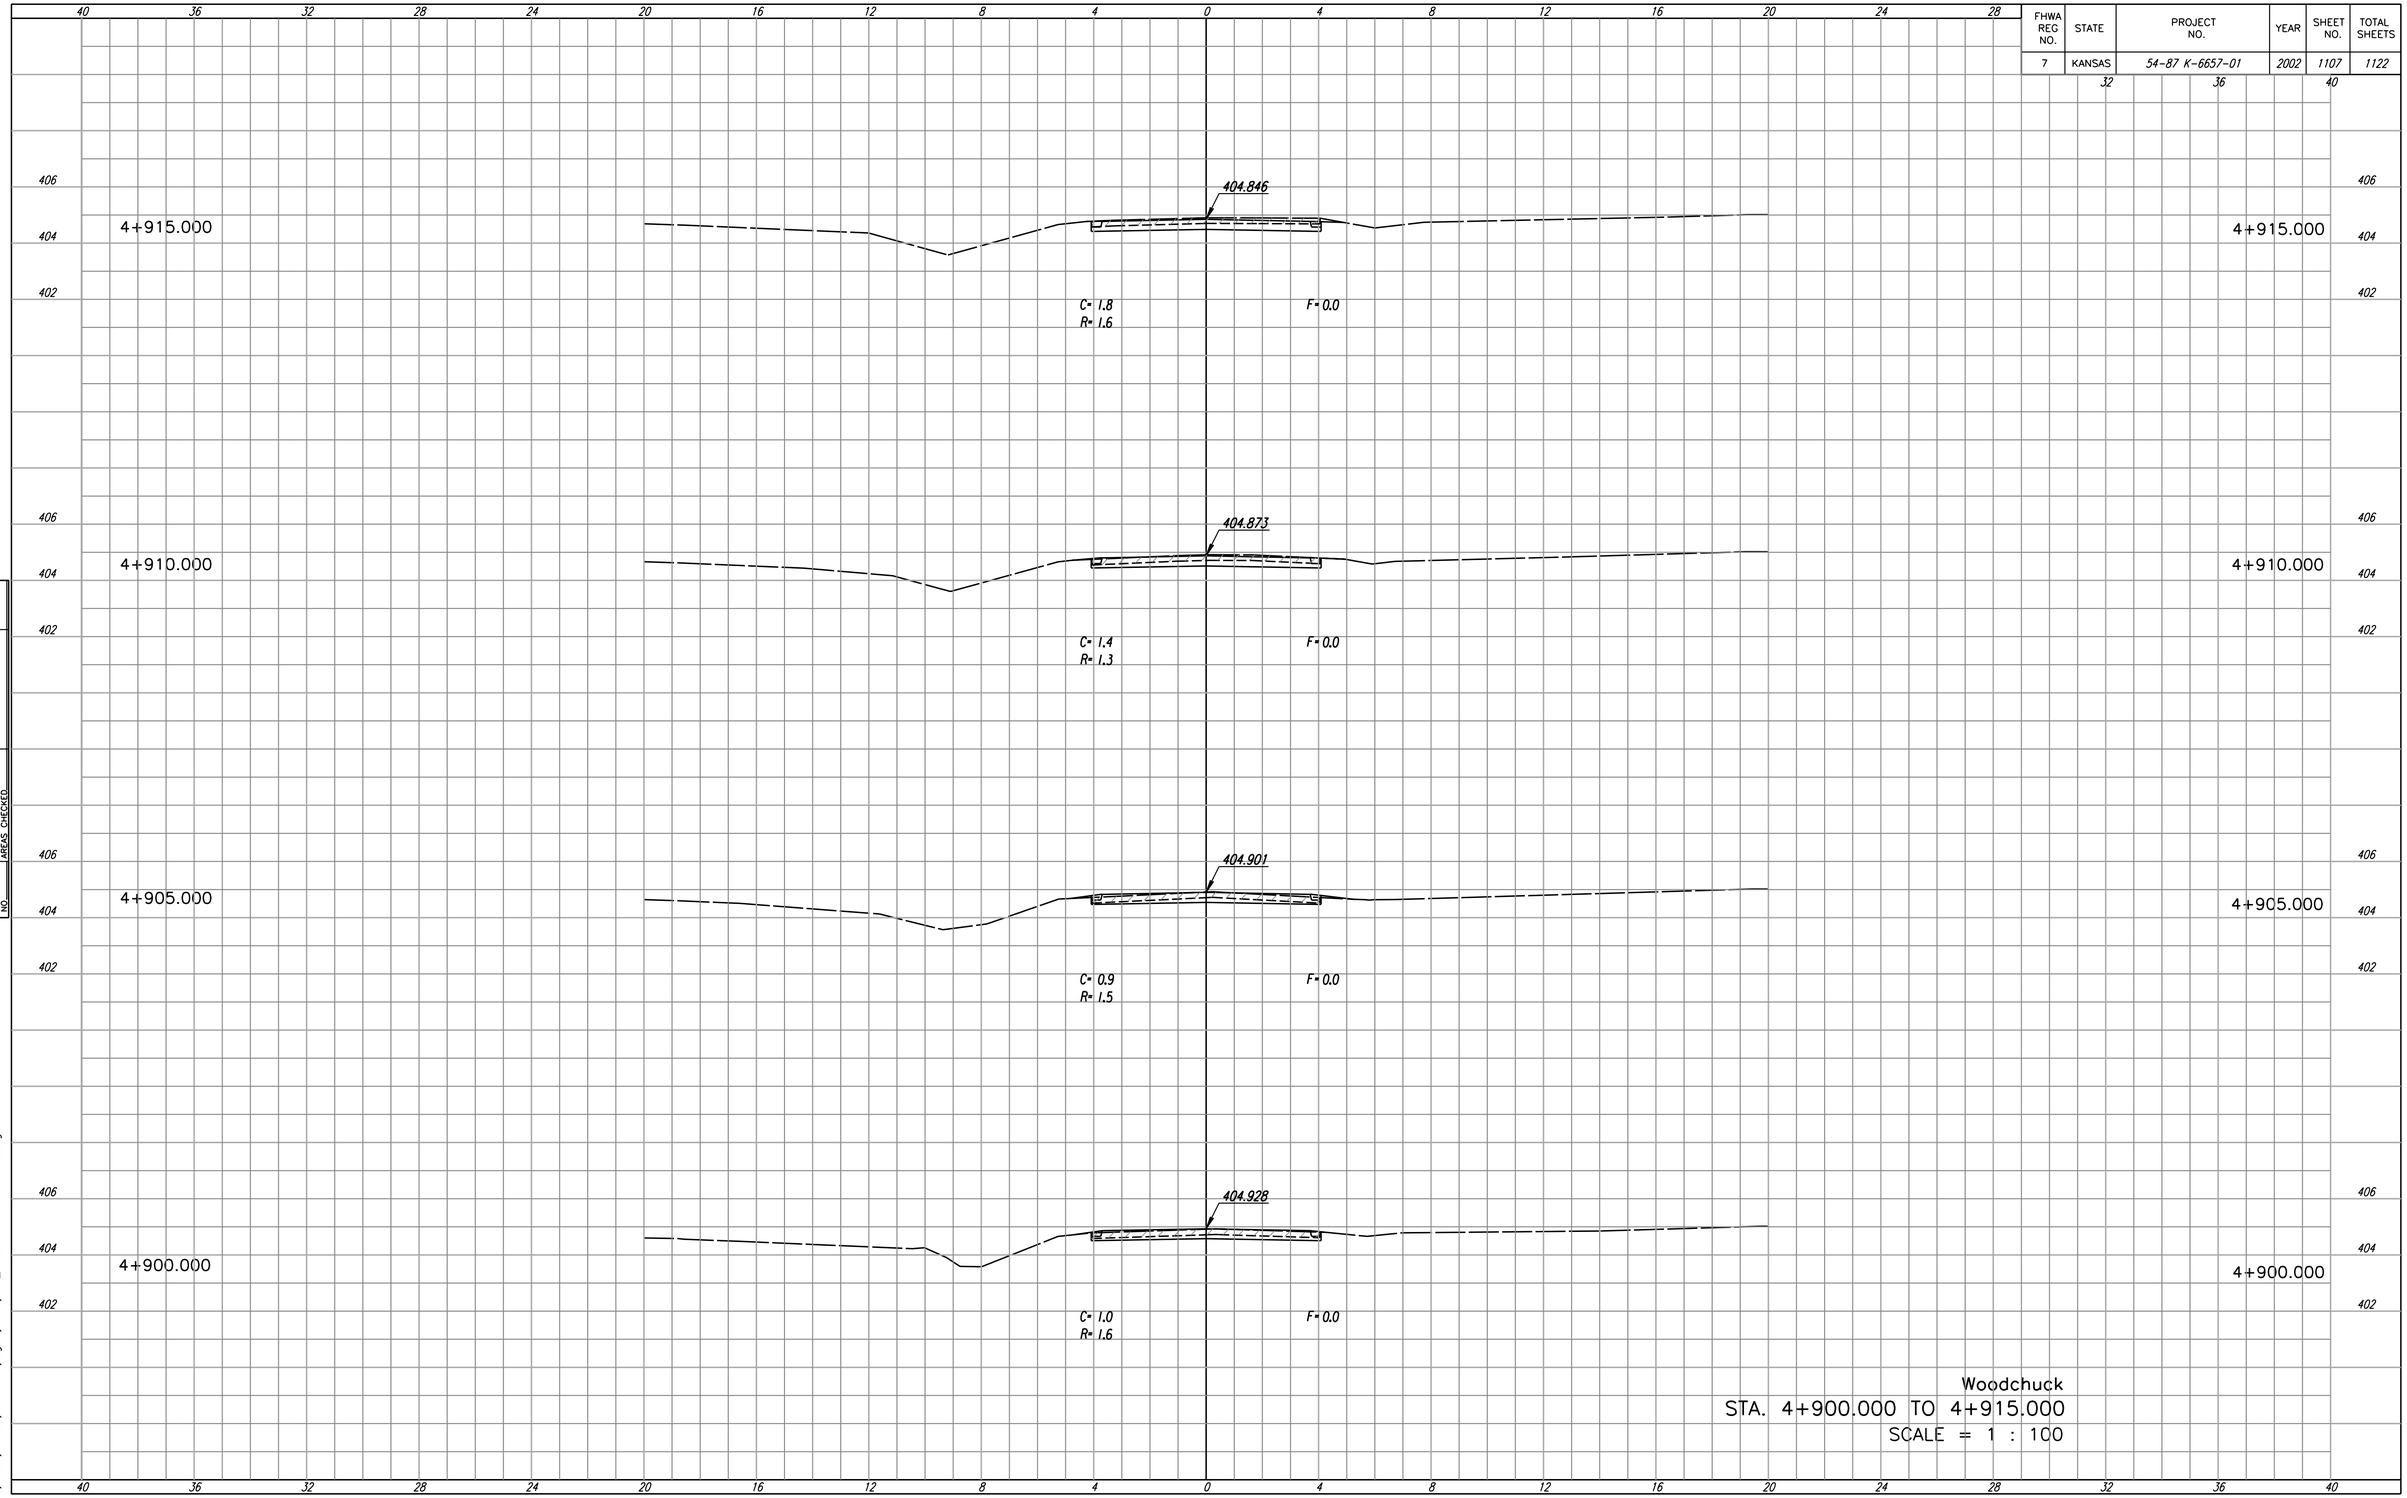

FINAL SURVEY		BY	DATE
	SURVEYED		
	PLOTTED		
NOTE BOOK	PLOTTED		
	AREAS		
NO.	AREAS CHECKED		

DSWR: RWM OPER:
t:/199/7/9362/As-builts/dgns/Vol.5/Sh_1107-Woodchuck-XS4900.dgn
SCALE: 1:100