FHWA REG NO.	STATE	PROJECT NO.	YEAR	SHEET NO.	TOTAL SHEETS
7	KANSAS	54-87 K-6657-01	2002	1110	1122

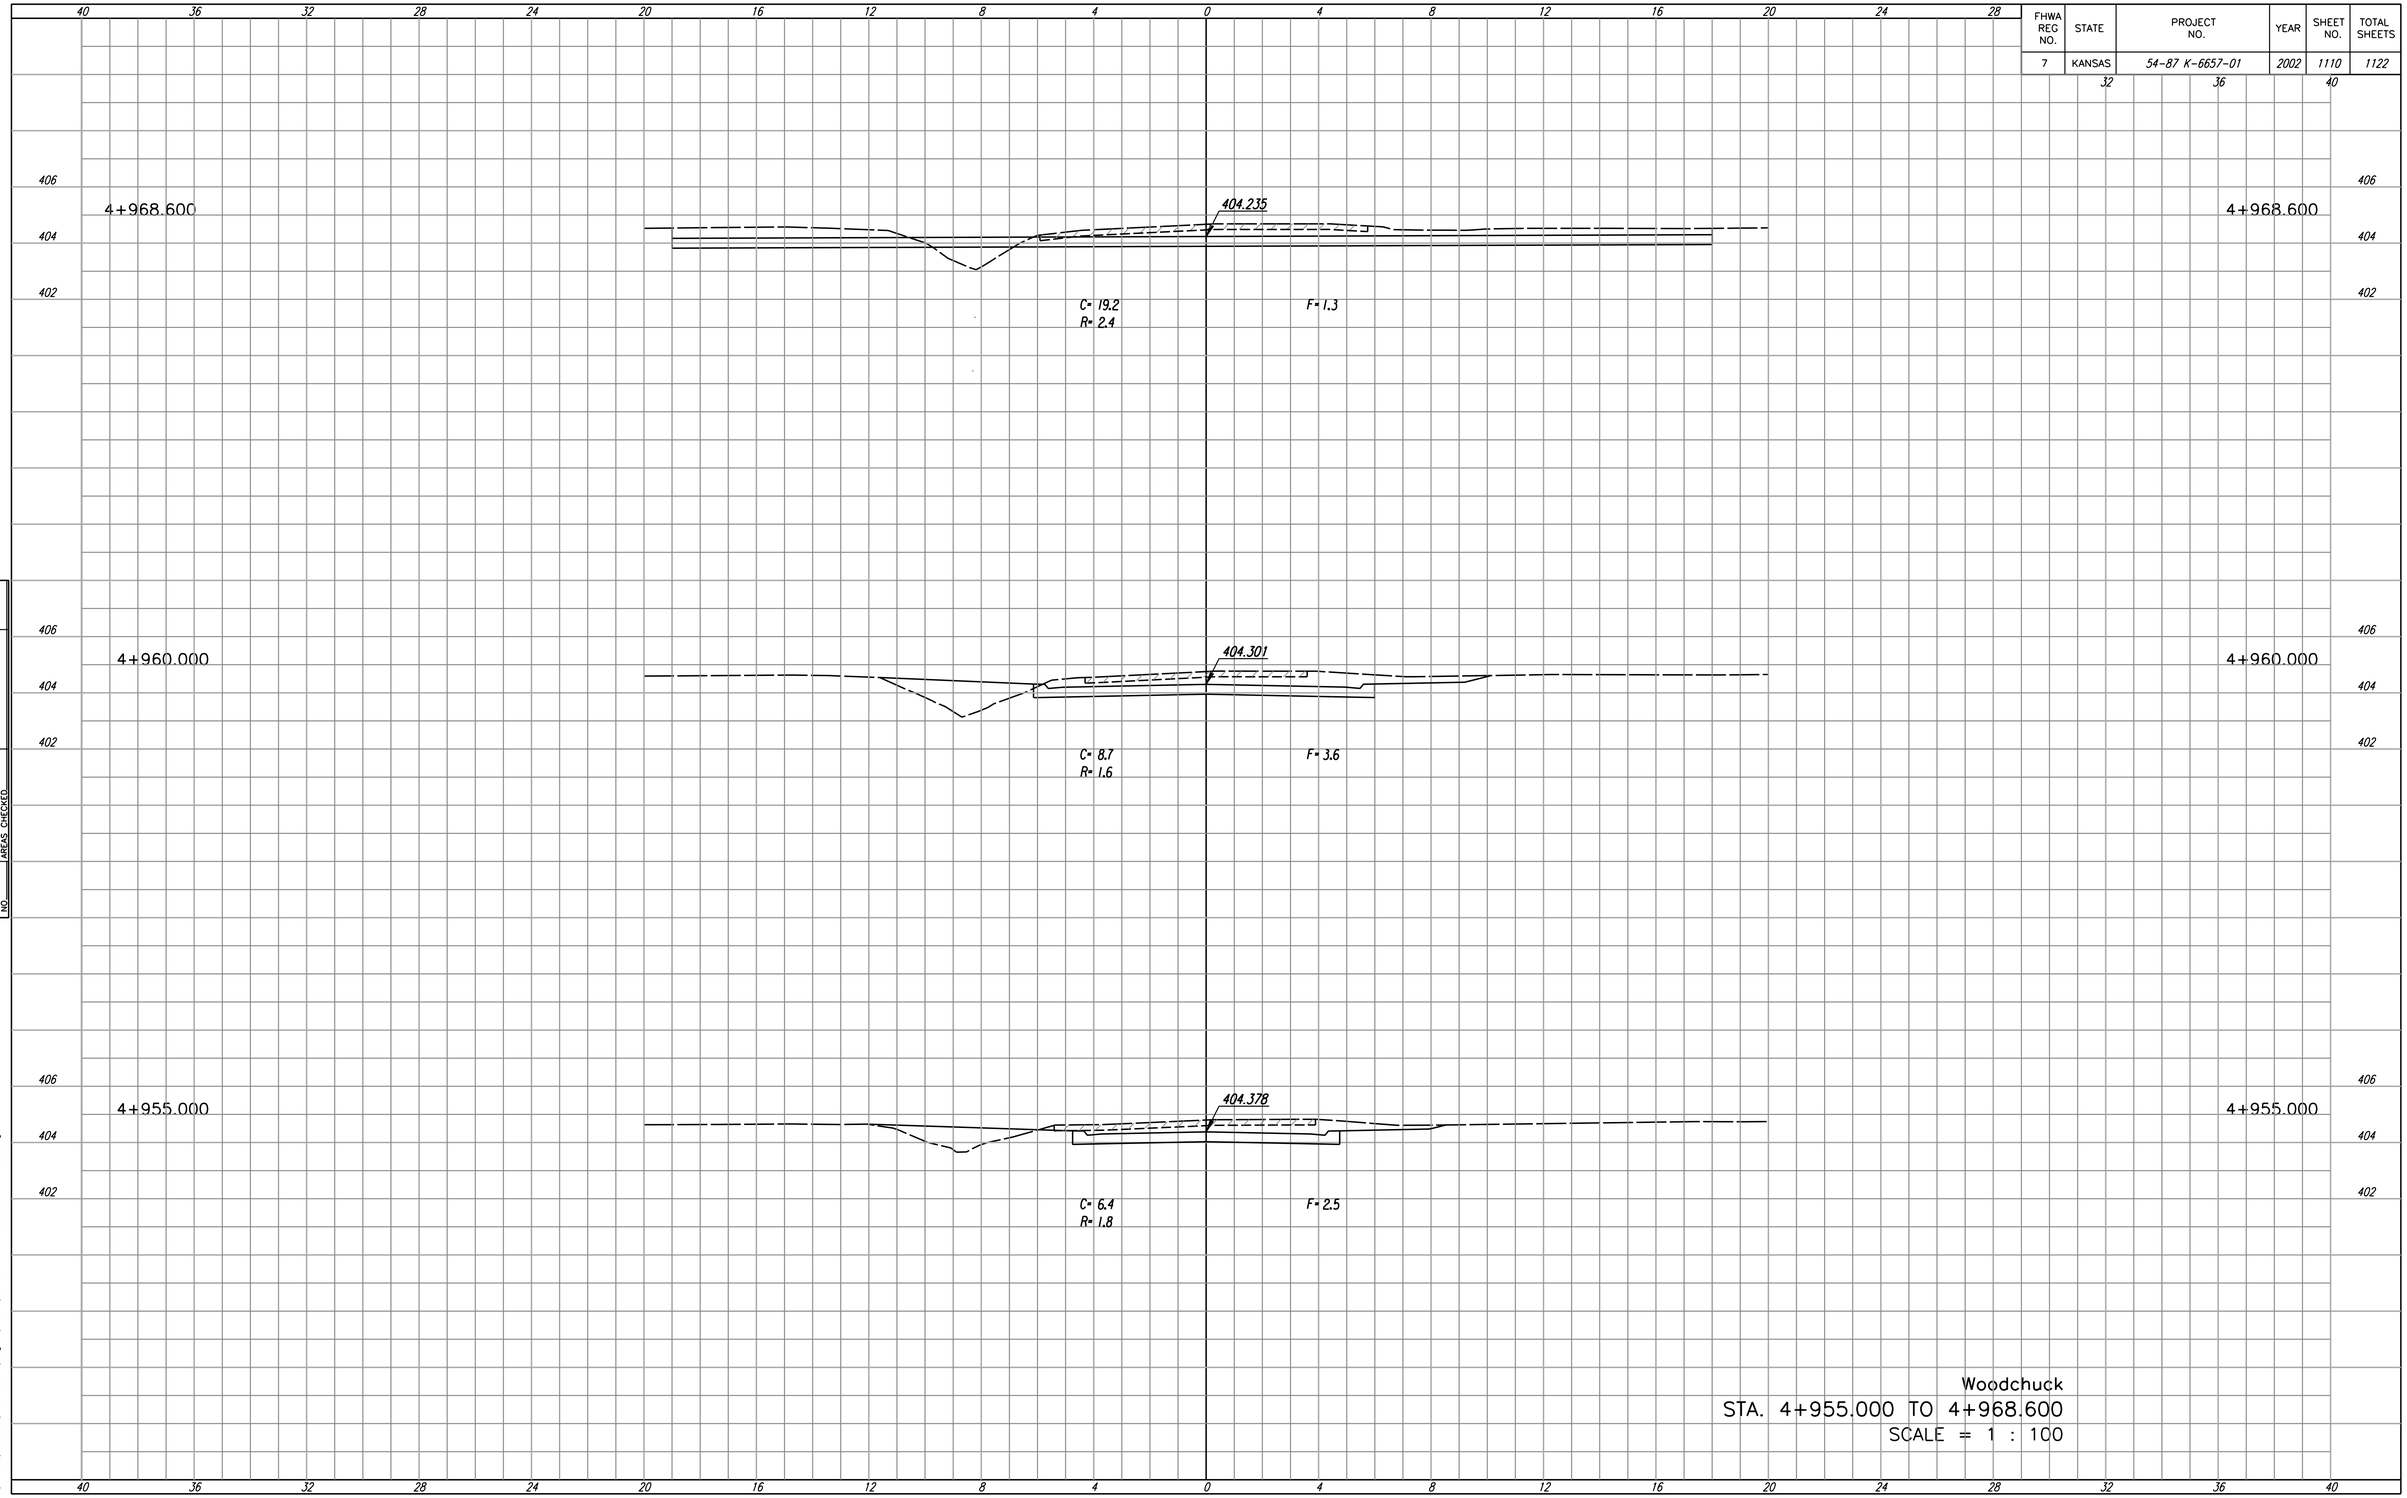

FINAL SURVEY		BY	DATE
	SURVEYED		
	PLOTTED		
NOTE BOOK	PLANIMETER AREAS		
NO.	AREAS CHECKED		

DSWR. RWM OPER.
I:/1997/97362/As-Builts/dgns/Vol.5/Sh_1110-Wdchuck-XS4955.dgn
SCALE: 1:100