FHWA REG NO.	STATE	PROJECT NO.	YEAR	SHEET NO.	TOTAL SHEETS
7	KANSAS	54-87 K-6657-01	2002	1112	1122

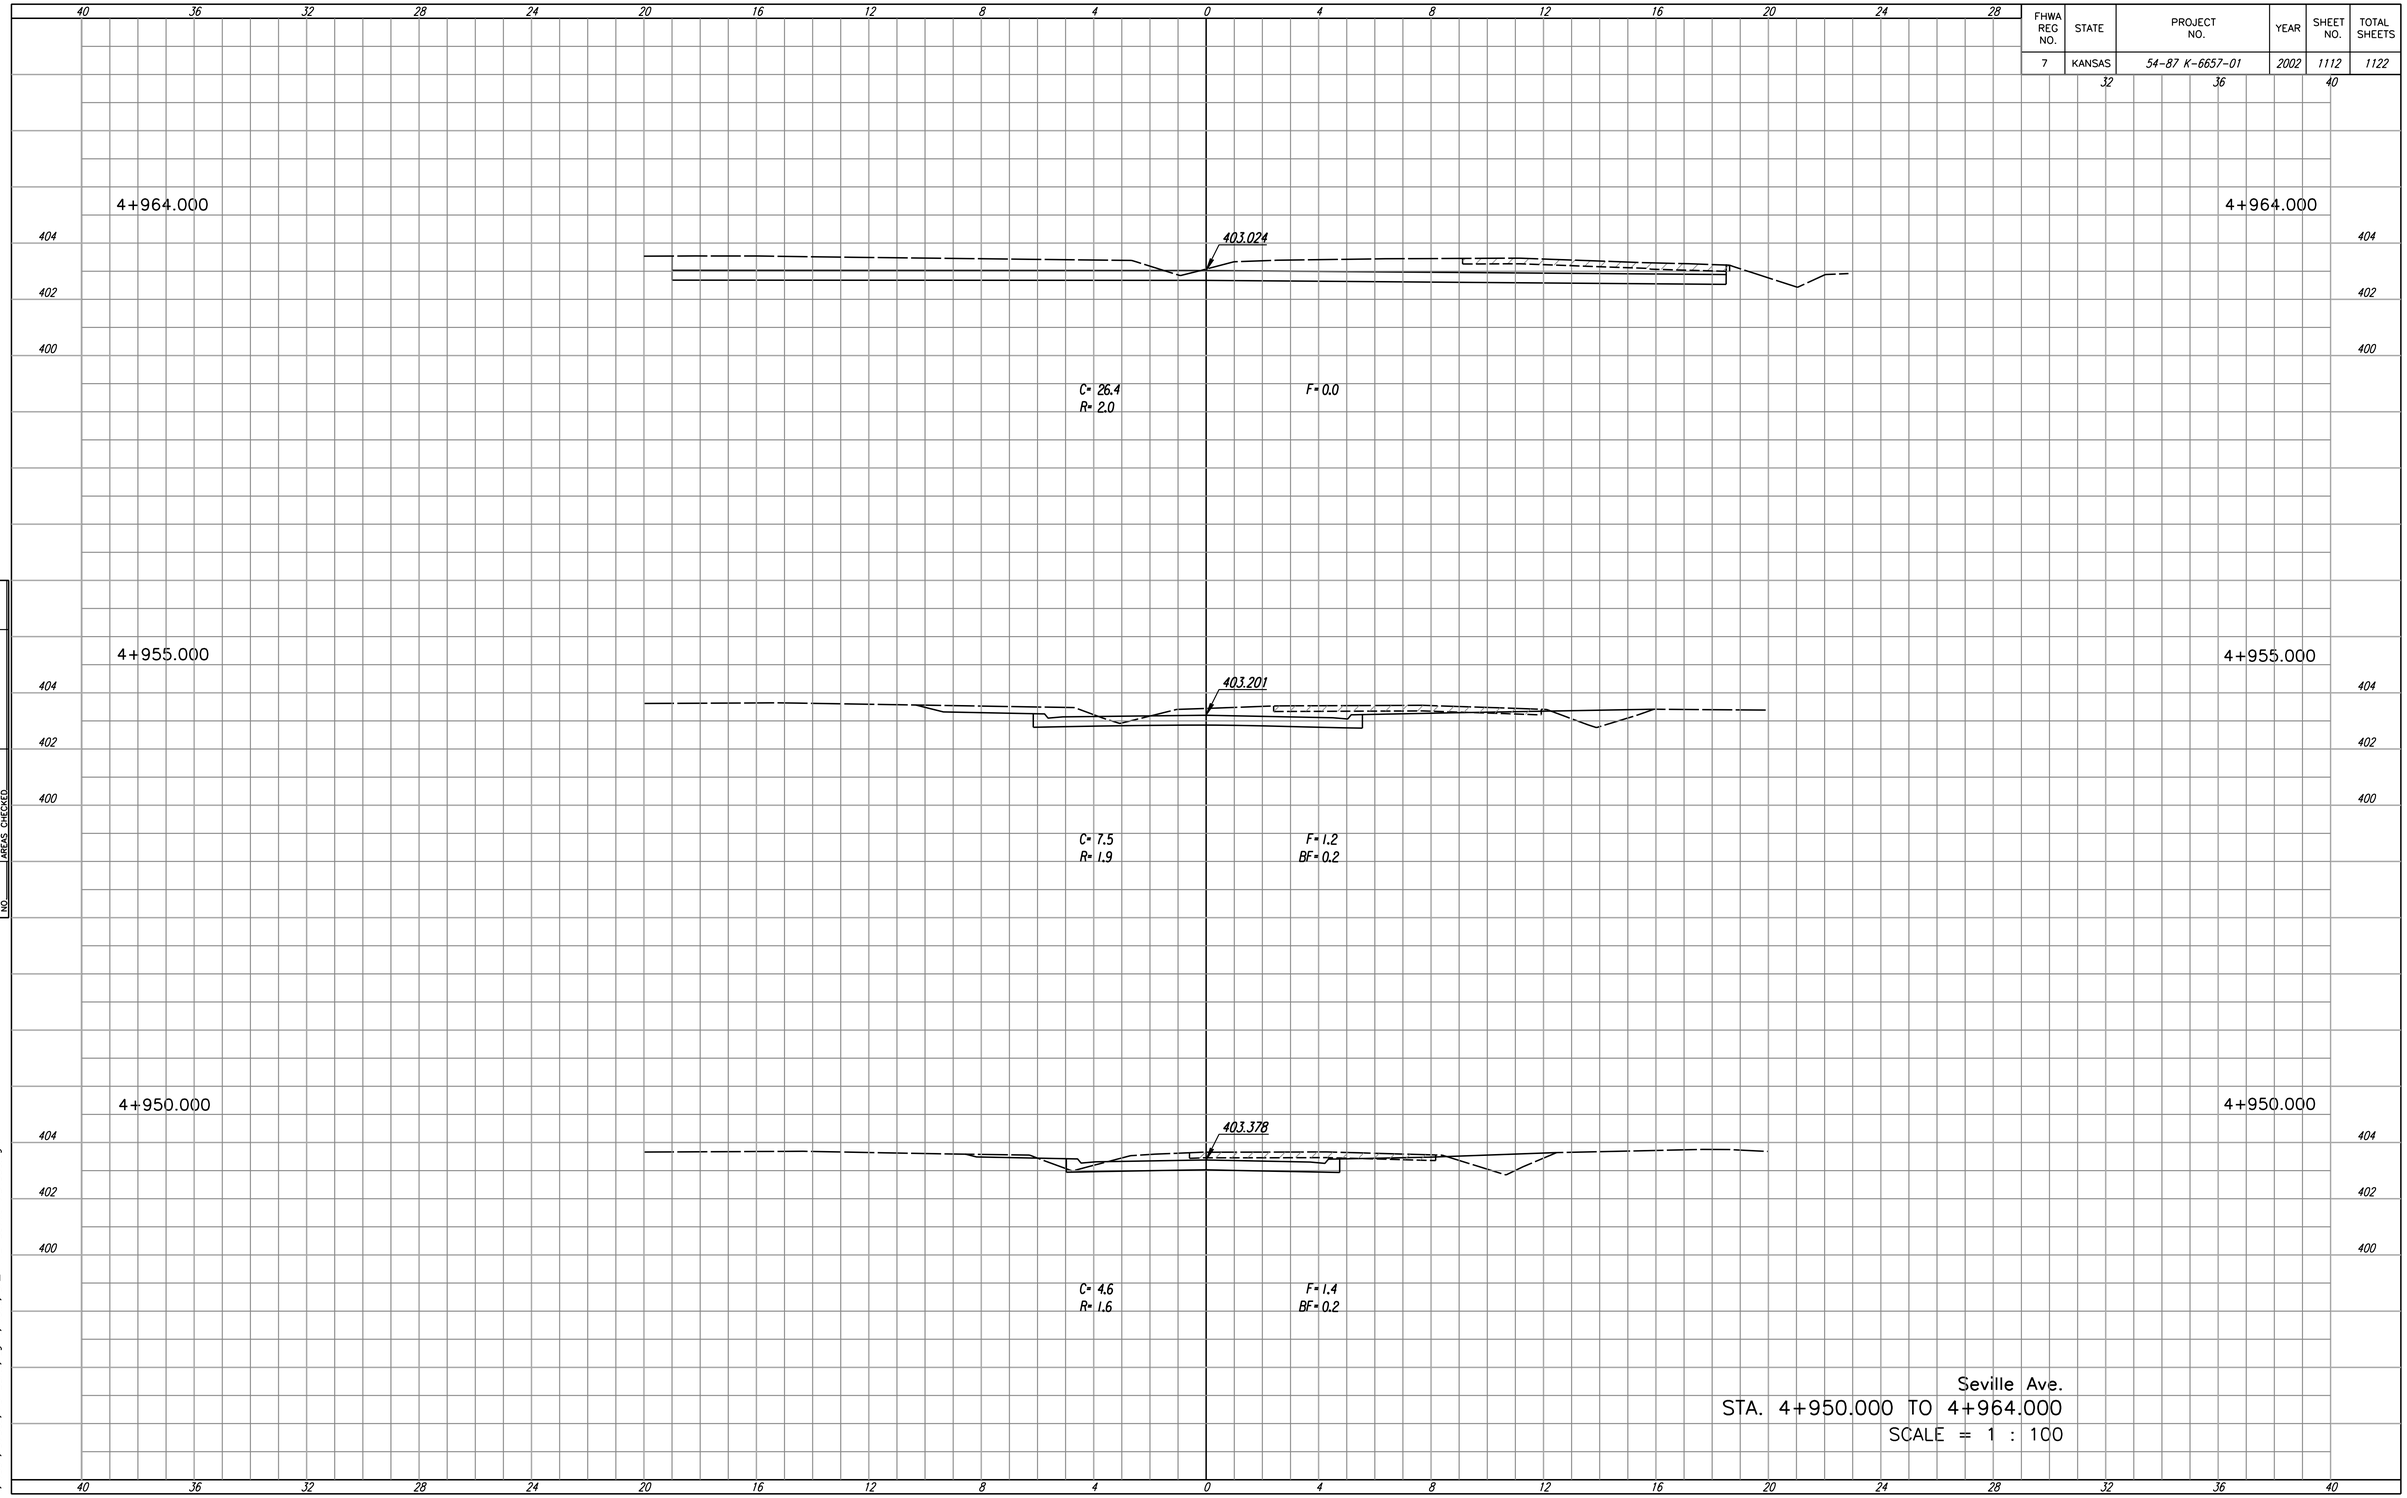

FINAL SURVEY		DATE
	SURVEYED	
	PLOTTED	
NOTE BOOK	PLOTTED	BY
	AREAS	
NO.	AREAS CHECKED	

DSWR: RWM OPER:
SCALE: 1:100
I:/199/7/9/362/As-Builts/dgns/Vol.5/Sh_1112-Seville-XS4950.dgn