FHWA REG NO.	STATE	PROJECT NO.	YEAR	SHEET NO.	TOTAL SHEETS
7	KANSAS	54-87 K-6657-01	2002	1119	1122

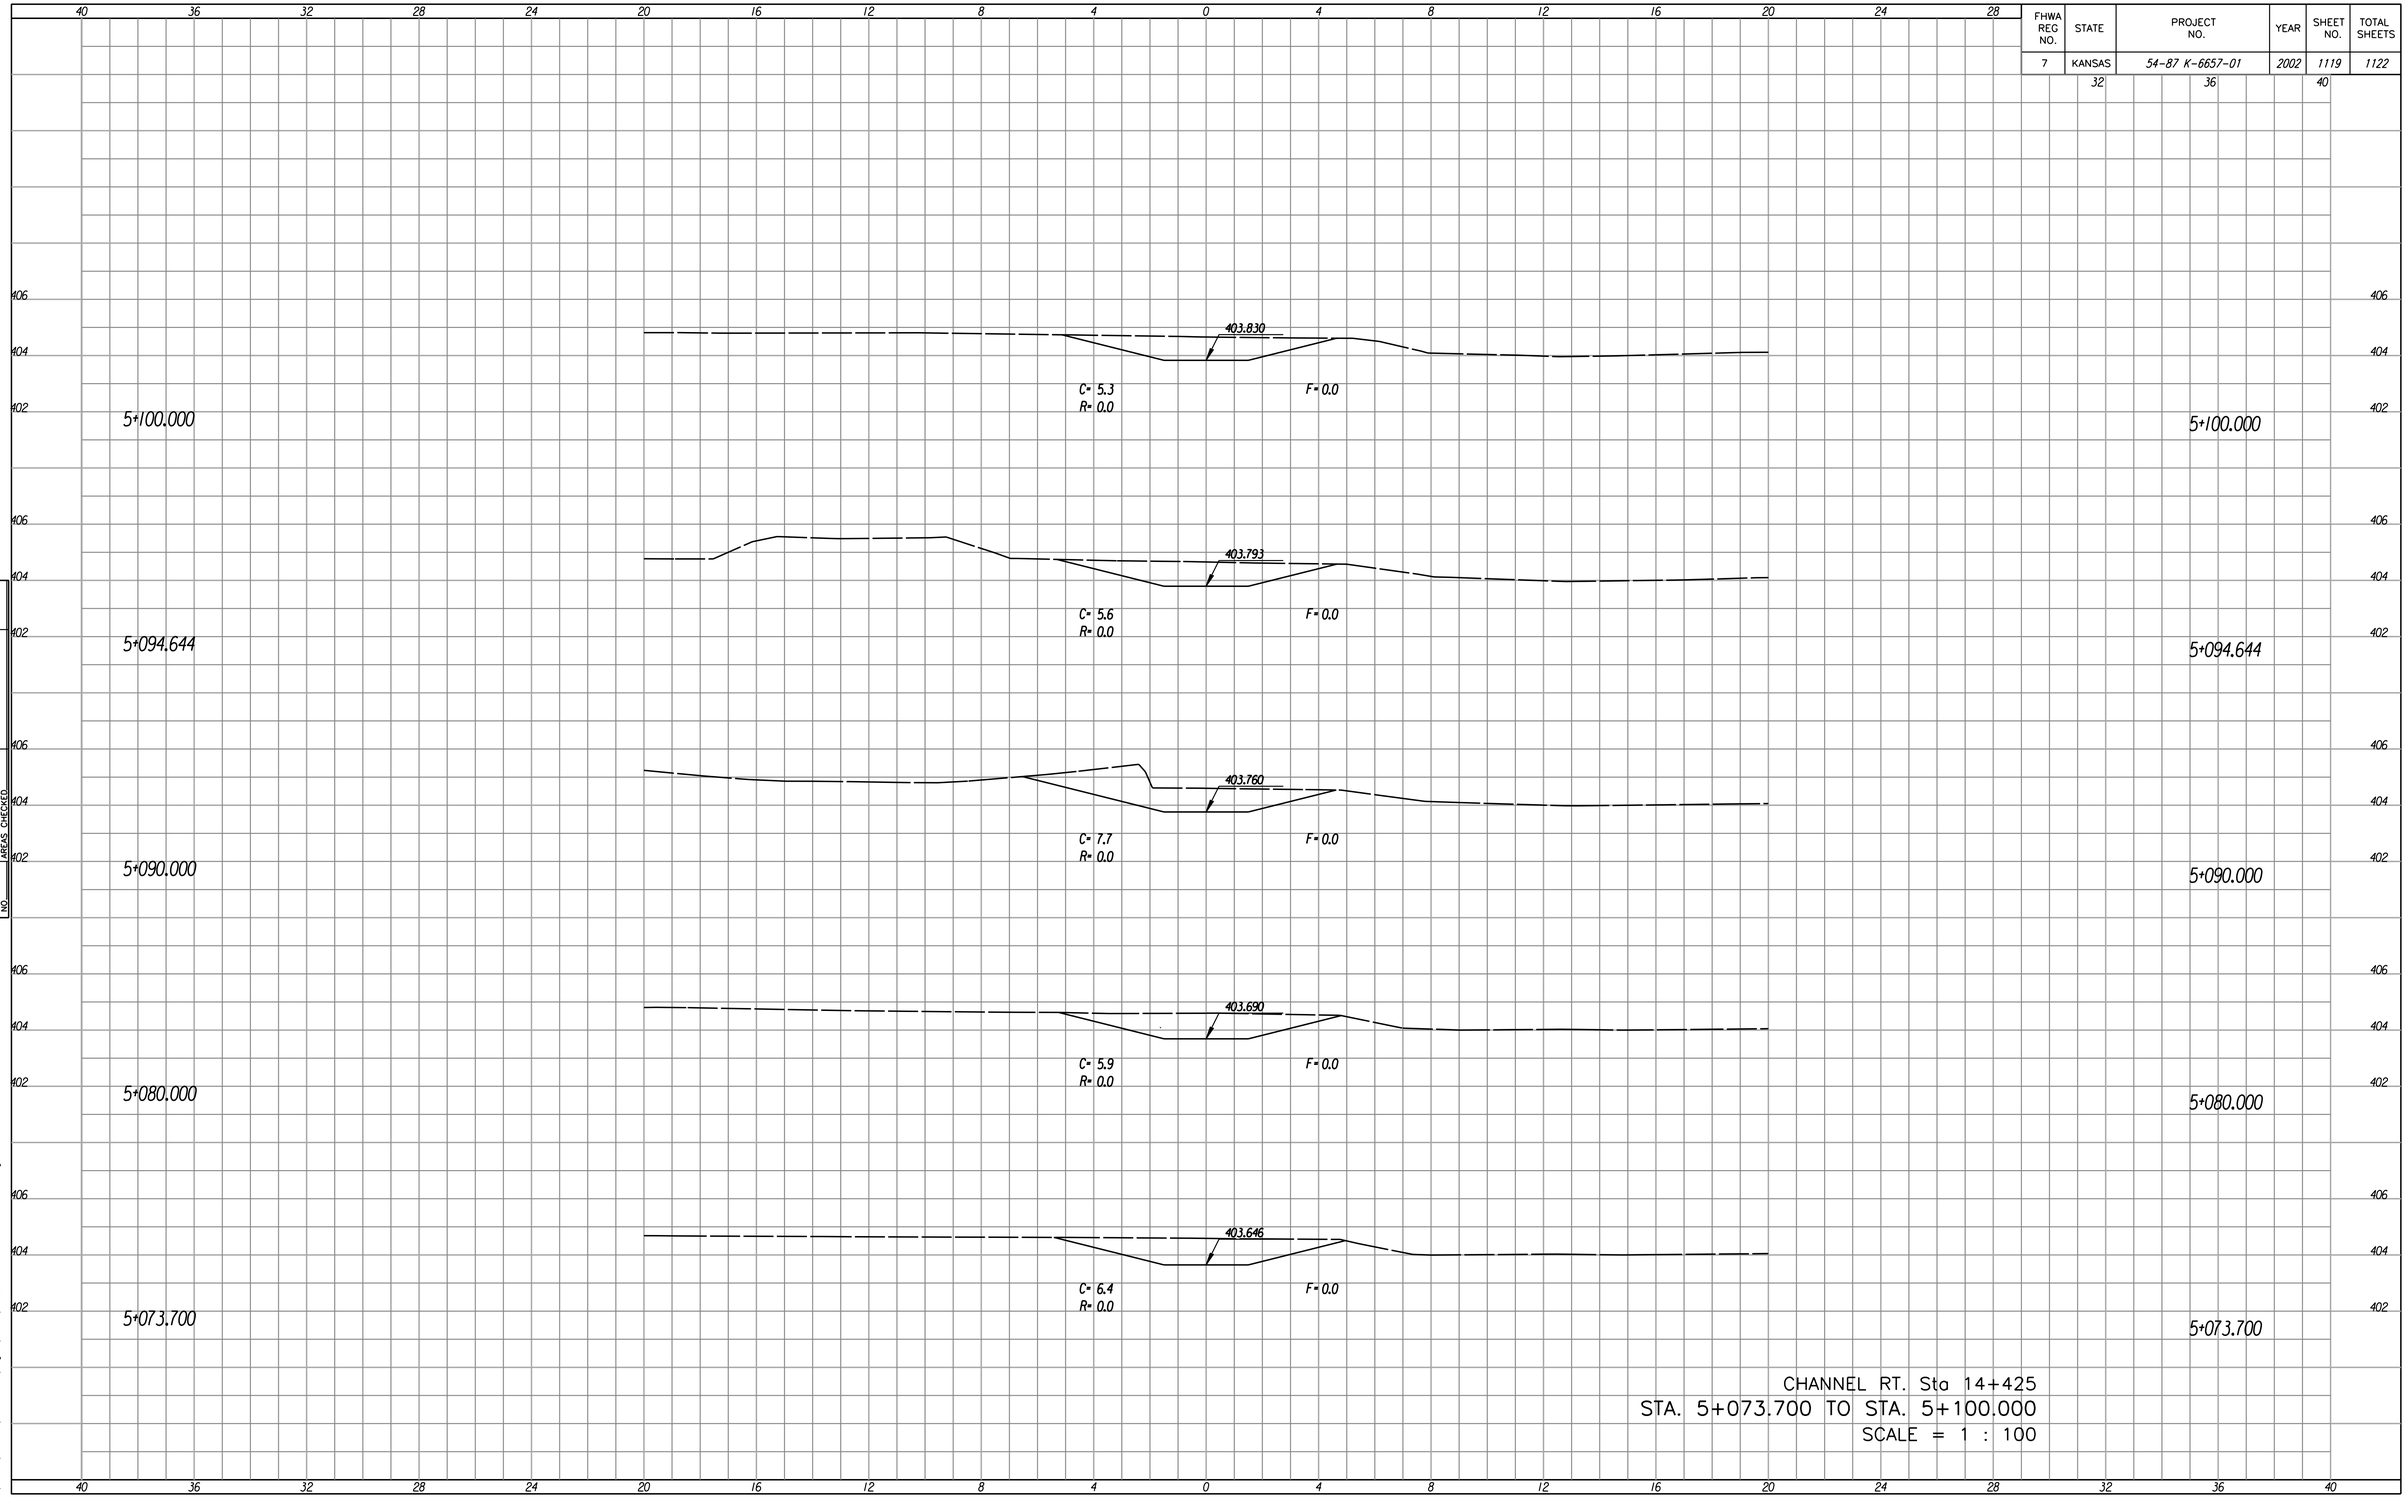

NO.	FINAL SURVEY	BY	DATE
	SURVEYED		
	PLOTTED		
	TRAVERSE		
	AREAS		
	AREAS CHECKED		

NOTE BOOK

Dsnr: RWM Oper: Scale: 1:100
I:/1997/97362/As-Builts/dgn's/Vol.5/Sht_1119-Channel-KS5073.dgn