FHWA REG NO.	STATE	PROJECT NO.	YEAR	SHEET NO.	TOTAL SHEETS
7	KANSAS	54-87 K-6657-01	2002	1120	1122

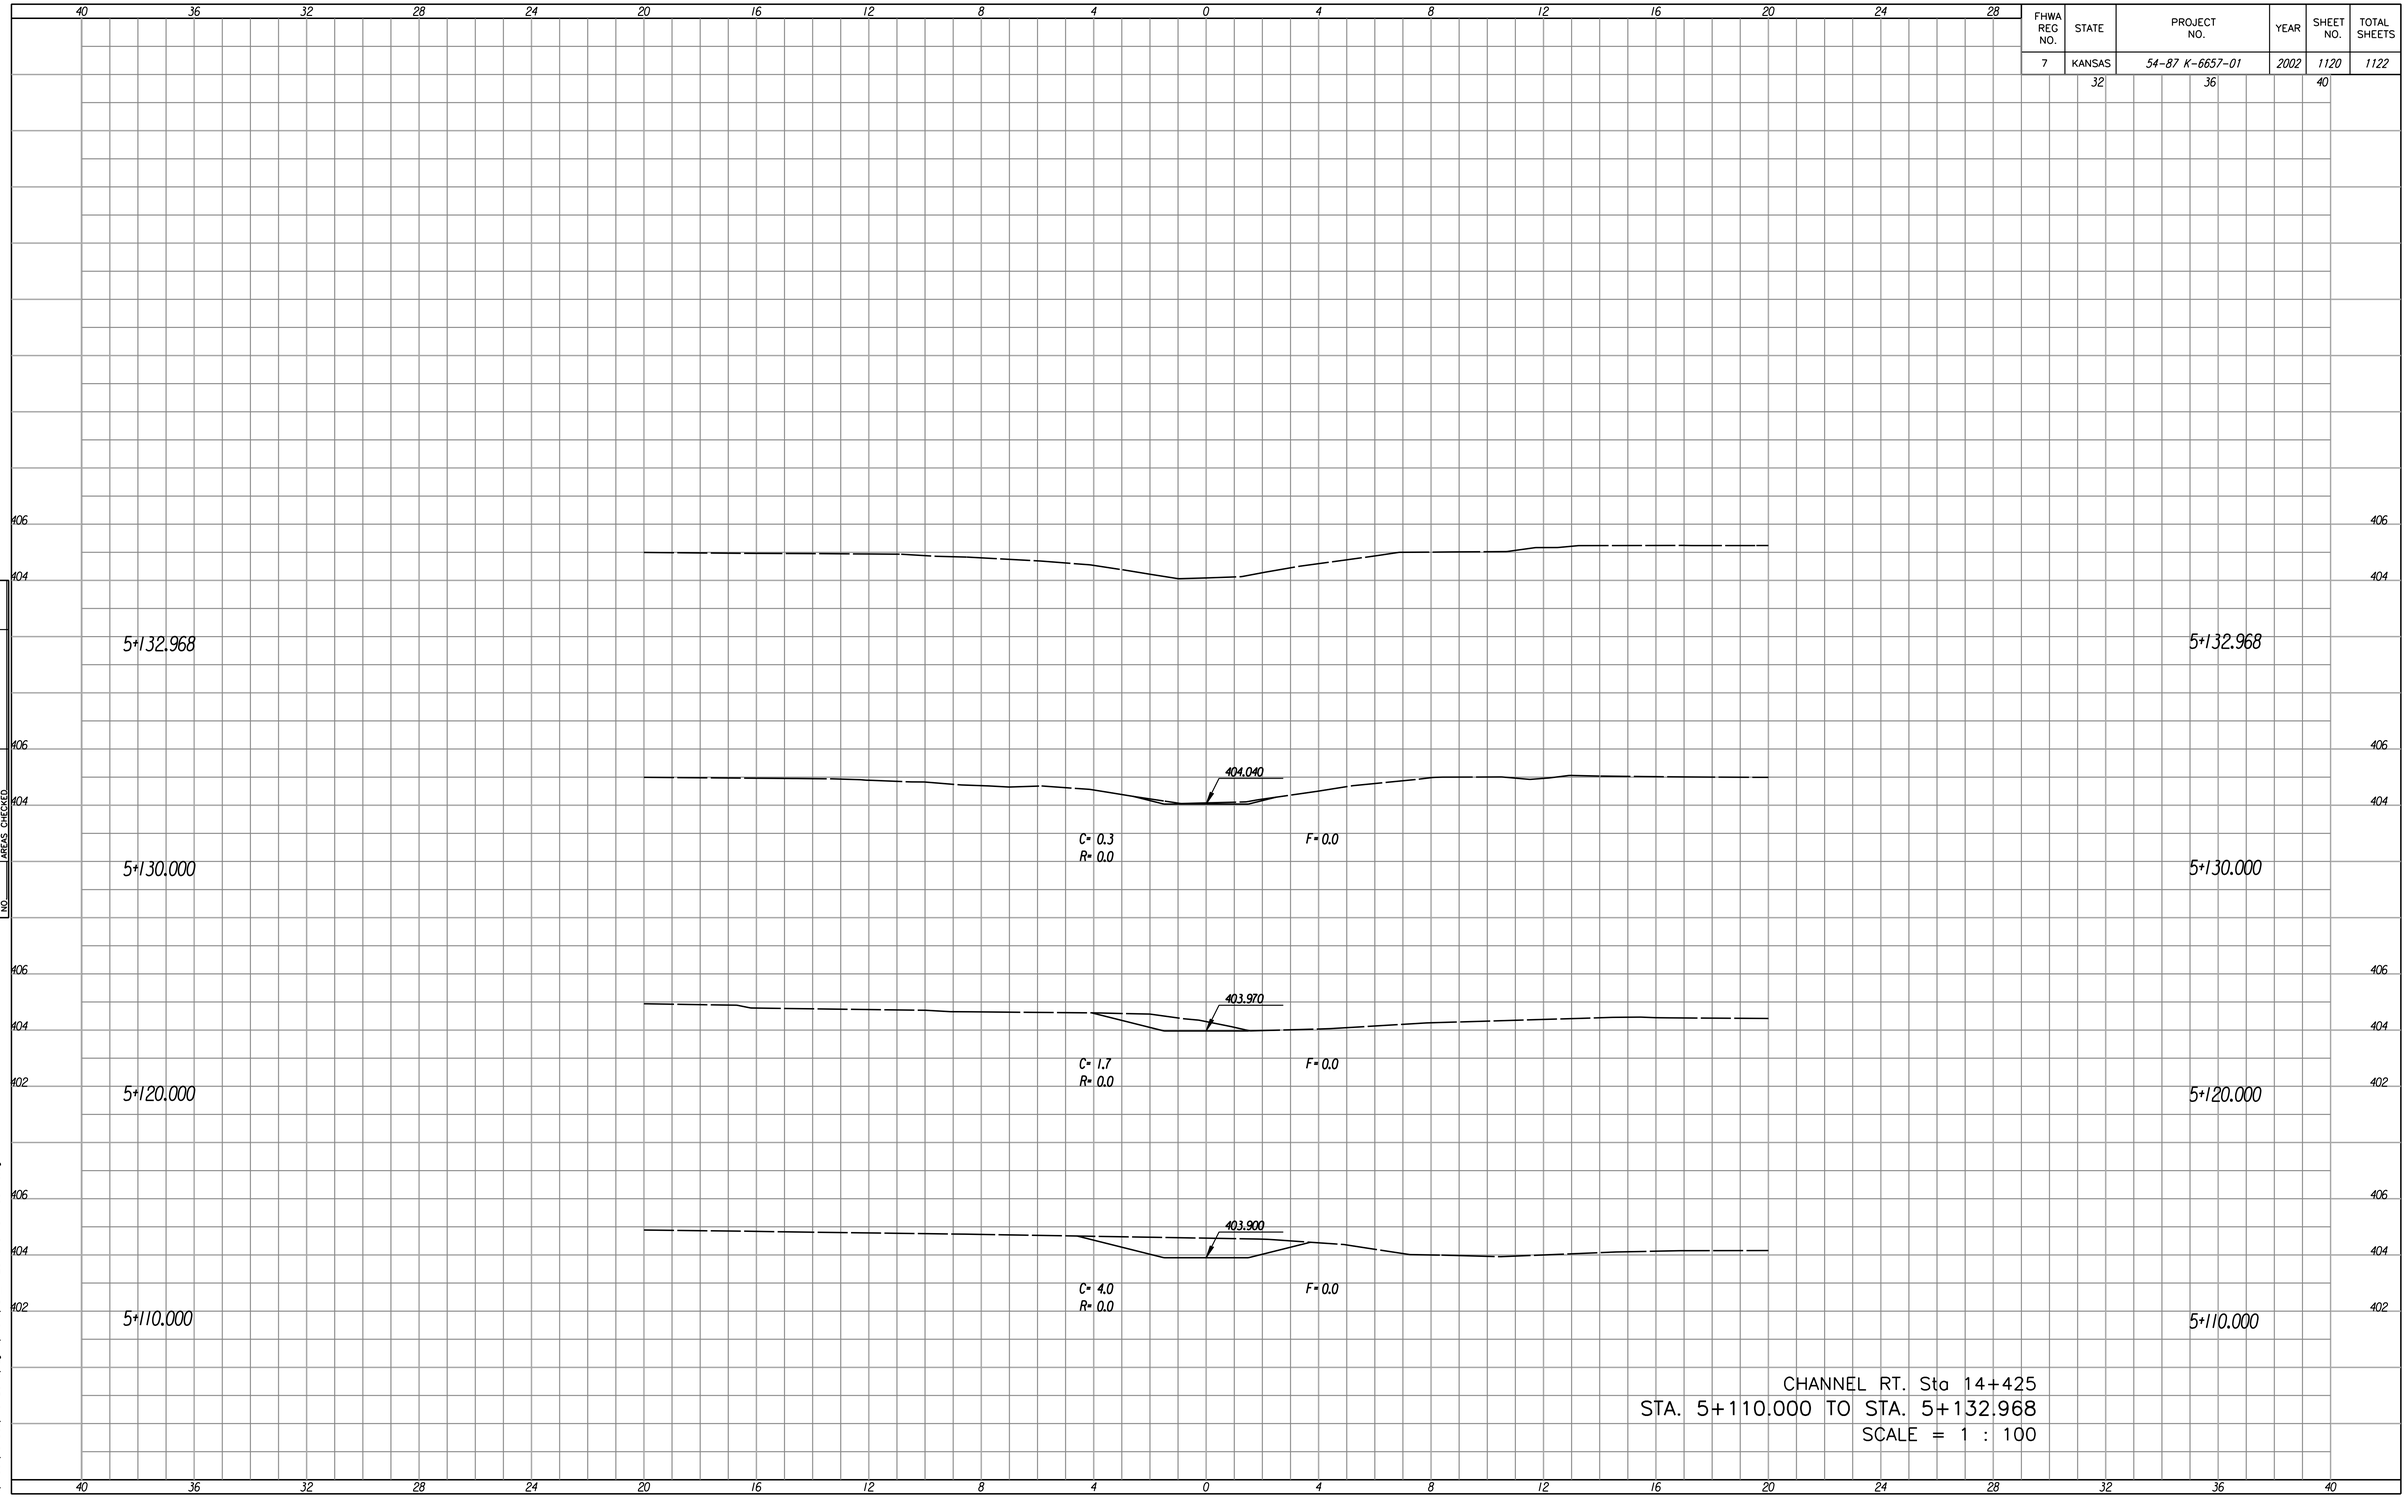

FINAL SURVEY		BY	DATE
	SURVEYED		
	PLOTTED		
NOTE BOOK	TRIANGULATE		
	AREAS		
NO.	AREAS CHECKED		

Dsnr: RWM Oper:
I:/1997/97362/As-Builts/dgn's/Vol.5/Sht_1120-Channel-XS5110.dgn
Scale: 1:100