


FHWA REGION NO.	STATE	PROJECT NUMBER	FISCAL YEAR	SHEET NUMBER	TOTAL SHEETS
7	KANSAS	87N-0245-01	2007	18	55

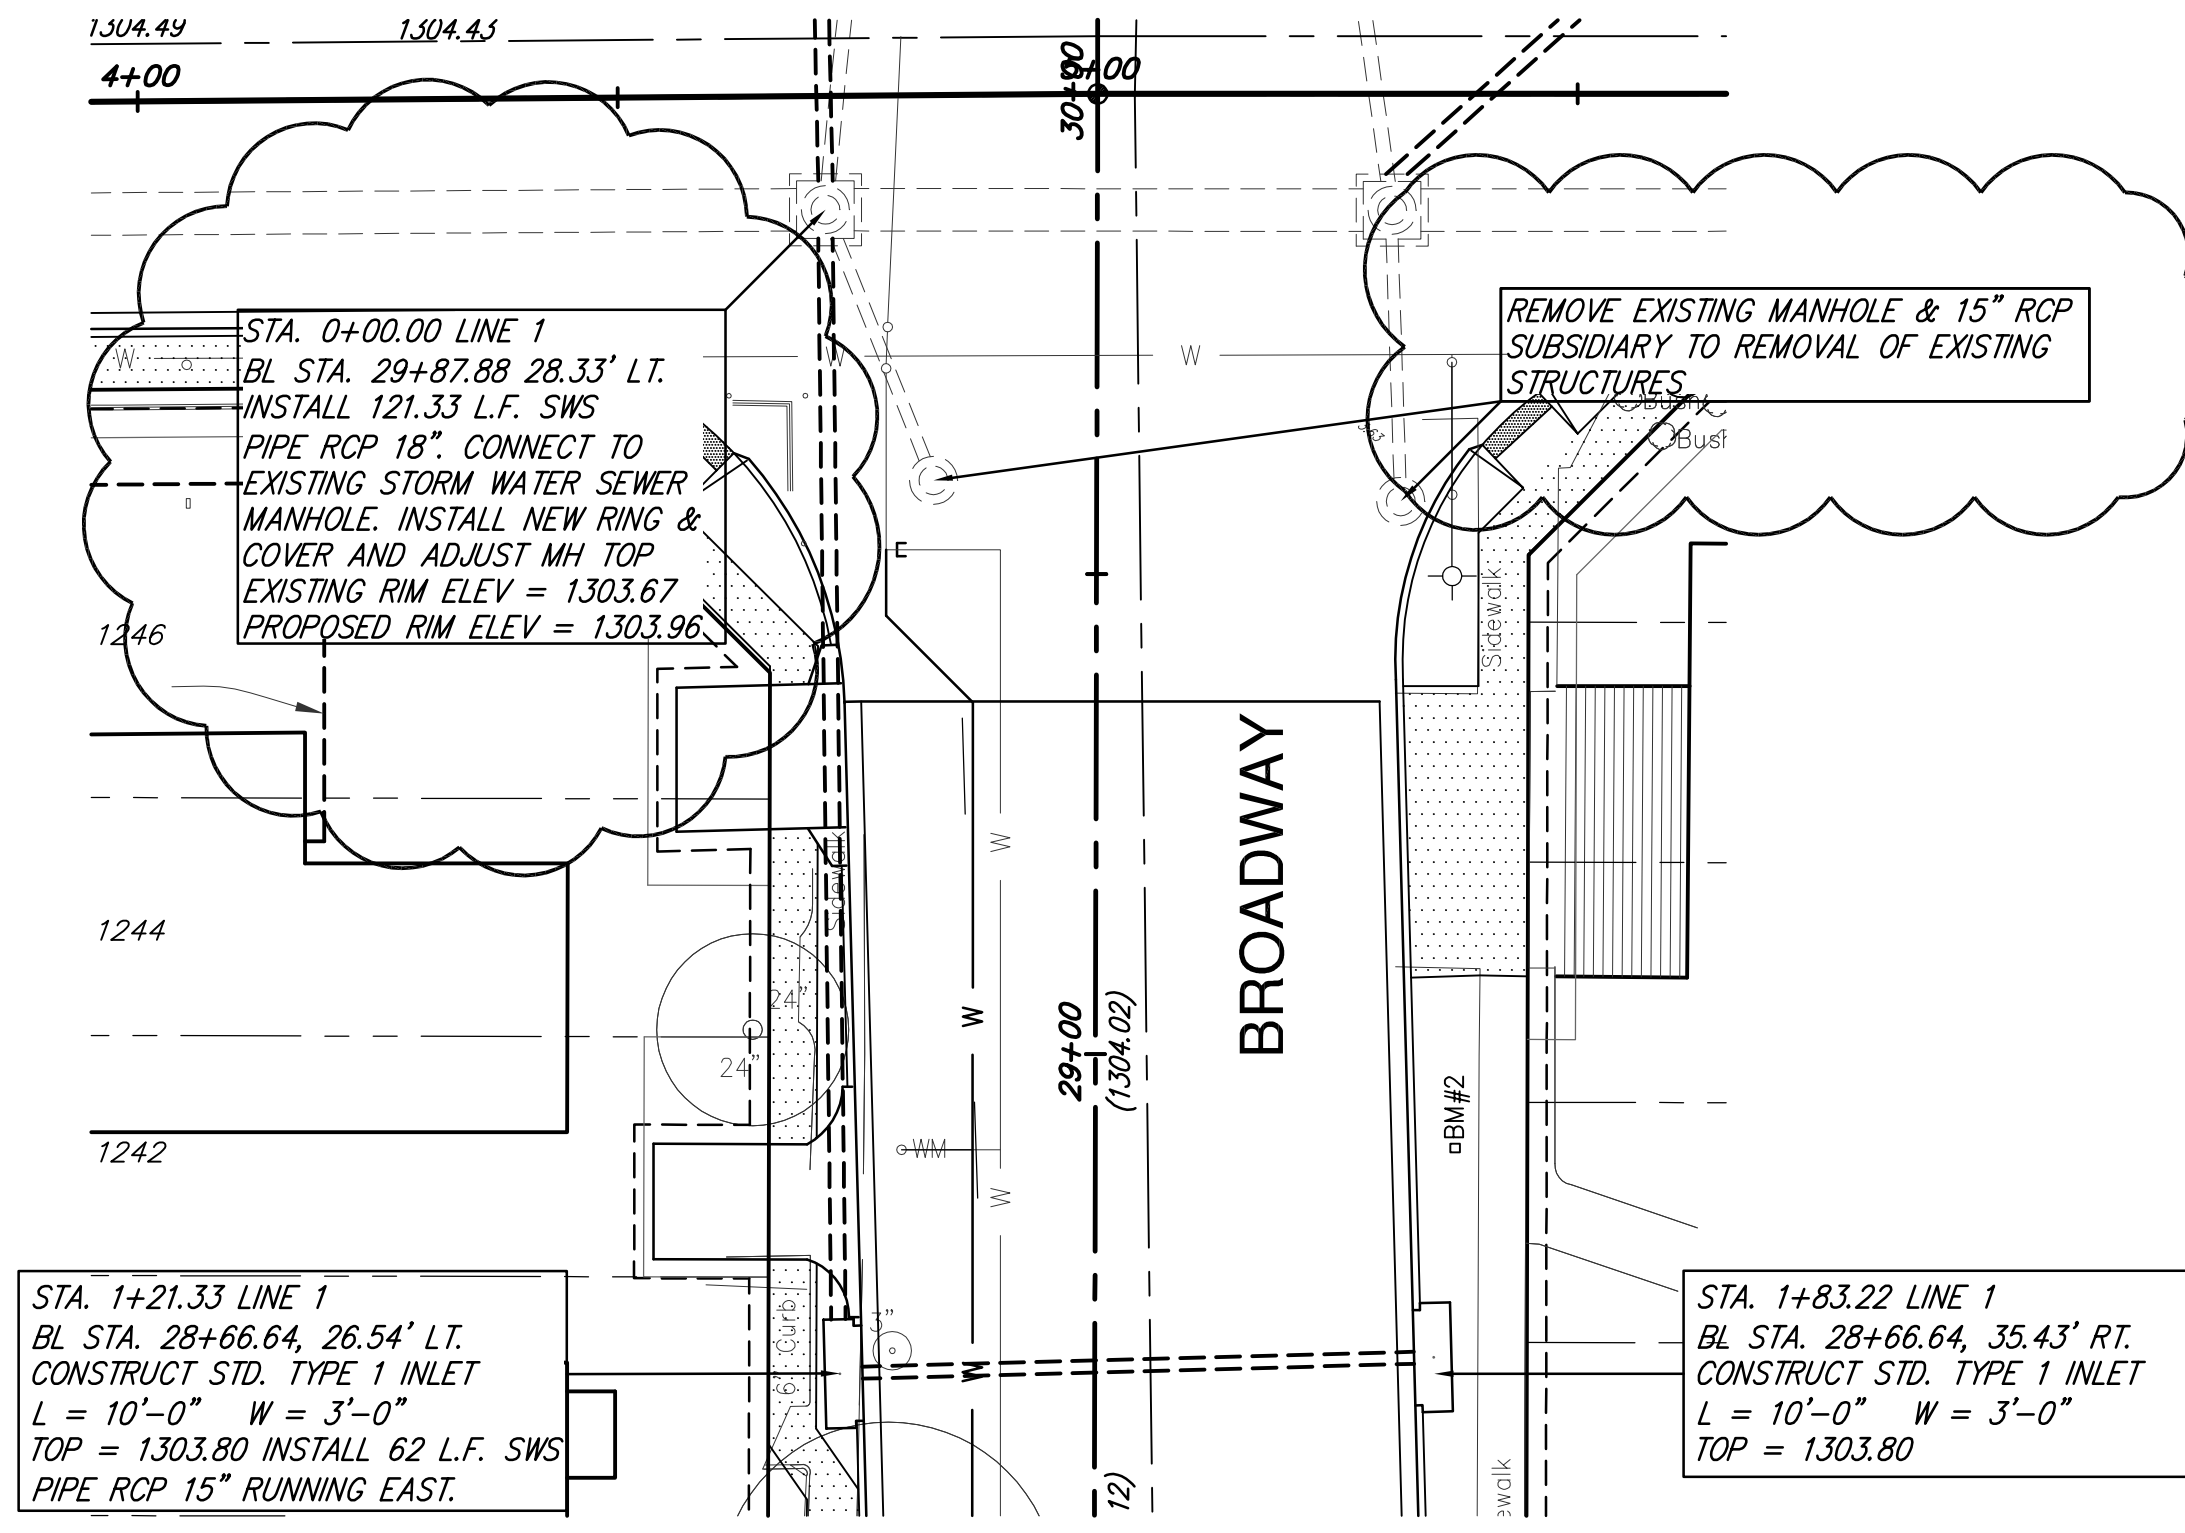


STA. 1+21.33 LINE 1  
 BL STA. 28+66.64, 26.54' LT.  
 CONSTRUCT STD. TYPE 1 INLET  
 L = 10'-0" W = 3'-0"  
 TOP = 1303.80 INSTALL 62 L.F. SWS  
 PIPE RCP 15" RUNNING EAST.

STA. 1+83.22 LINE 1  
 BL STA. 28+66.64, 35.43' RT.  
 CONSTRUCT STD. TYPE 1 INLET  
 L = 10'-0" W = 3'-0"  
 TOP = 1303.80



LINE 1

ALL UTILITY LINES EXPOSED DURING CONSTRUCTION SHALL BE SUPPORTED WHILE EXPOSED. METHOD TO BE APPROVED BY FIELD ENGINEER.

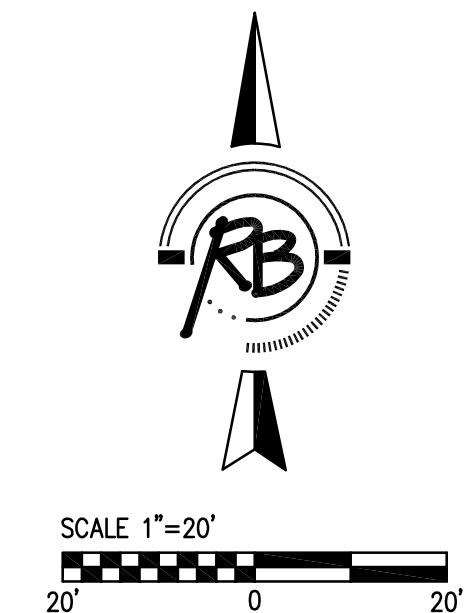

REVISED: 12/14/07

**Ruggles & Bohm, P.A.**  
 Engineering, Surveying, Land Planning  
 524 North Main  
 Wichita, Kansas 67203  
 Phone: 316.261.0008  
 Fax: 316.261.0009  
 Email: info@ruggles.com

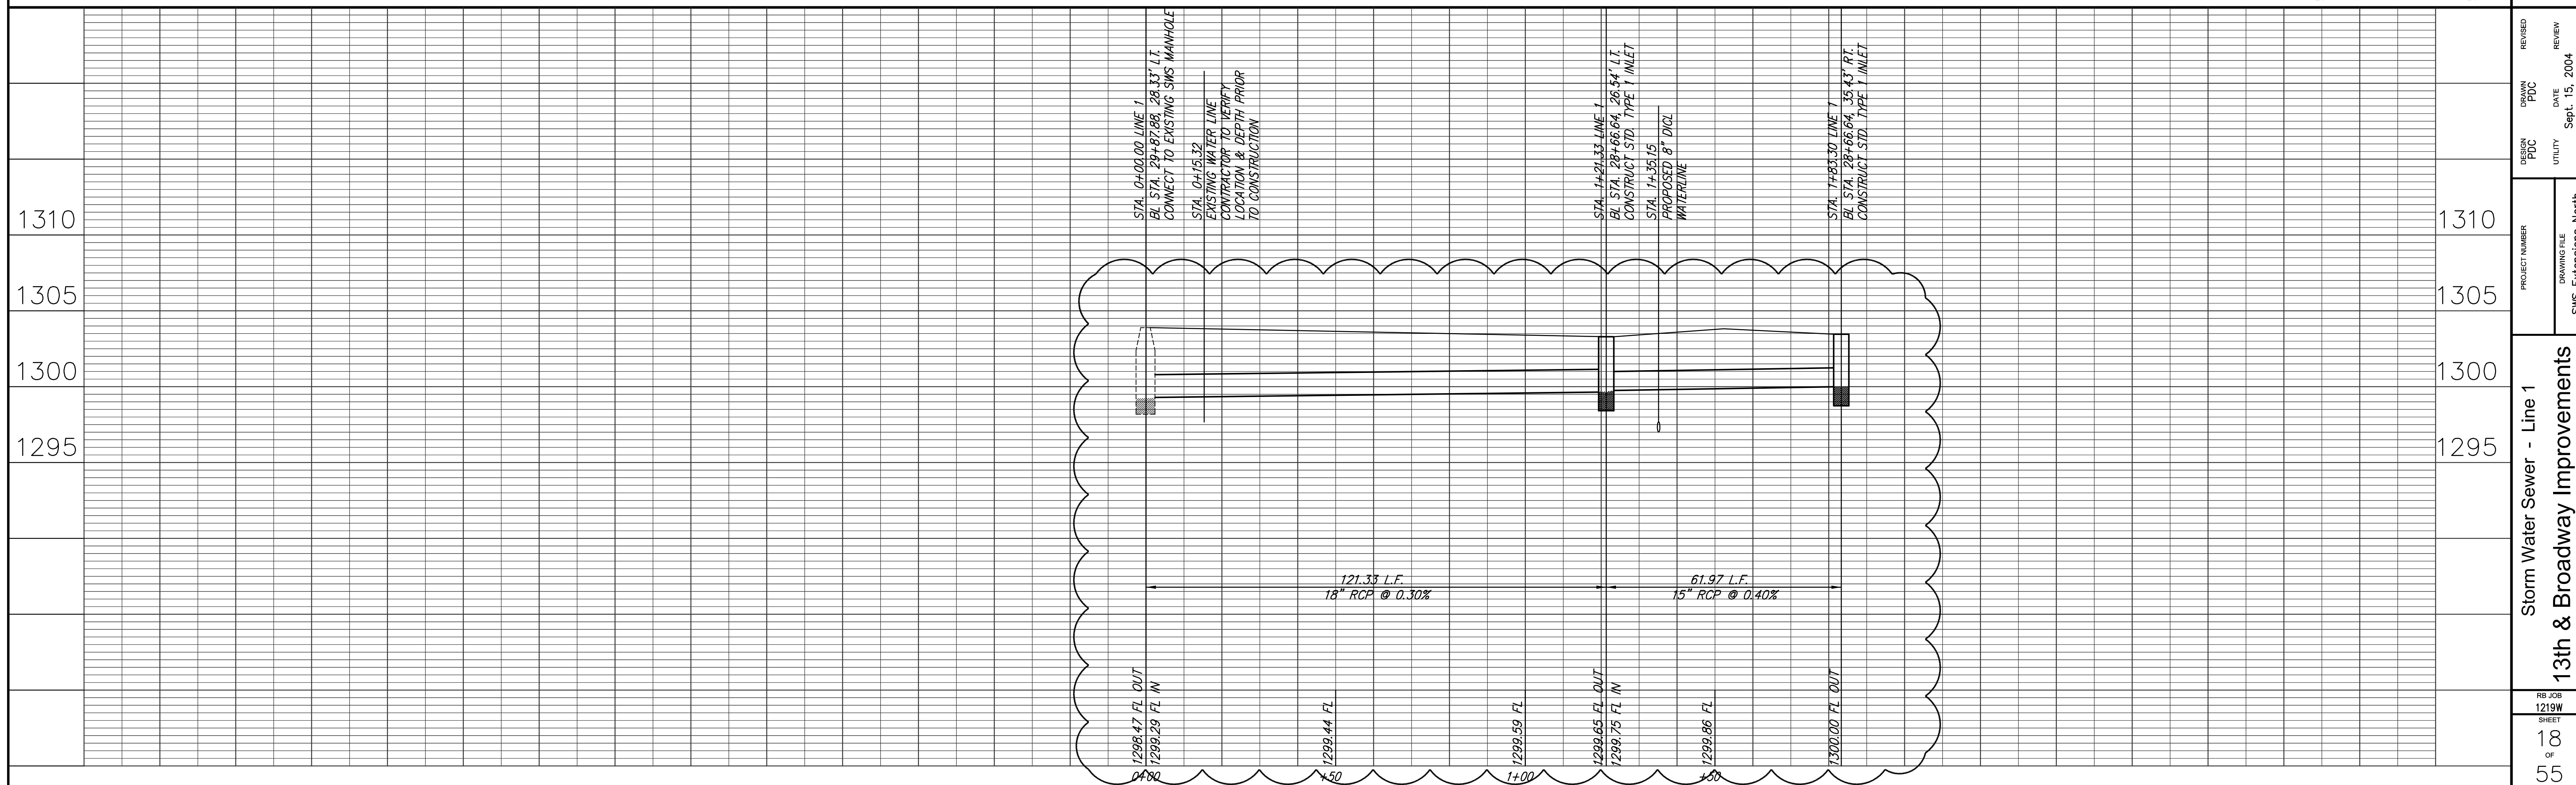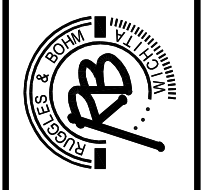

REVISION	DATE	BY	CHKD
REVIEW	Sept. 15, 2004		
UTILITY			
PDC			
DRWN			
REVISED			

PROJECT NUMBER: SWS Extensions North  
 DRAWING FILE: SWS Extensions North

Storm Water Sewer - Line 1  
 13th & Broadway Improvements

18  
 of  
 55