


NOTE: FENCE REMOVAL AND REPLACEMENT SHALL BE INCIDENTAL TO BID ITEM FOR SITE CLEARING AND RESTORATION.

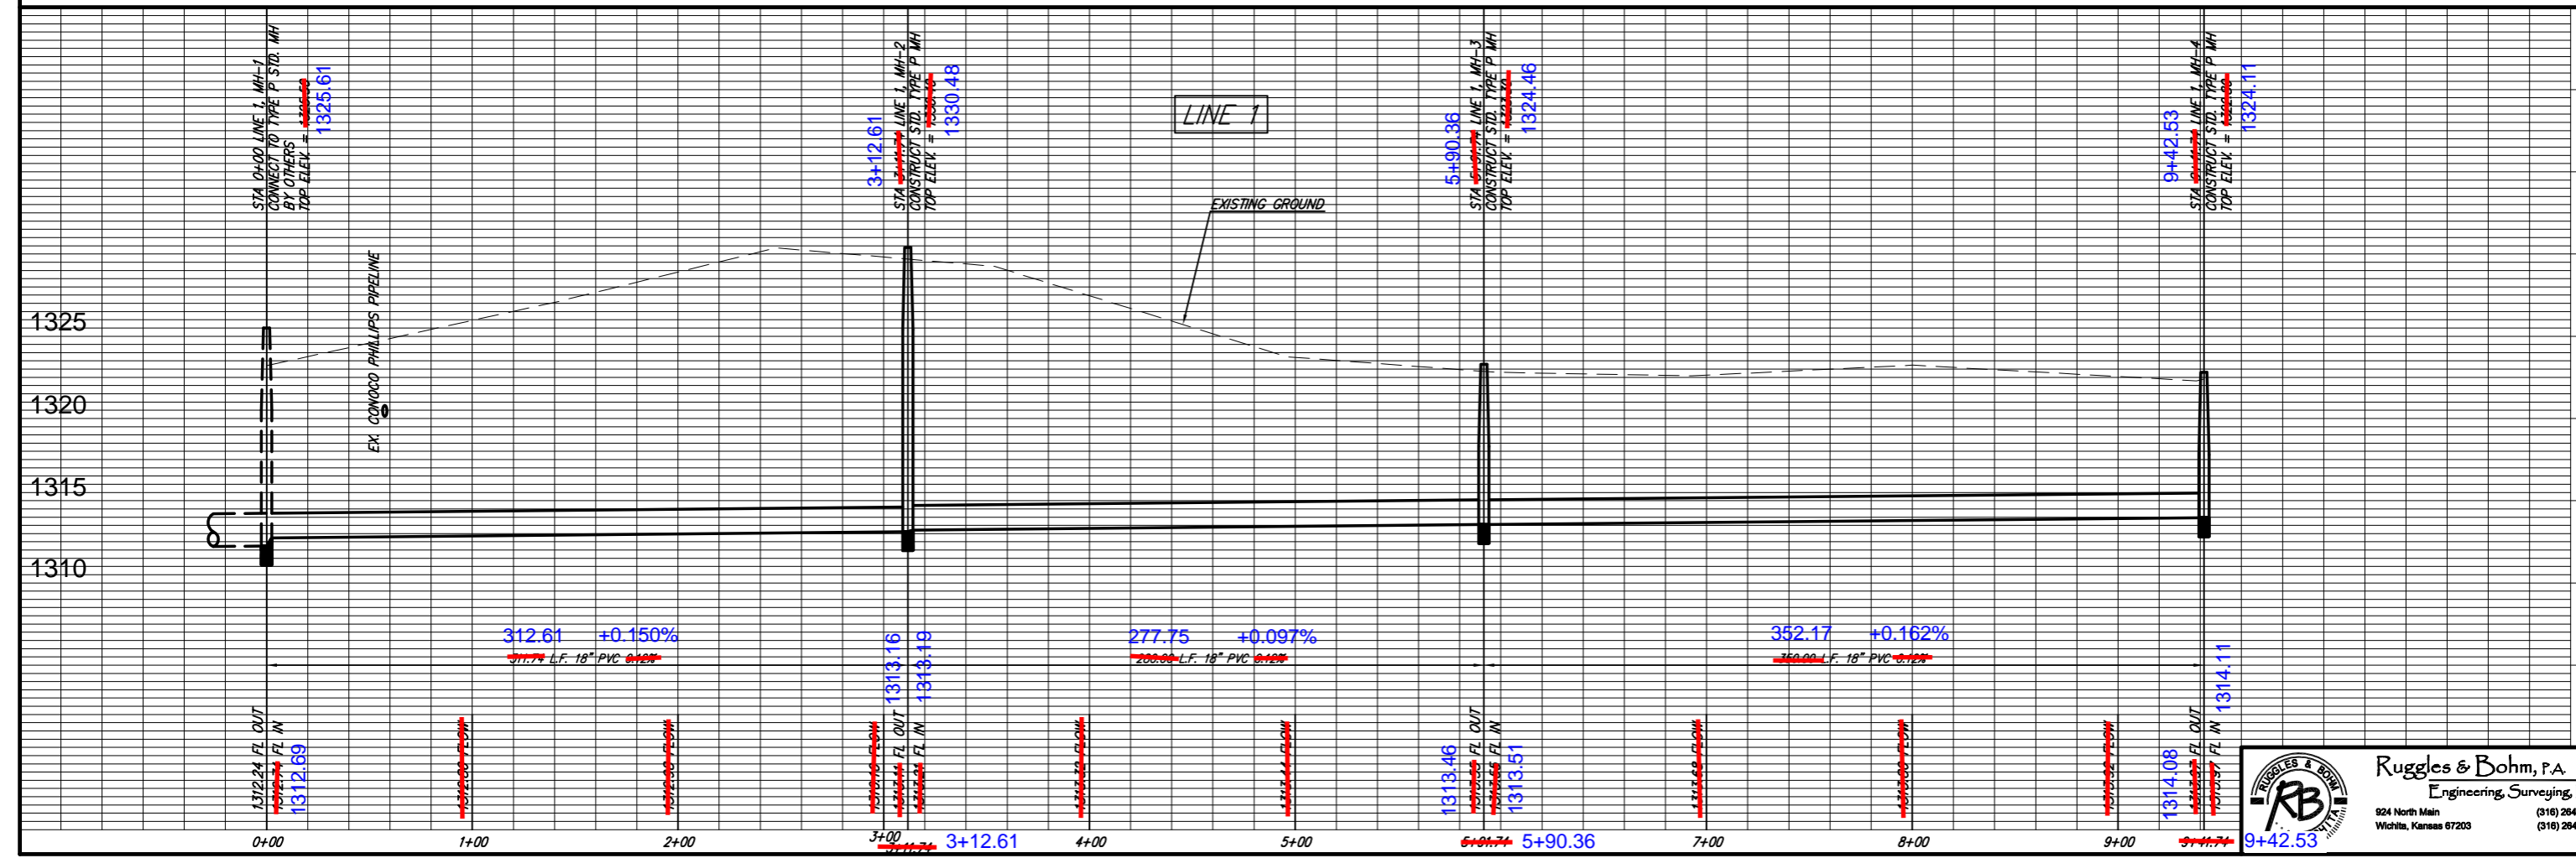

PROJECT NUMBER 468-84141	DESIGN KWL	DRAWN MLP	REVIEW MLP
DRAWING FILE Sanitary Sewer Line 1A	UTILITY	DATE Feb. 15, 2006	REVIEW
MAIN 23, SOUTHWEST INTECEPTOR Gravity Sewer Main		1325 1320 1315 1310	
Ruggles & Bohm, P.A. Engineering, Surveying, Land Planning 924 North Main Wichita, Kansas 67203 (316) 264-8008 (316) 264-4821 fax		RB JOB 2822E SHE 2 OF 16	