


SCALE 1" = 40'  
IRON = ●

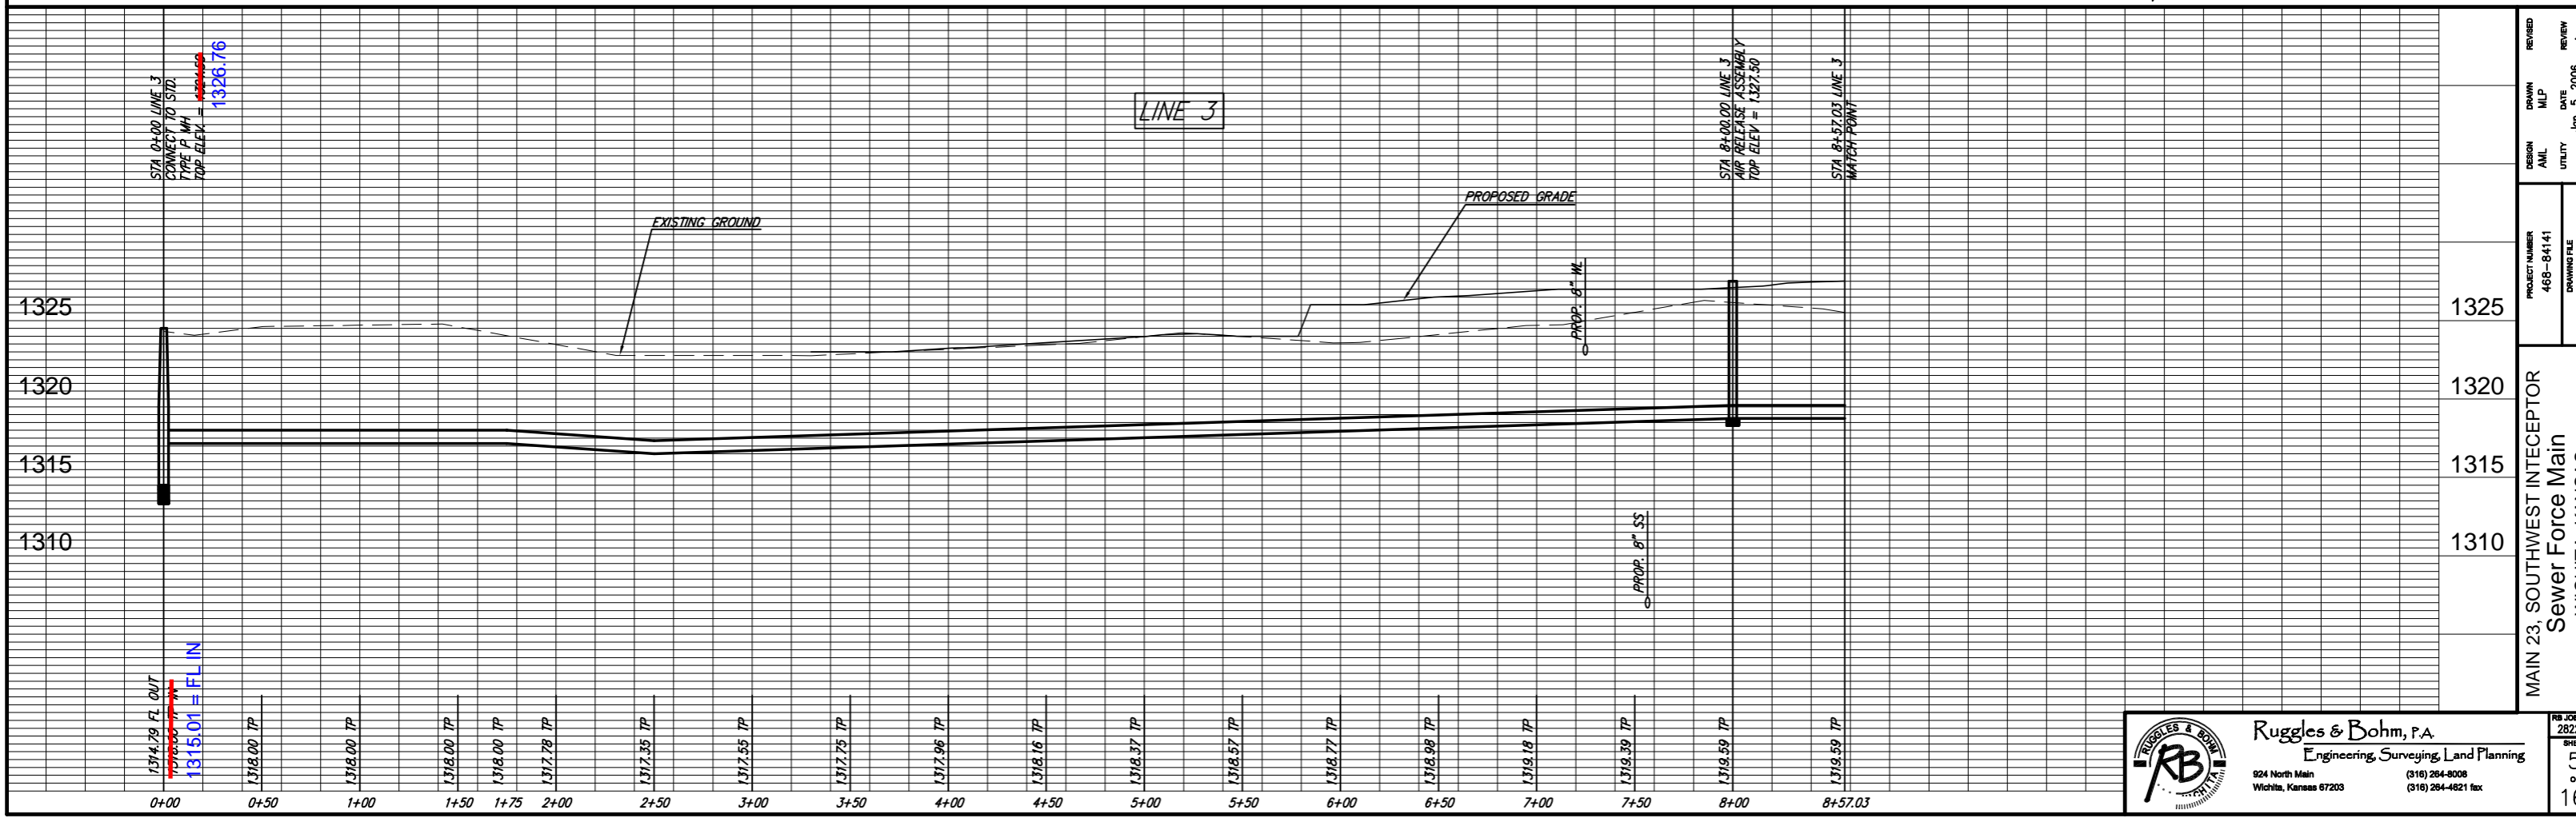

REVISION	DATE	BY
REVIEW	Jan. 3, 2006	MLP
DESIGN	UTILITY	AML
PROJECT NUMBER	468-84141	
DRAWING FILE	Sanitary Sewer (SS 04)	
MAIN 23, SOUTHWEST INTECEPTOR Sewer Force Main		

**Ruggles & Bohm, P.A.**  
Engineering, Surveying, Land Planning  
924 North Main  
Wichita, Kansas 67203  
(316) 264-8008  
(316) 264-4821 fax

RB JOB 2822E  
SHE 5  
16