




Benchmark:
 City of Wichita Benchmark Disc,
 Hydraulic and 55th Street South,
 42.00' North of Centerline, 40.70'
 West of Centerline, 3.70' North of
 centerline of Power Pole, 58.20'
 Northwest of Southeast Corner, Sec.
 21, Twp. 28-S, R-1-E.
 Elev. = 76.19 City Datum
 Elev. = 1263.59 (NGVD29)

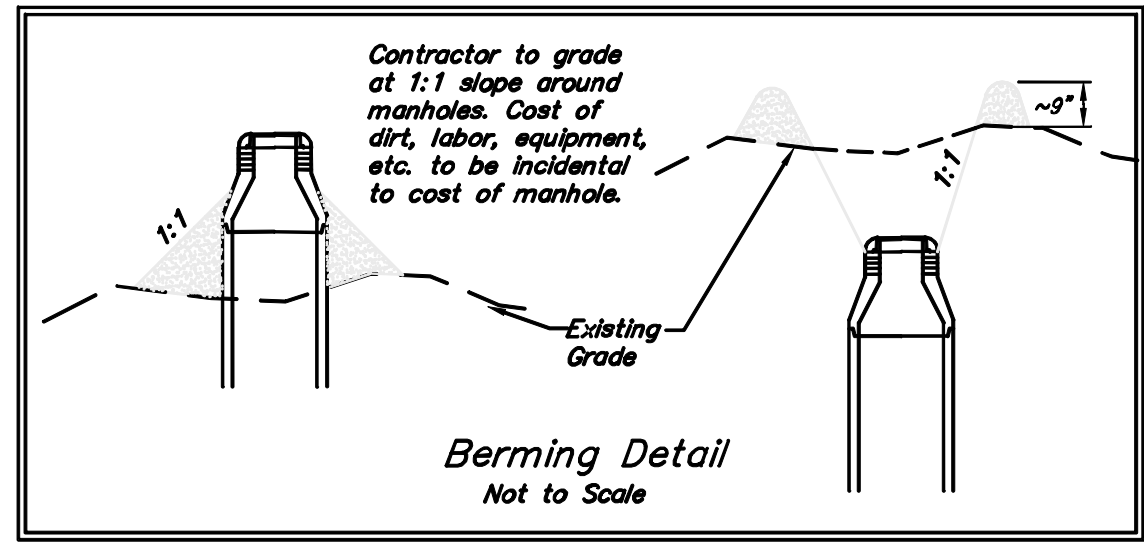

Scale:
 1" = 40' Horizontal
 1" = 5' Vertical
 • = Iron

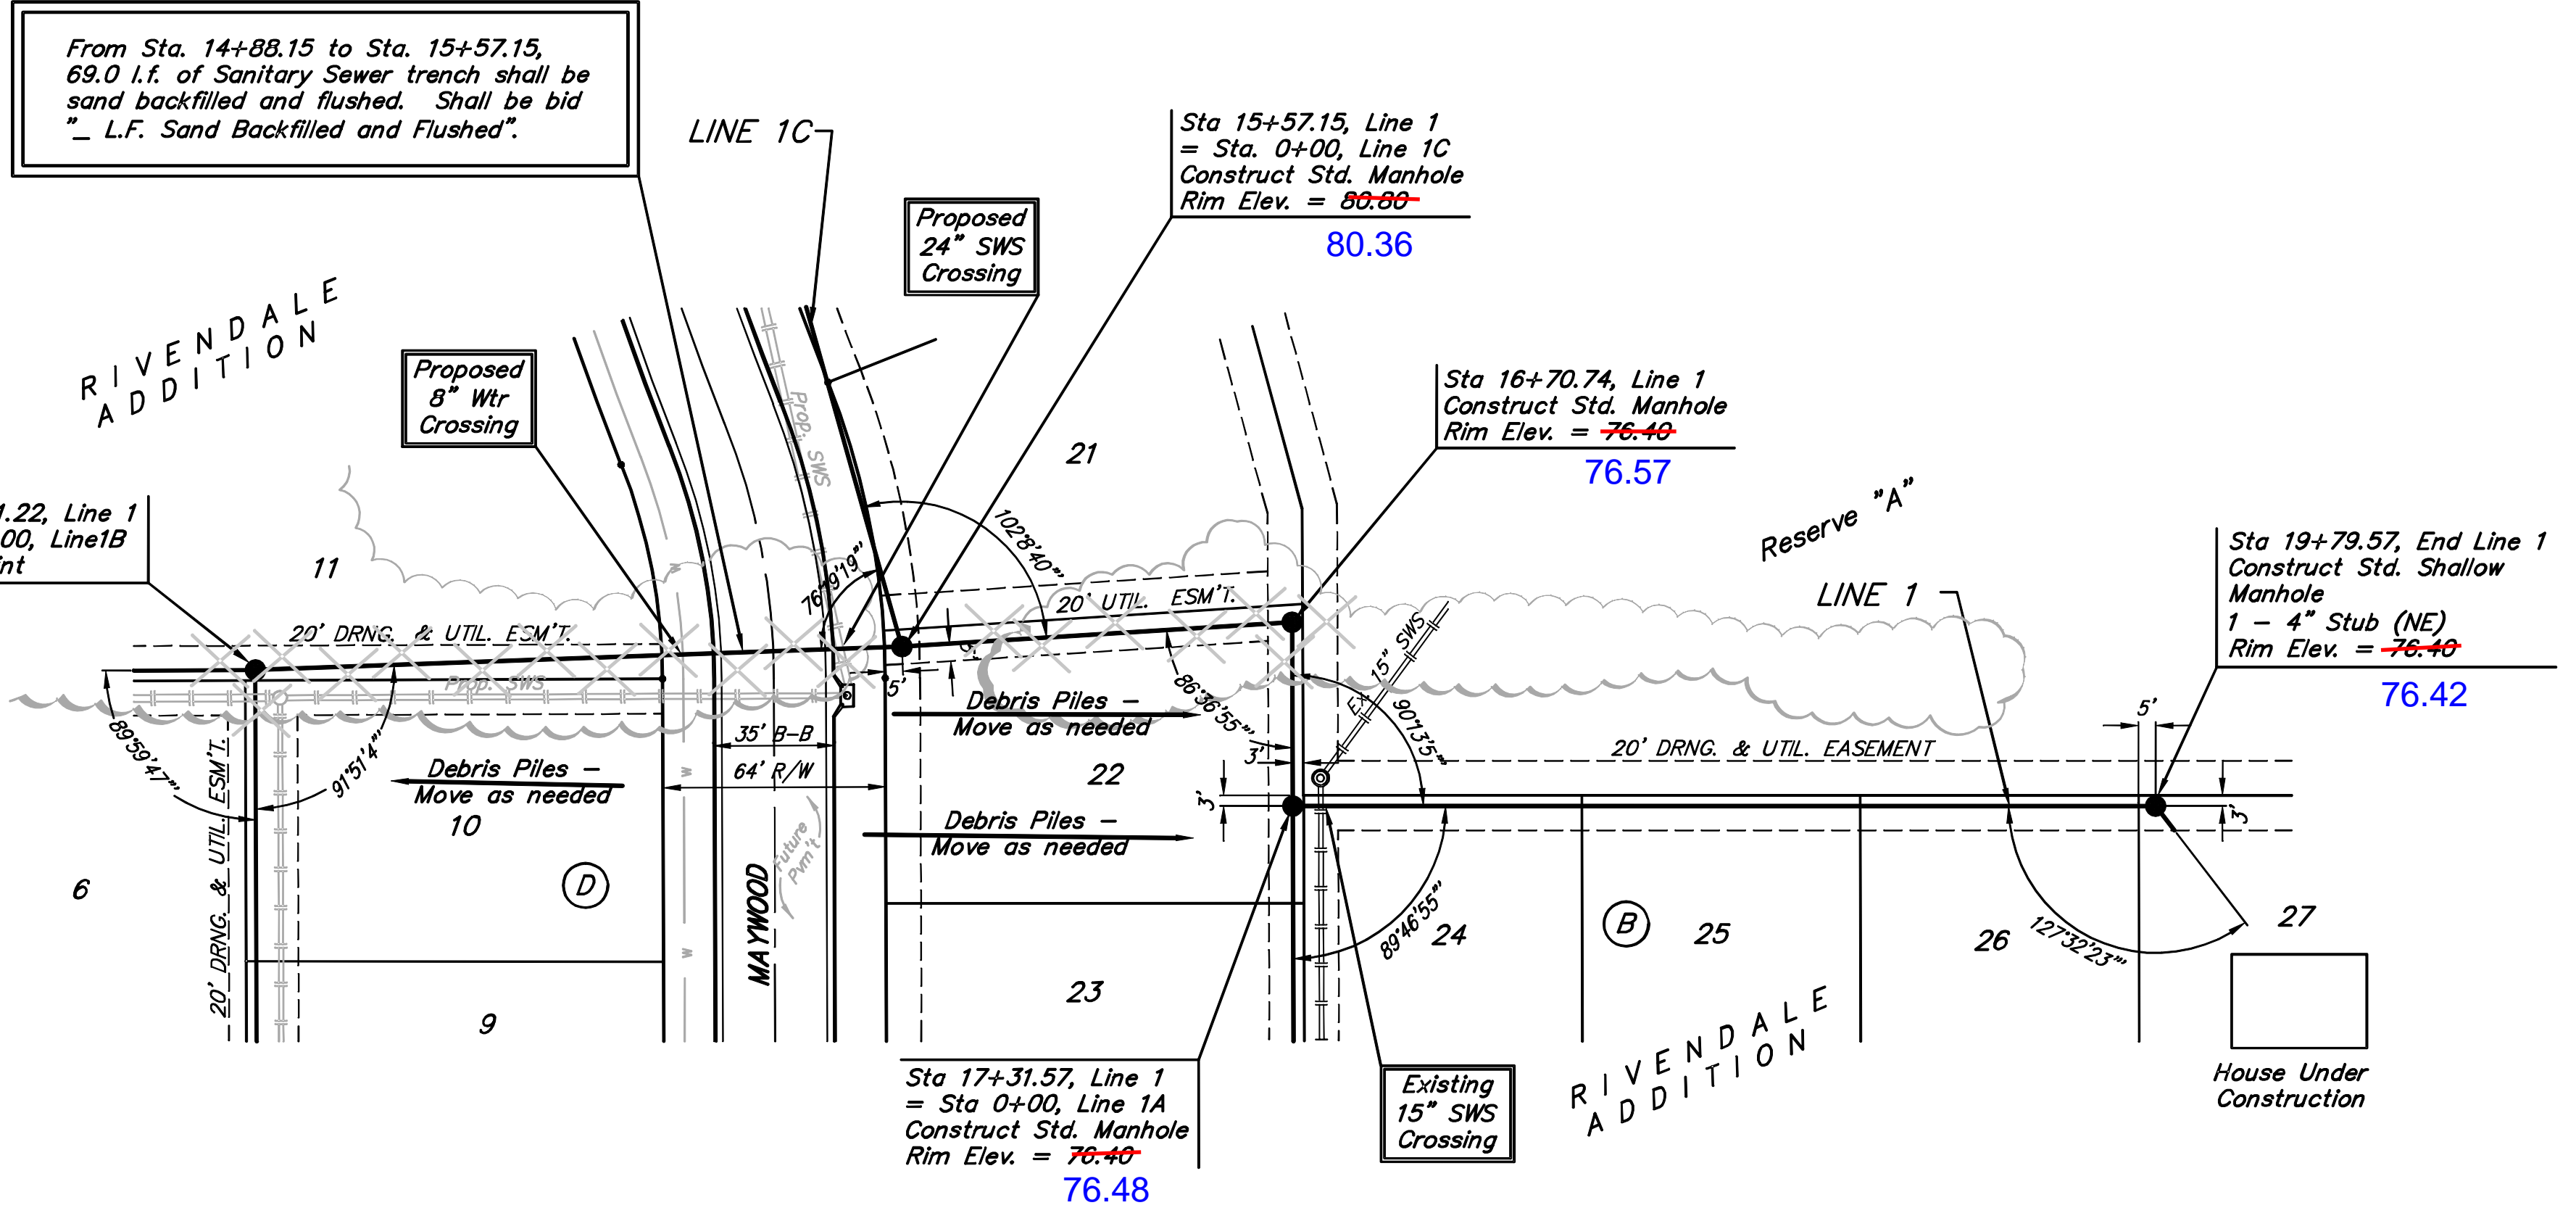

⊗ Denotes Trees to be
 Trimmed or Removed by
 the Sanitary Sewer Contractor

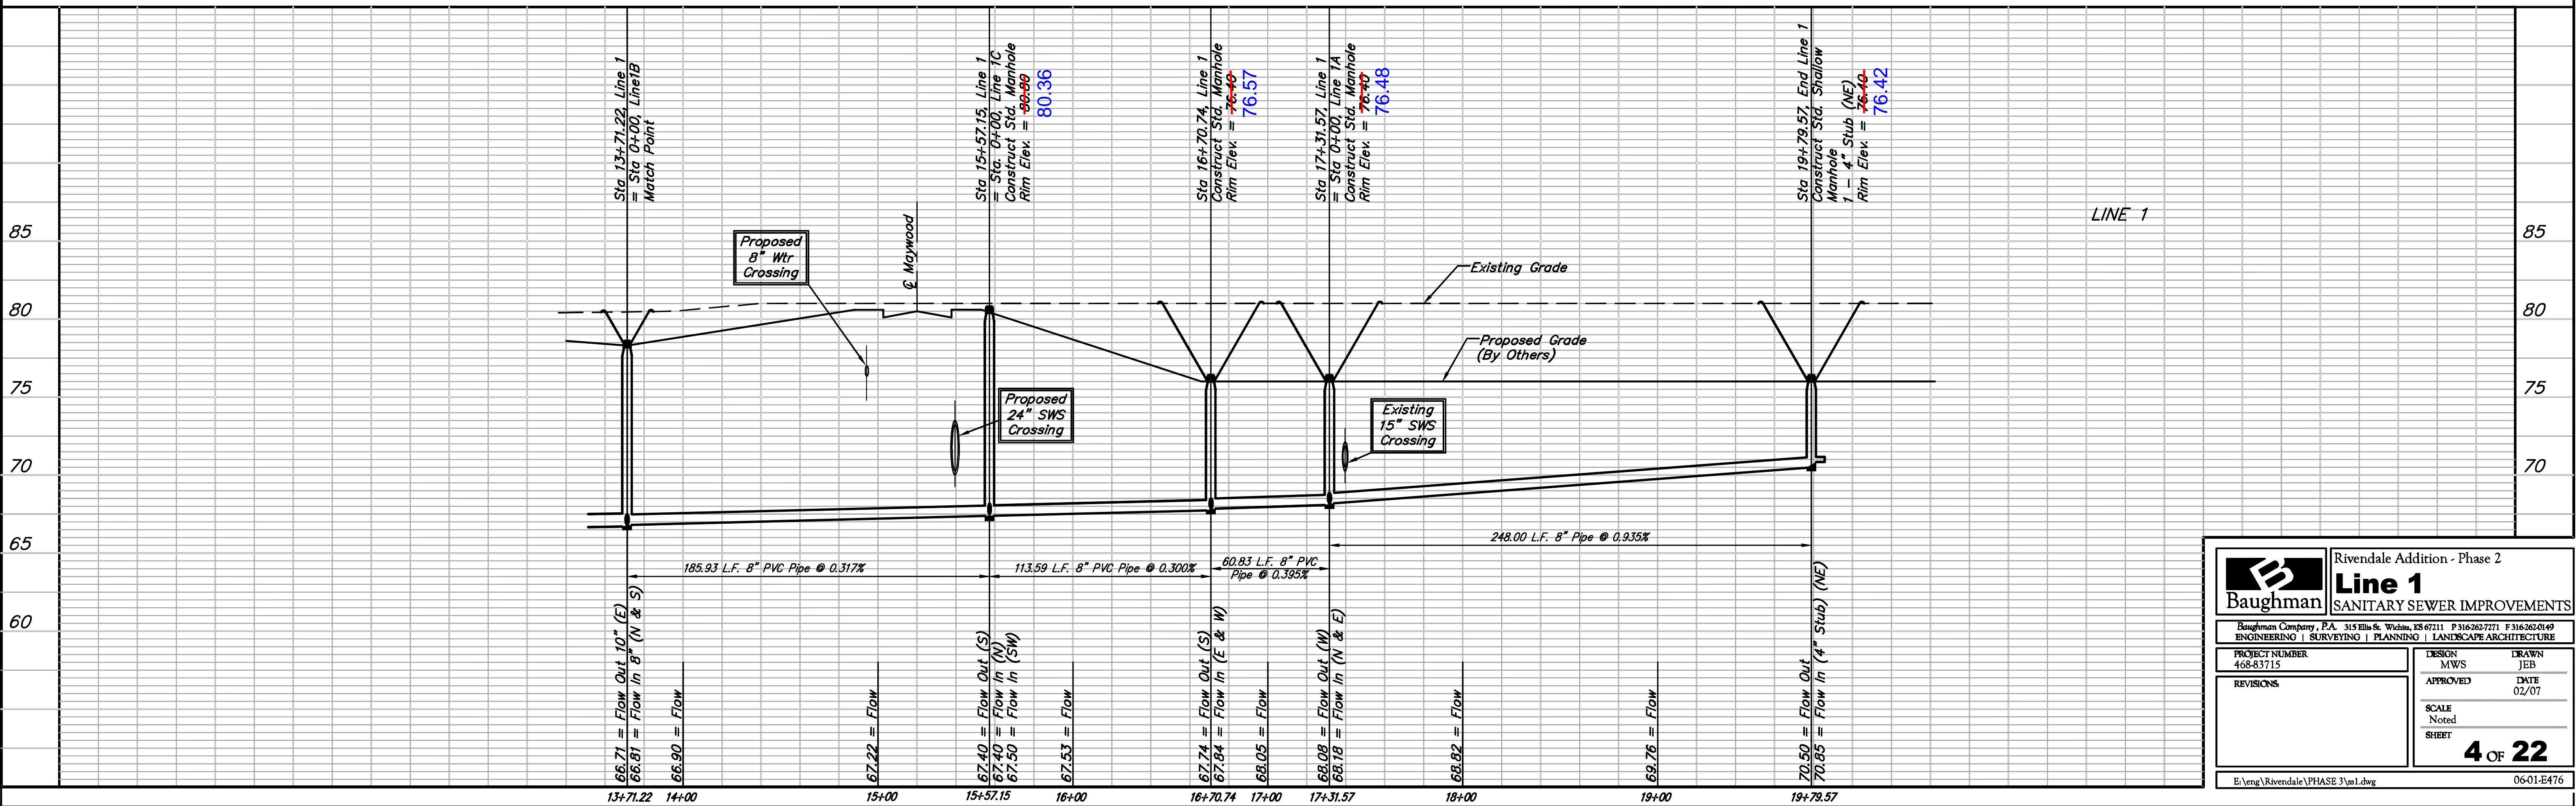

Baughman		Rivendale Addition - Phase 2	
		Line 1	
		SANITARY SEWER IMPROVEMENTS	
Baughman Company, P.A. 315 Ellis St. Wichita, KS 67211 P 316-262-7271 F 316-262-0149 ENGINEERING SURVEYING PLANNING LANDSCAPE ARCHITECTURE			
PROJECT NUMBER 468-83715	DESIGN MWS	DRAWN JEB	DATE 02/07
REVISIONS	APPROVED	SCALE Noted	SHEET
			4 OF 22
E:\eng\Rivendale\PHASE 3\ss1.dwg			06-01-E476