

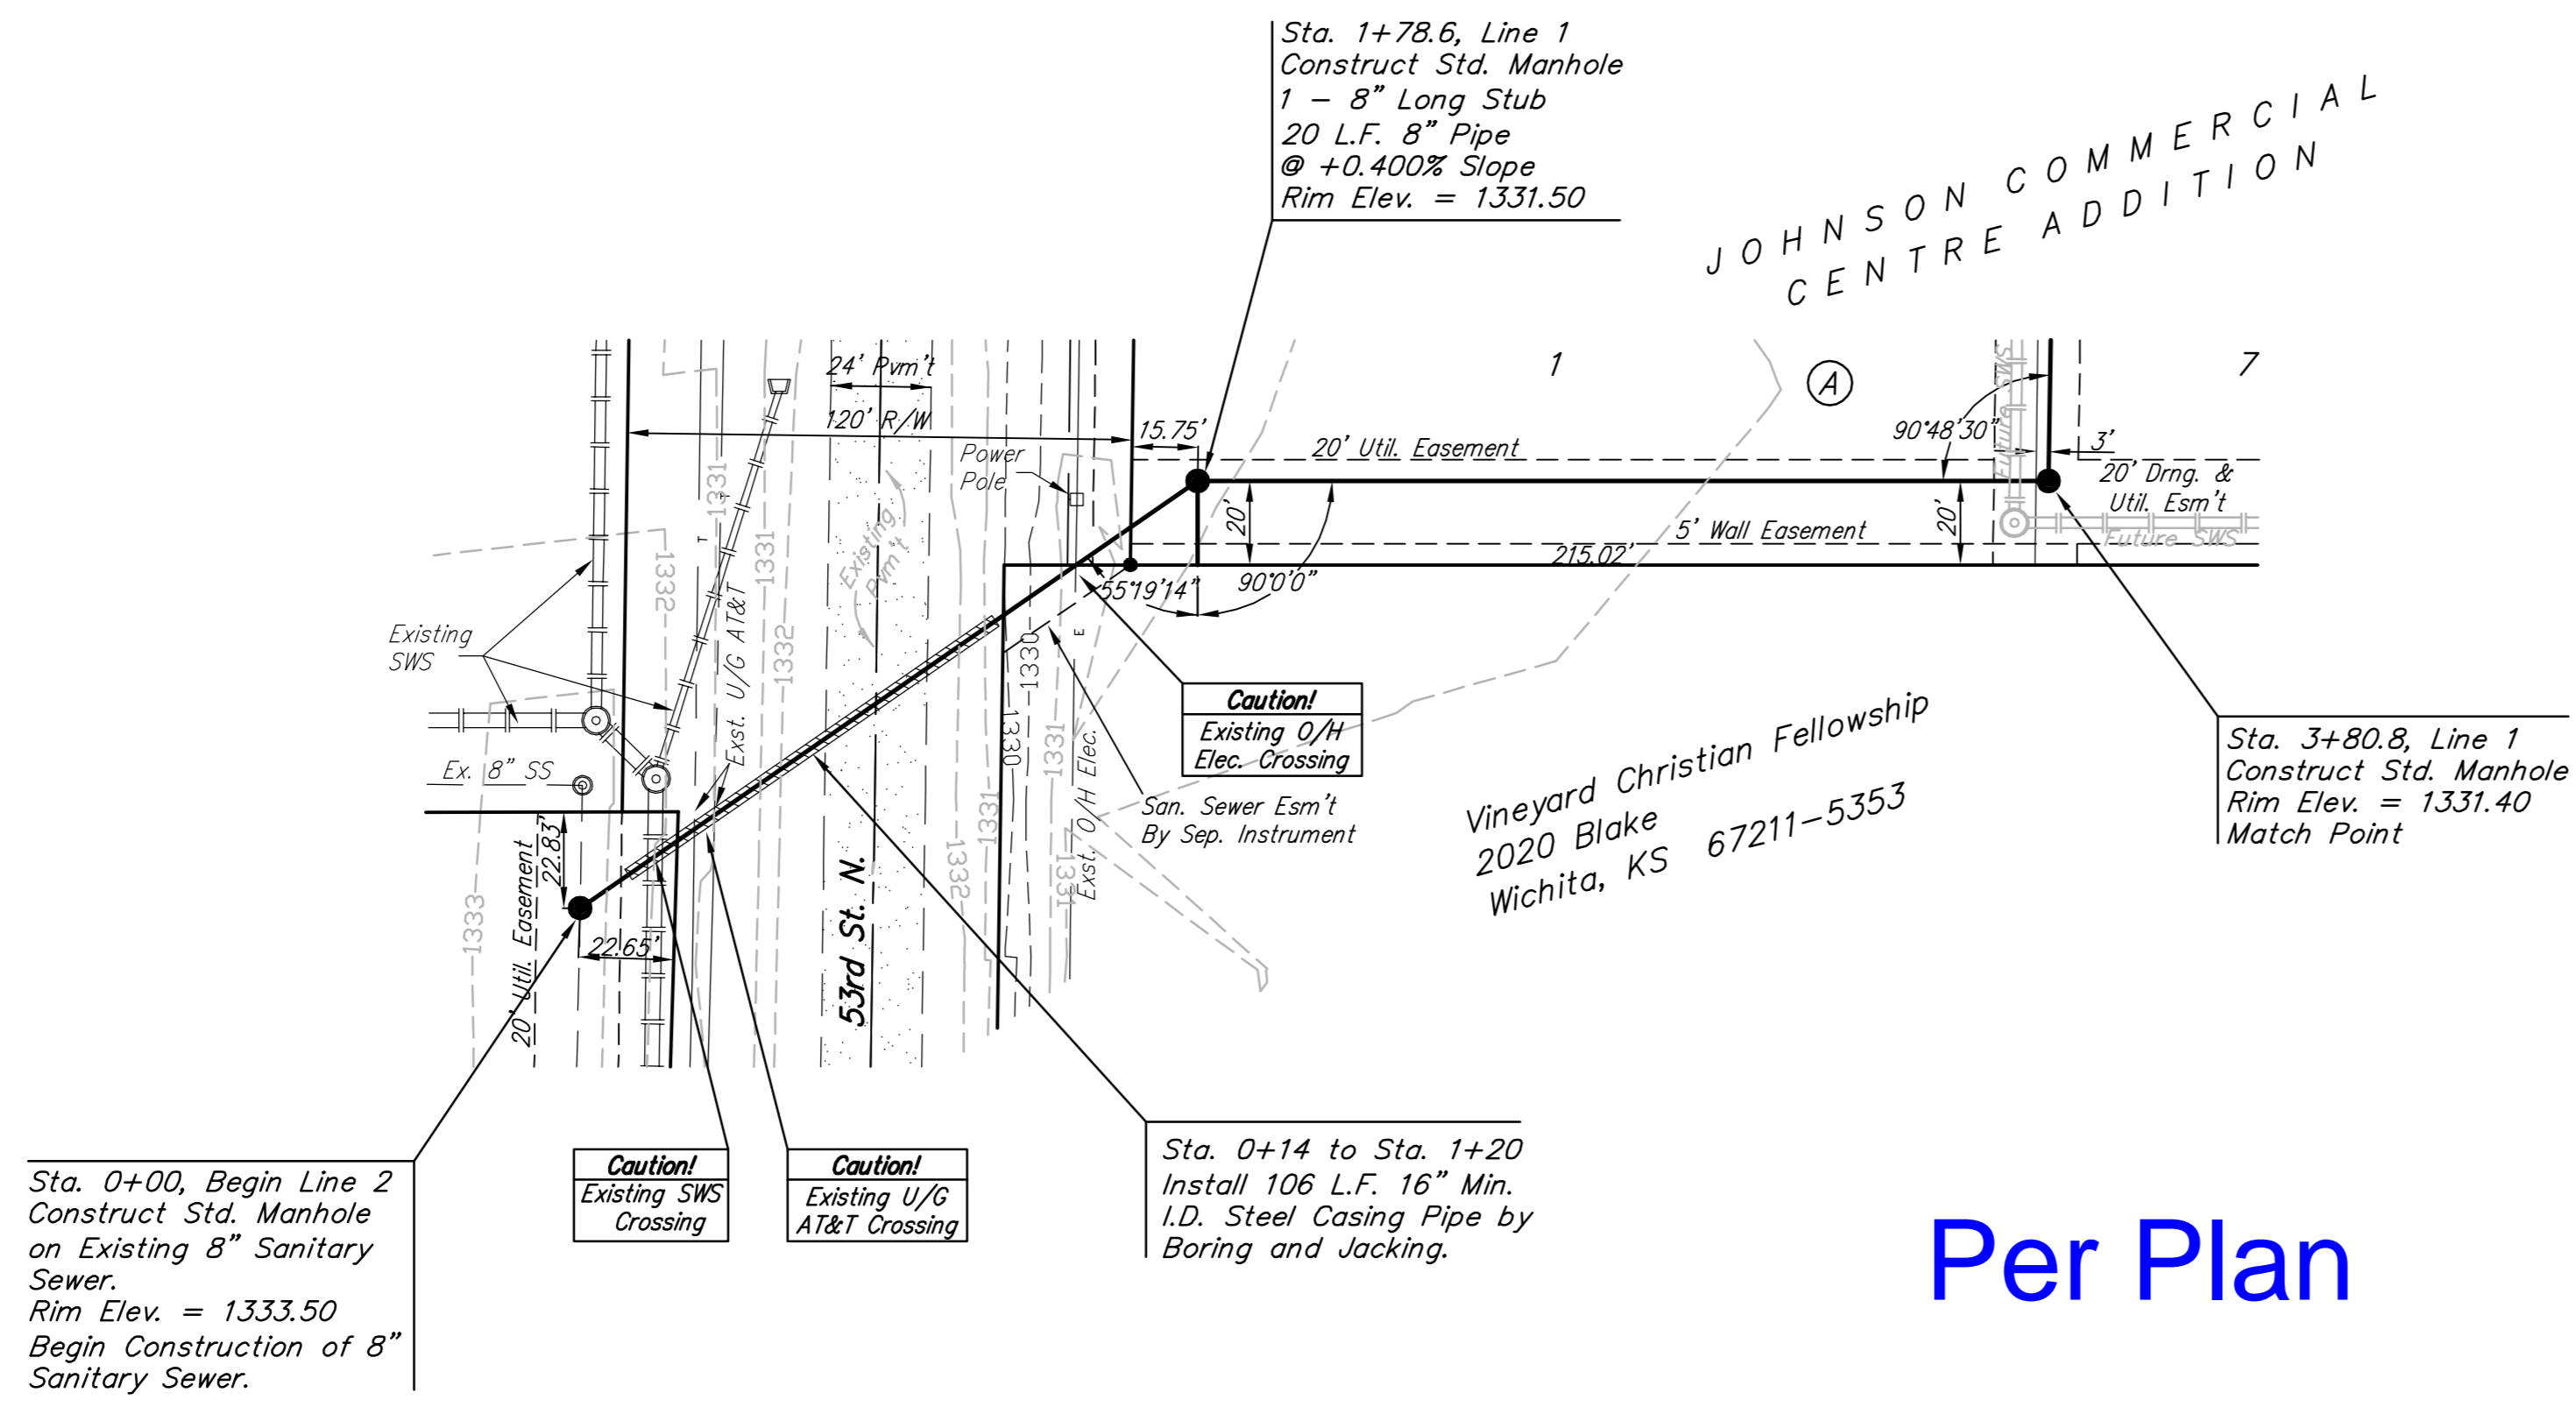


BENCHMARK:
 COW Benchmark at the Intersection of
 Meridian and 53rd St. N., NE Corner,
 Top of Concrete Headwall
 44' North of Centerline
 37' East of Centerline
 50.90' NE of Section Corner
 9' NE of and Radial to Curb
 26' East of Section Line
 Elev. = 1331.37 NGVD29

Scale: 1" = 40' Horizontal
 1" = 5' Vertical
 ● = Iron

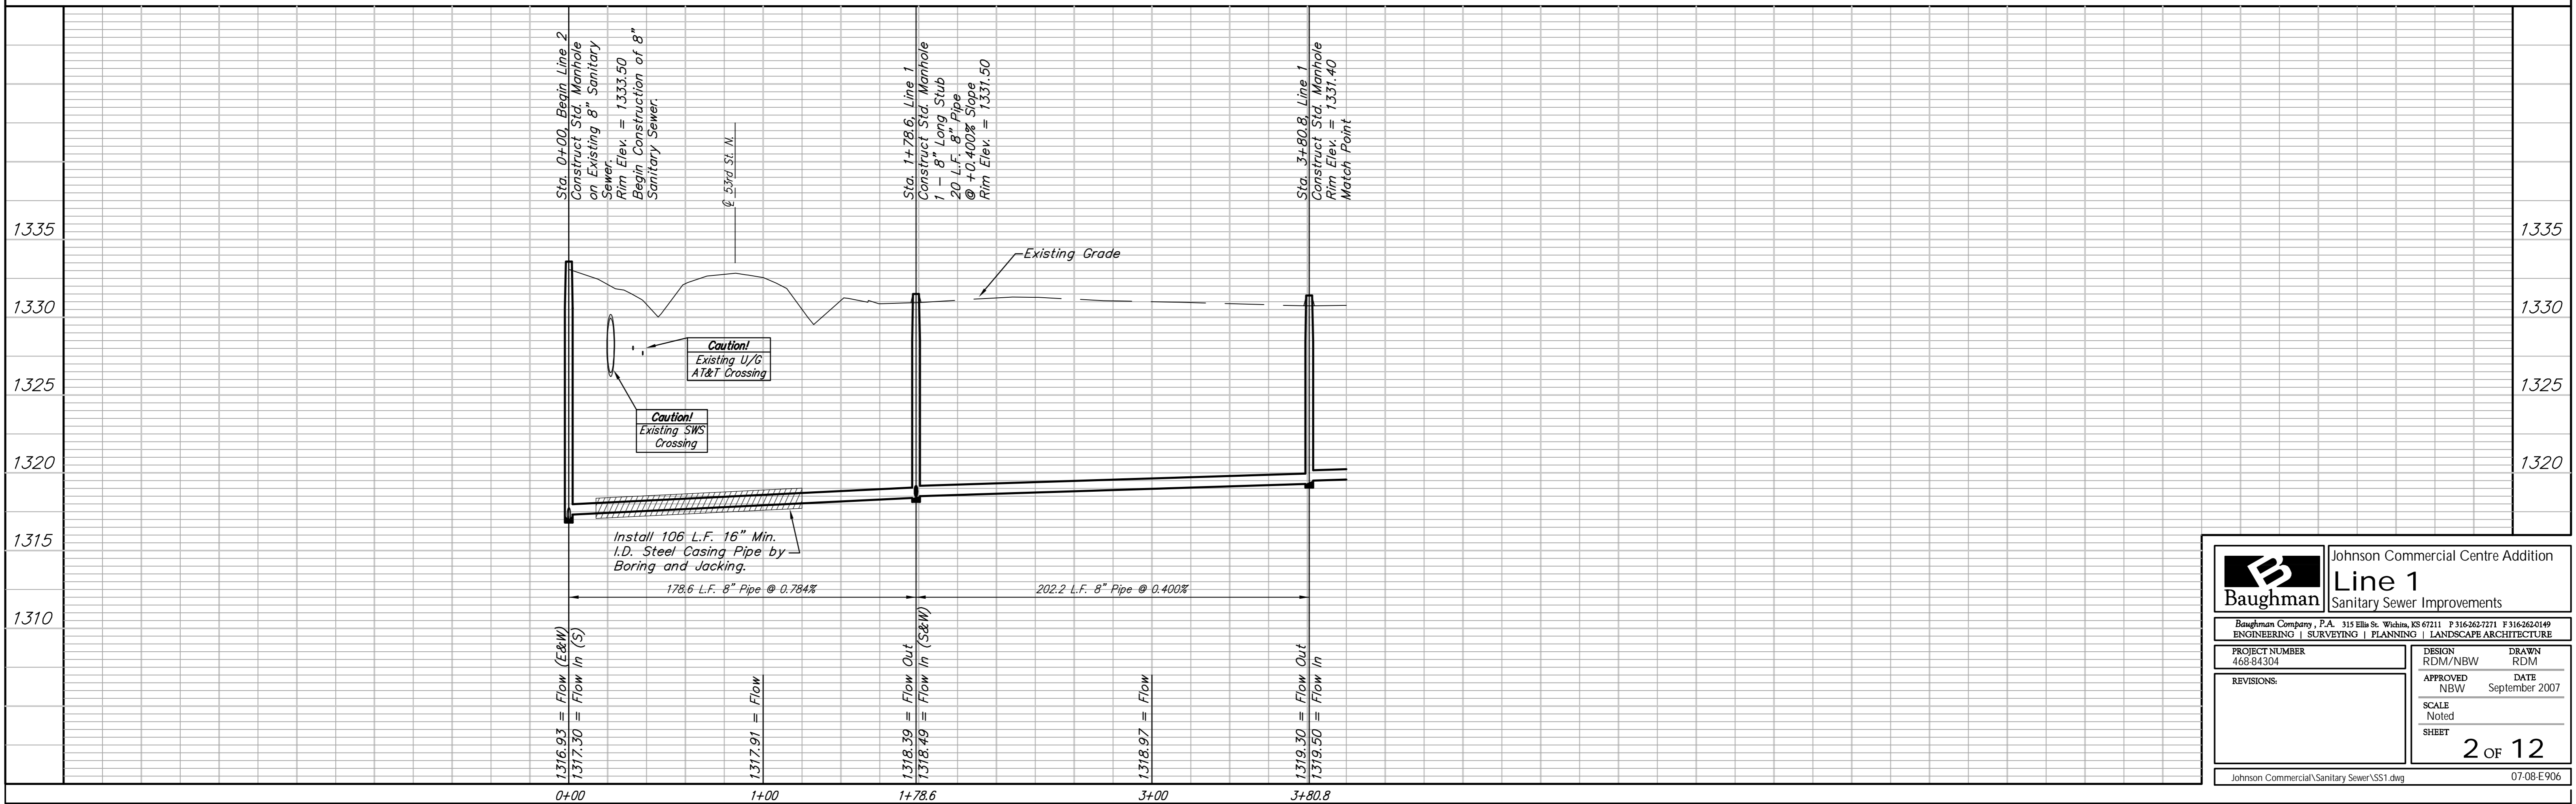

Per Plan

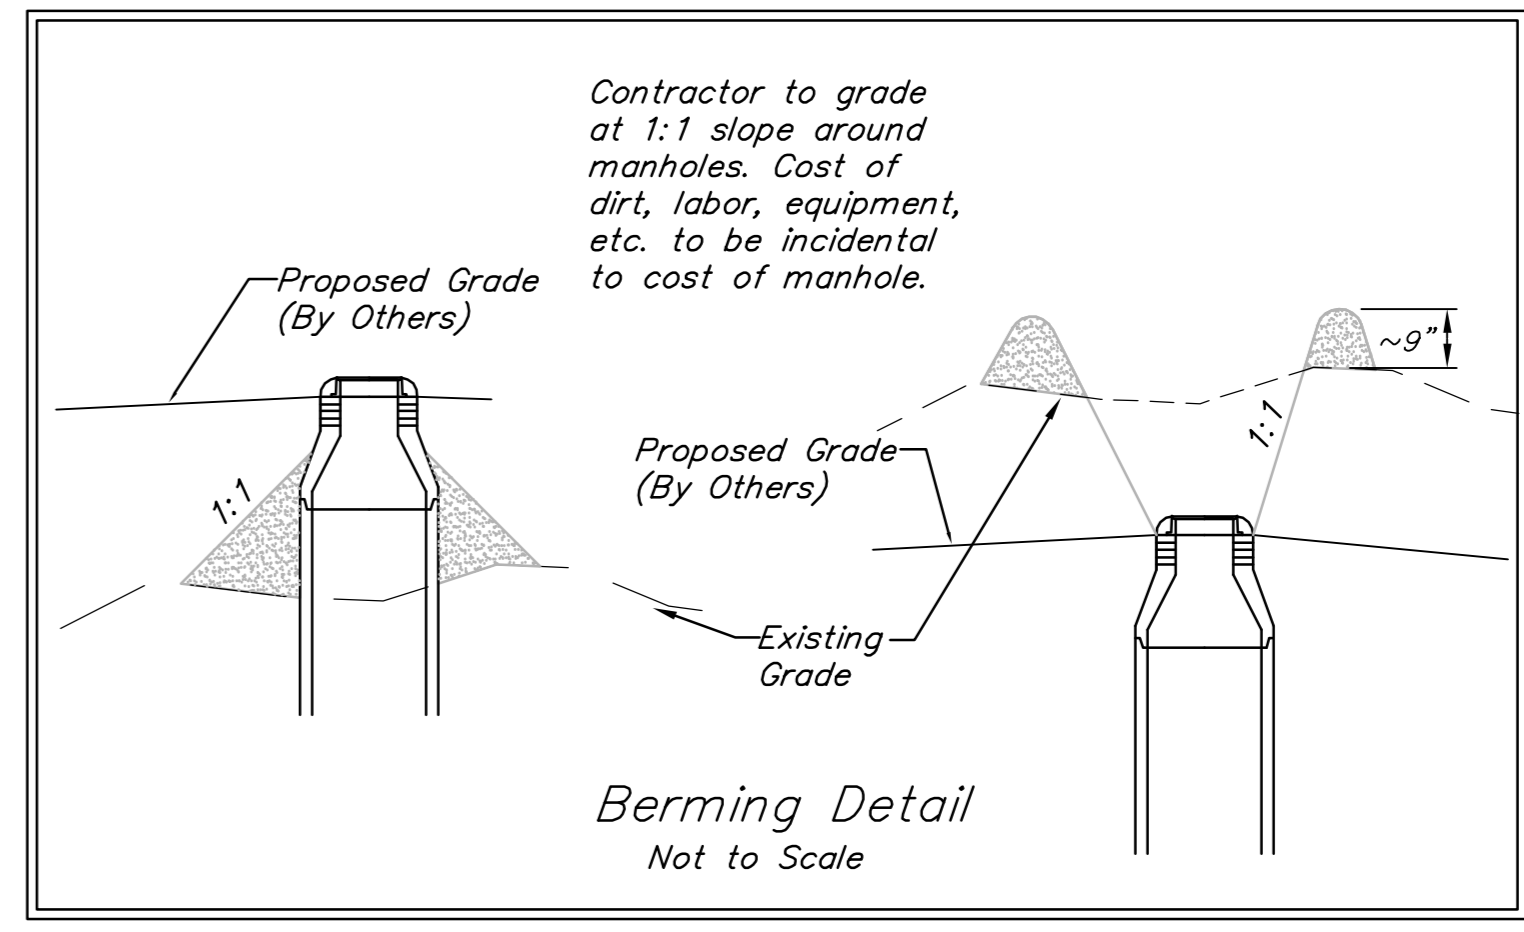

Baughman		Johnson Commercial Centre Addition	
Line 1		Sanitary Sewer Improvements	
Baughman Company, P.A. 315 Ellis St. Wichita, KS 67211 P 316-262-7271 F 316-262-0149 ENGINEERING SURVEYING PLANNING LANDSCAPE ARCHITECTURE			
PROJECT NUMBER 468-84304	DESIGN RDM/NBW	DRAWN RDM	DATE September 2007
REVISIONS:	APPROVED NBW	SCALE Noted	SHEET 2 of 12
Johnson Commercial\Sanitary Sewer\SS1.dwg			07-08-E906