SCALE:

PLAN: LAT. & LONG. 0 40 80

PROFILE: HORIZ. SAME AS ABOVE

VERT. 0 5

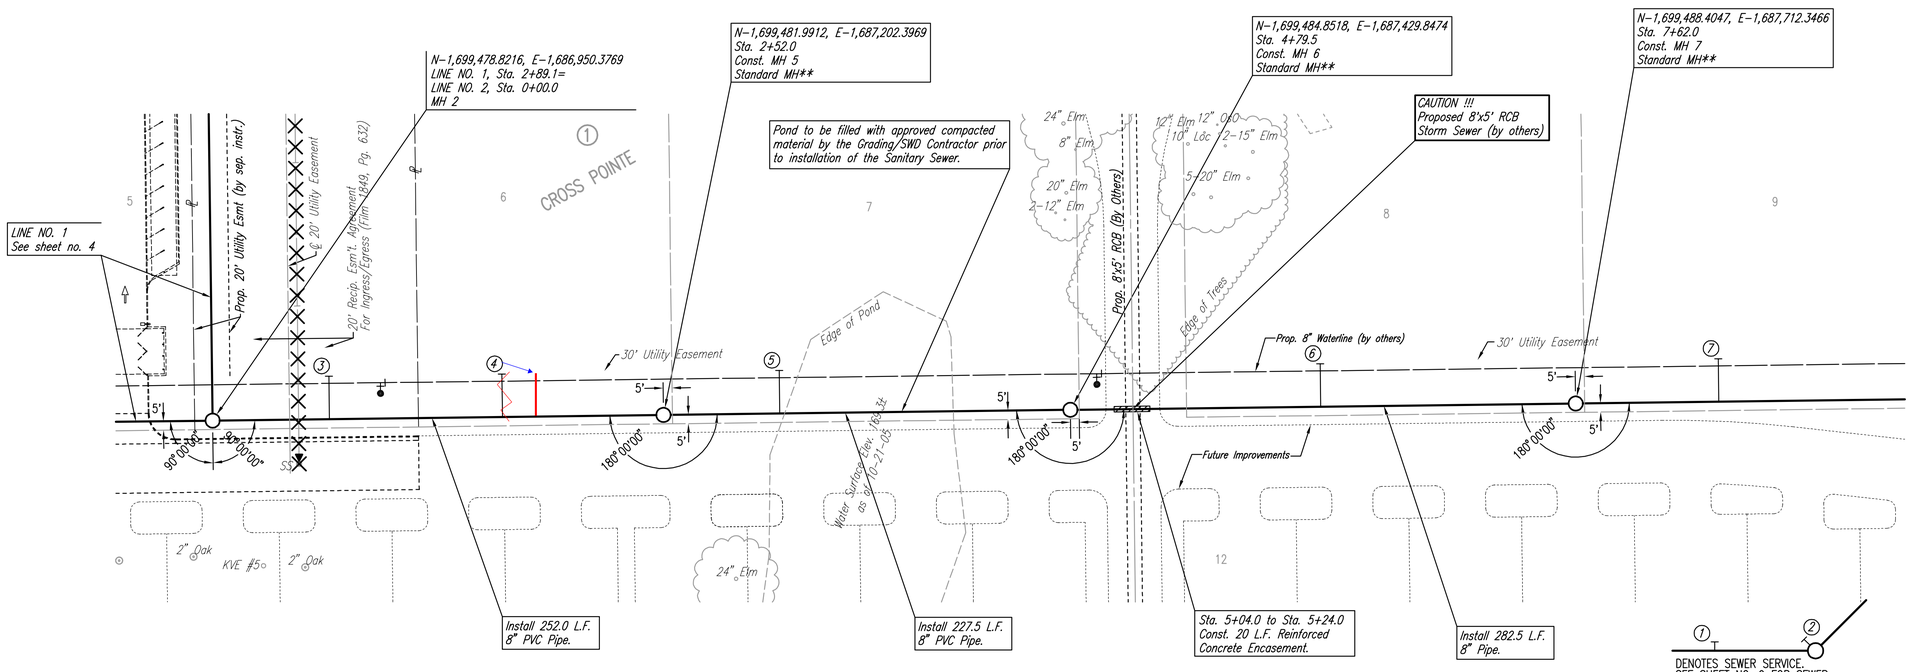

** MH TO INCLUDE 1-6" ADJUSTMENT RING CONTRACTOR TO CONFIRM MH RIM ELEVATIONS PRIOR TO CONSTRUCTION. CONTACT THE DESIGN ENGINEER, MR. MIKE KELSEY, AT 262-2691.

SANITARY SEWER LINE NO. 2

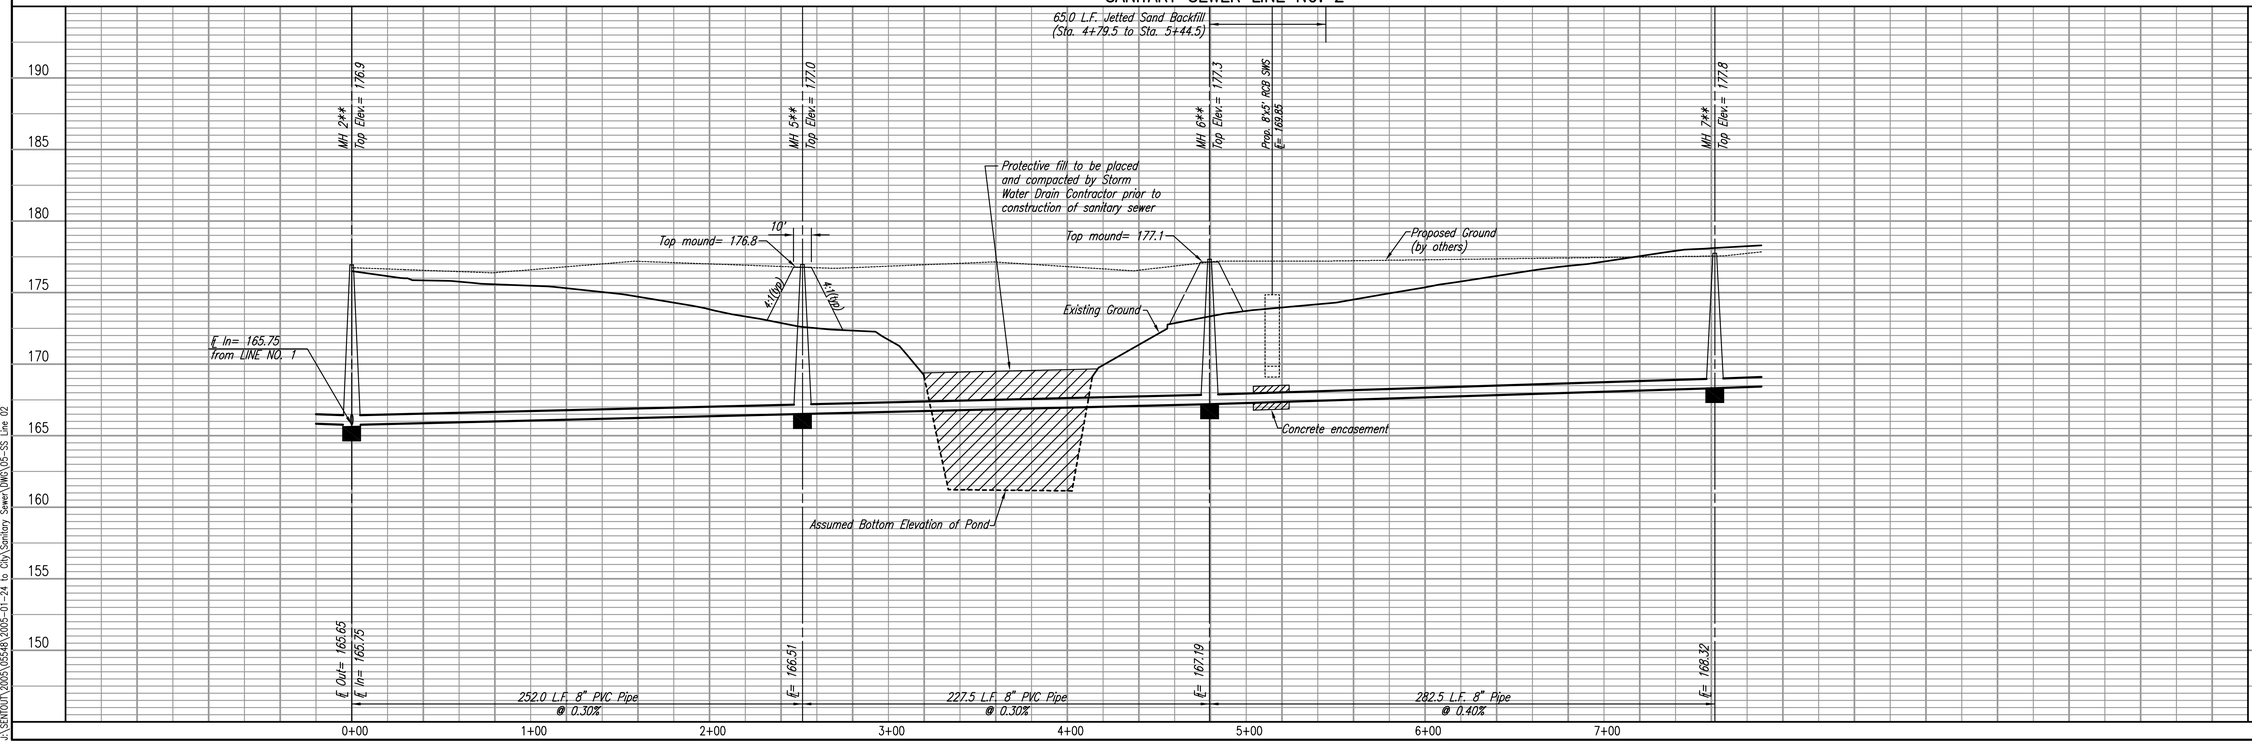

LATERAL 5, MAIN 16
FOUR MILE CREEK SEWER

SANITARY SEWER LINE NO. 2

JAMES L. ARMOUR, P.E. - CITY ENGINEER
CITY OF WICHITA PROJECT NO. 468-84044

Professional Engineering Consultants, P.A.
303 S. TOPEKA • WICHITA, KANSAS 67202
316-262-2691 • FAX 316-262-3003

Designed By MDK
Drawn By JGA
Job No. 35-05548-002-042
Date October 2005

Sheet 5 of 13

PLAN CHECKED CHECKED BY DATE

PROFILE CHECKED CHECKED BY DATE

Saved 01-24-2006 10:53:52 AM by JGA
Plot Scale 1:40 01-24-2006 12:46:12 PM by REJ
J:\SENTOUT\2005\05548\2005-01-24 to City\Sanitary Sewer\DWG\05-SS Line 02